



© 2018 GARVER, LLC
 THIS DOCUMENT, ALONG WITH THE IDEAS AND DESIGNS CONVEYED HEREIN, SHALL BE CONSIDERED INSTRUMENTS OF PROFESSIONAL SERVICE AND ARE PROPERTY OF GARVER, LLC. ANY USE, REPRODUCTION, OR DISTRIBUTION OF THIS DOCUMENT, ALONG WITH THE IDEAS AND DESIGN CONTAINED HEREIN, IS PROHIBITED UNLESS AUTHORIZED IN WRITING BY GARVER, LLC OR EXPLICITLY ALLOWED IN THE GOVERNING PROFESSIONAL SERVICES AGREEMENT FOR THIS WORK.

Digitally Signed 04/17/2019

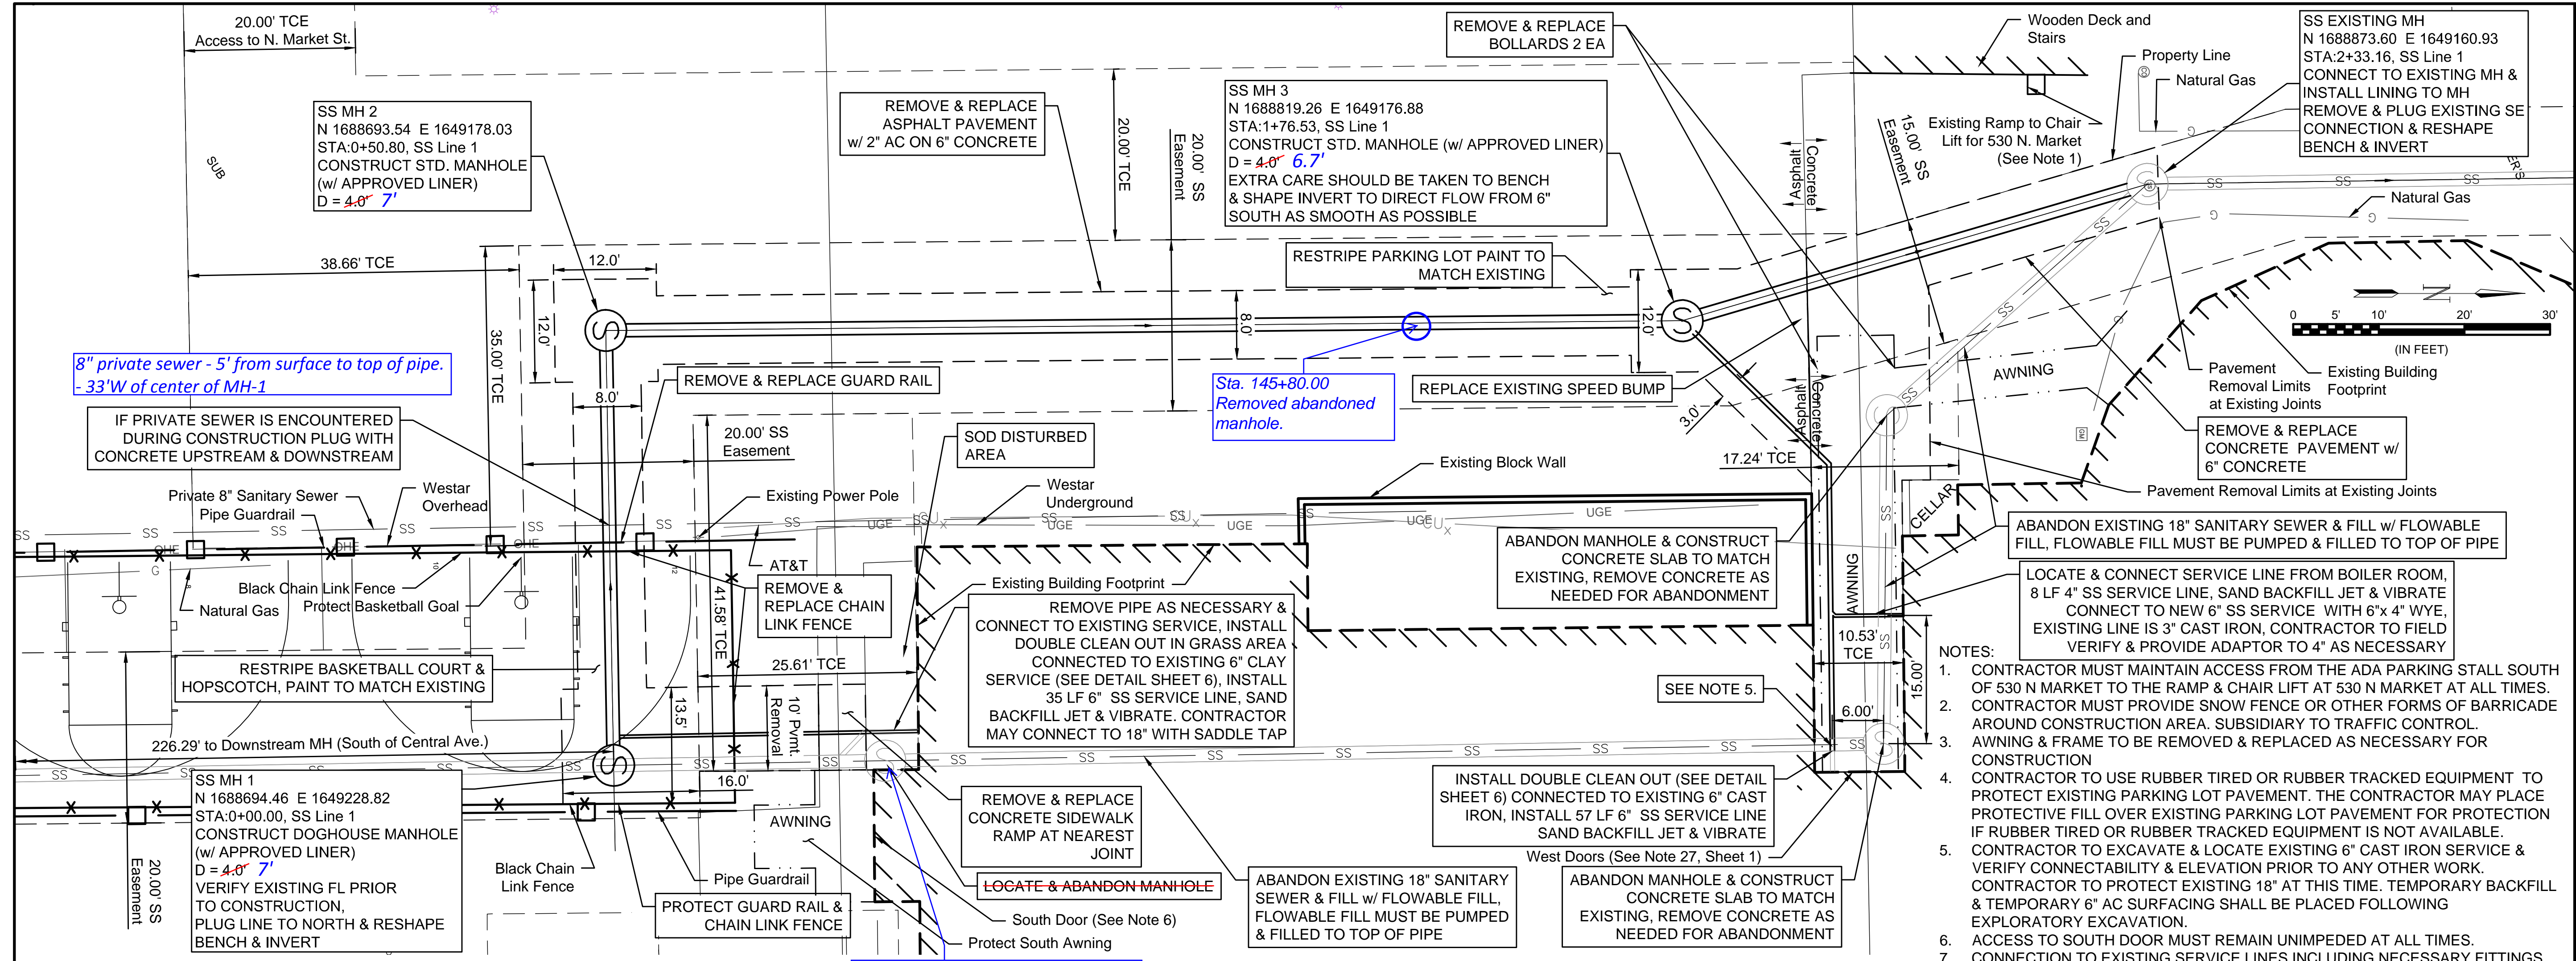

- NOTES:
- CONTRACTOR MUST MAINTAIN ACCESS FROM THE ADA PARKING STALL SOUTH OF 530 N MARKET TO THE RAMP & CHAIR LIFT AT 530 N MARKET AT ALL TIMES.
 - CONTRACTOR MUST PROVIDE SNOW FENCE OR OTHER FORMS OF BARRICADE AROUND CONSTRUCTION AREA. SUBSIDIARY TO TRAFFIC CONTROL.
 - AWNING & FRAME TO BE REMOVED & REPLACED AS NECESSARY FOR CONSTRUCTION
 - CONTRACTOR TO USE RUBBER TIRED OR RUBBER TRACKED EQUIPMENT TO PROTECT EXISTING PARKING LOT PAVEMENT. THE CONTRACTOR MAY PLACE PROTECTIVE FILL OVER EXISTING PARKING LOT PAVEMENT FOR PROTECTION IF RUBBER TIRED OR RUBBER TRACKED EQUIPMENT IS NOT AVAILABLE.
 - CONTRACTOR TO EXCAVATE & LOCATE EXISTING 6" CAST IRON SERVICE & VERIFY CONNECTABILITY & ELEVATION PRIOR TO ANY OTHER WORK. CONTRACTOR TO PROTECT EXISTING 18" AT THIS TIME. TEMPORARY BACKFILL & TEMPORARY 6" AC SURFACING SHALL BE PLACED FOLLOWING EXPLORATORY EXCAVATION.
 - ACCESS TO SOUTH DOOR MUST REMAIN UNIMPEDED AT ALL TIMES. CONNECTION TO EXISTING SERVICE LINES INCLUDING NECESSARY FITTINGS ARE SUBSIDIARY TO THE SERVICE LINE
 -

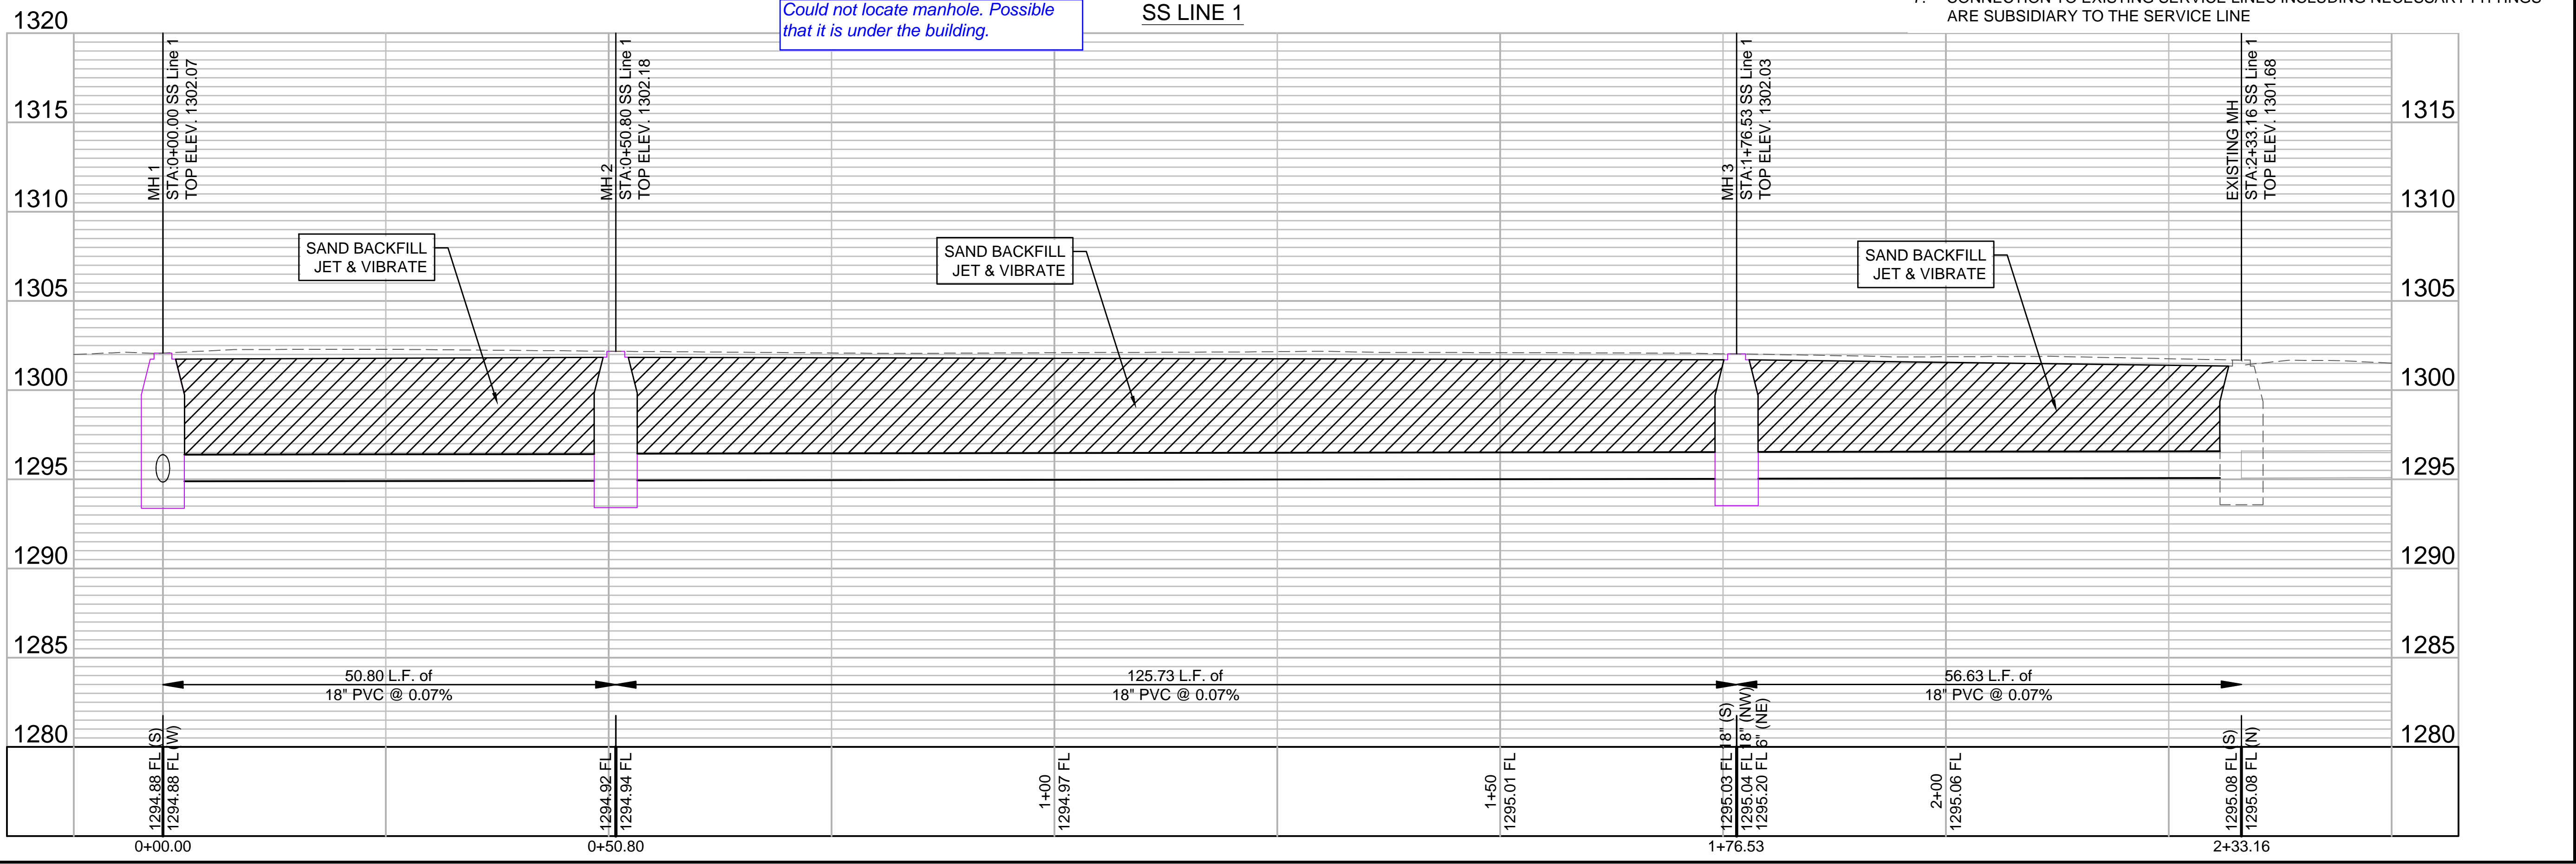

File: L:\2018\18267006 - Presbyterian SS Reroute\Drawings\C3D\Plan Sheets\Plan and Profile.dwg, Last Save: 4/17/2019 8:53 AM, Last saved by: MTDolechek
 Last plotted by: Dolechek, Mark T., Plot Style: ---, Plot Scale: 1:2,584.9, Plot Date: 4/17/2019 10:27 AM, Plotter Used: None

REV.	DATE	DESCRIPTION	BY

CITY OF WICHITA
 WICHITA, KS
 PRESBYTERIAN CHURCH
 SS REROUTE

SS Line 1

JOB NO.: 18267006
 DATE: APRIL 2019
 DESIGNED BY: KWL/MTD
 DRAWN BY: MTD

BAR IS ONE INCH ON ORIGINAL DRAWING
 IF NOT ONE INCH ON THIS SHEET, ADJUST SCALES ACCORDINGLY.

DRAWING NUMBER

SHEET NUMBER **5** OF **7**

