STATE	PROJECT NO.	YEAR	SHEET NO.	TOTAL SHEETS
KANSAS	87 N-0660-01	2019	147	198

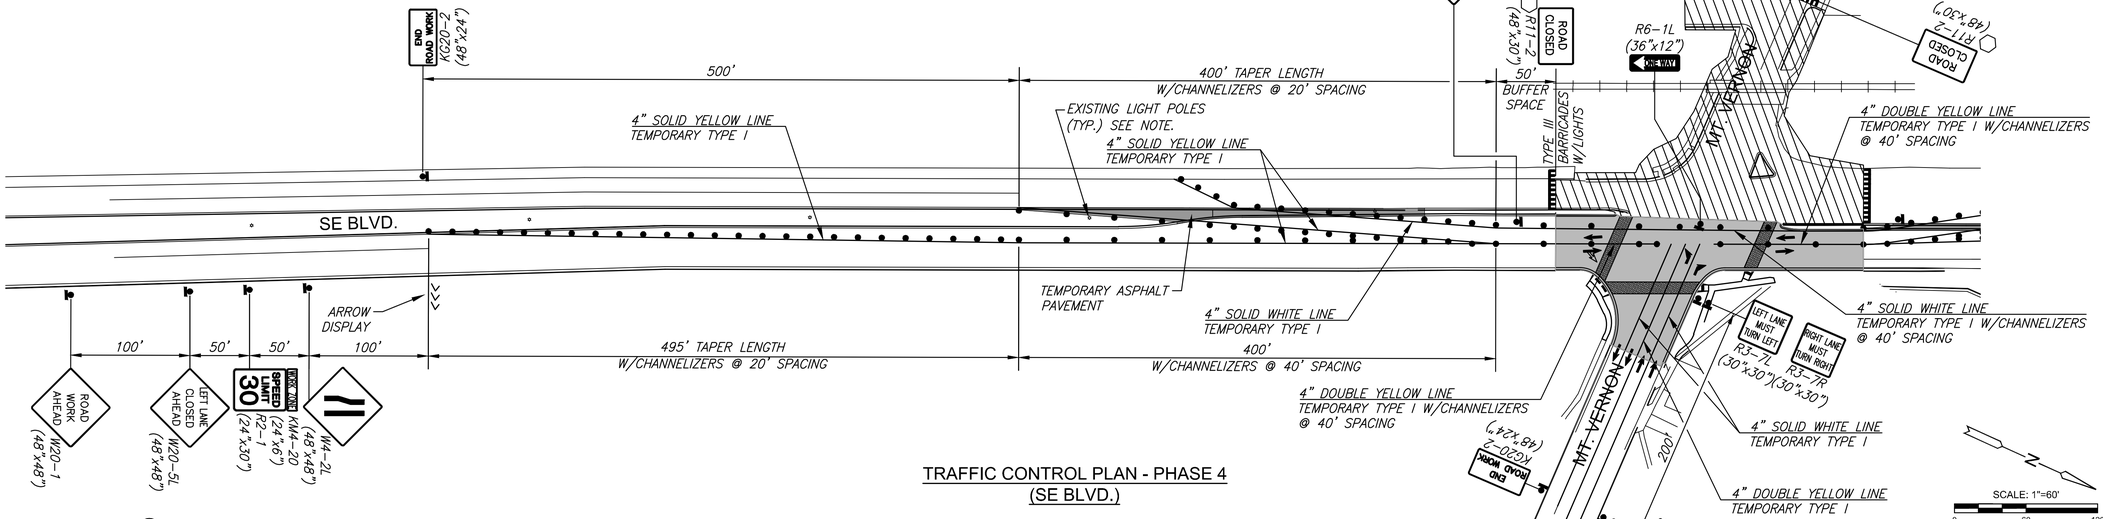

TRAFFIC CONTROL PLAN - PHASE 4
(SE BLVD.)

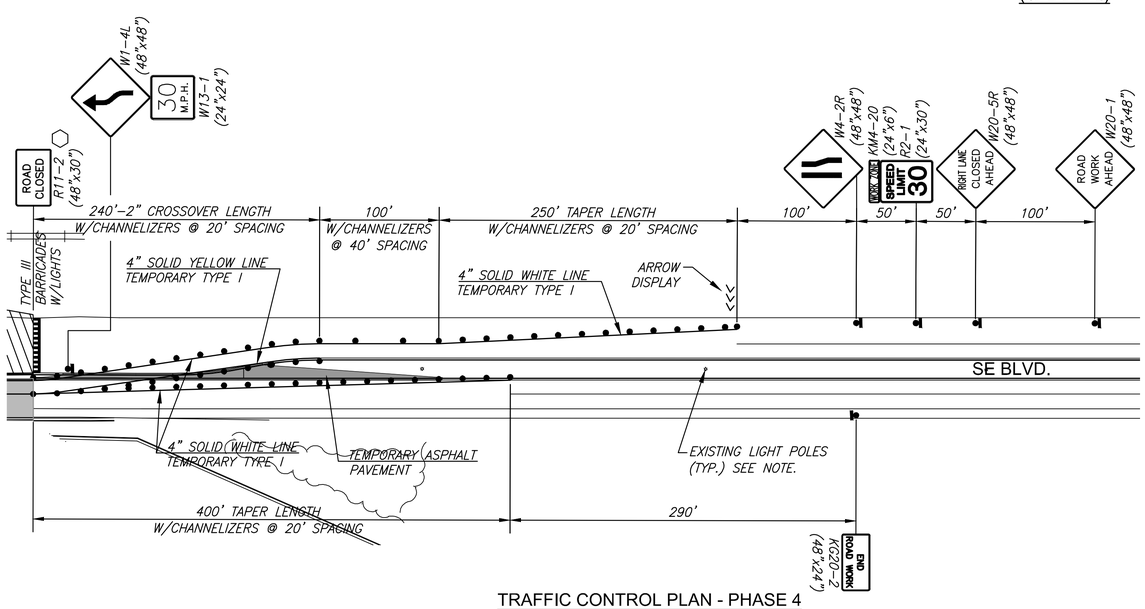

TRAFFIC CONTROL PLAN - PHASE 4
(SE BLVD.)

NOTE: ADJUST TRAFFIC CONTROL DEVICES TO AVOID CONFLICT WITH EXISTING LIGHT POLES IN THE MEDIANS. ADJUST TRAFFIC JUNCTION BOXES AS REQUIRED.

LEGEND

- TYPE III BARRICADES WITH LIGHTS
- MOUNT ON TYPE III BARRICADE
- TYPE B WARNING LIGHT
- SIGN
- TRAFFIC FLOW
- WORK SPACE
- CONSTRUCTION COMPLETED
- CHANNELIZER
- TEMPORARY ASPHALT PAVEMENT. SEE SHEET TRAFFIC CONTROL GENERAL NOTES.

MKEC
Wichita, KS • 316.684.9600

STREET IMPROVEMENTS FOR
MT. VERNON IMPROVEMENTS
BROADWAY TO SOUTHEAST BLVD.

©2019
MKEC Engineering
All Rights Reserved
www.mkec.com
These drawings and their contents, including, but not limited to, all concepts, designs, & ideas are the exclusive property of MKEC Engineering (MKEC), and may not be used or reproduced in any way without the express consent of MKEC.

TRAFFIC CONTROL PLAN - PHASE 4

PROJECT NO.	87 N-0660-01
DATE	8/19/2019
SCALE	1"=60'

DESIGNED	DRAWN	CHECKED
JRA	WNJ	JRA

NO.	REVISION	DATE

SHEET NO.
147 OF 198

Sh. No. 147

PLOTTED: Friday, August 23, 2019 @ 04:14PM

J:\CIVIL\081390\DWG\TC\081391TC7.DWG