

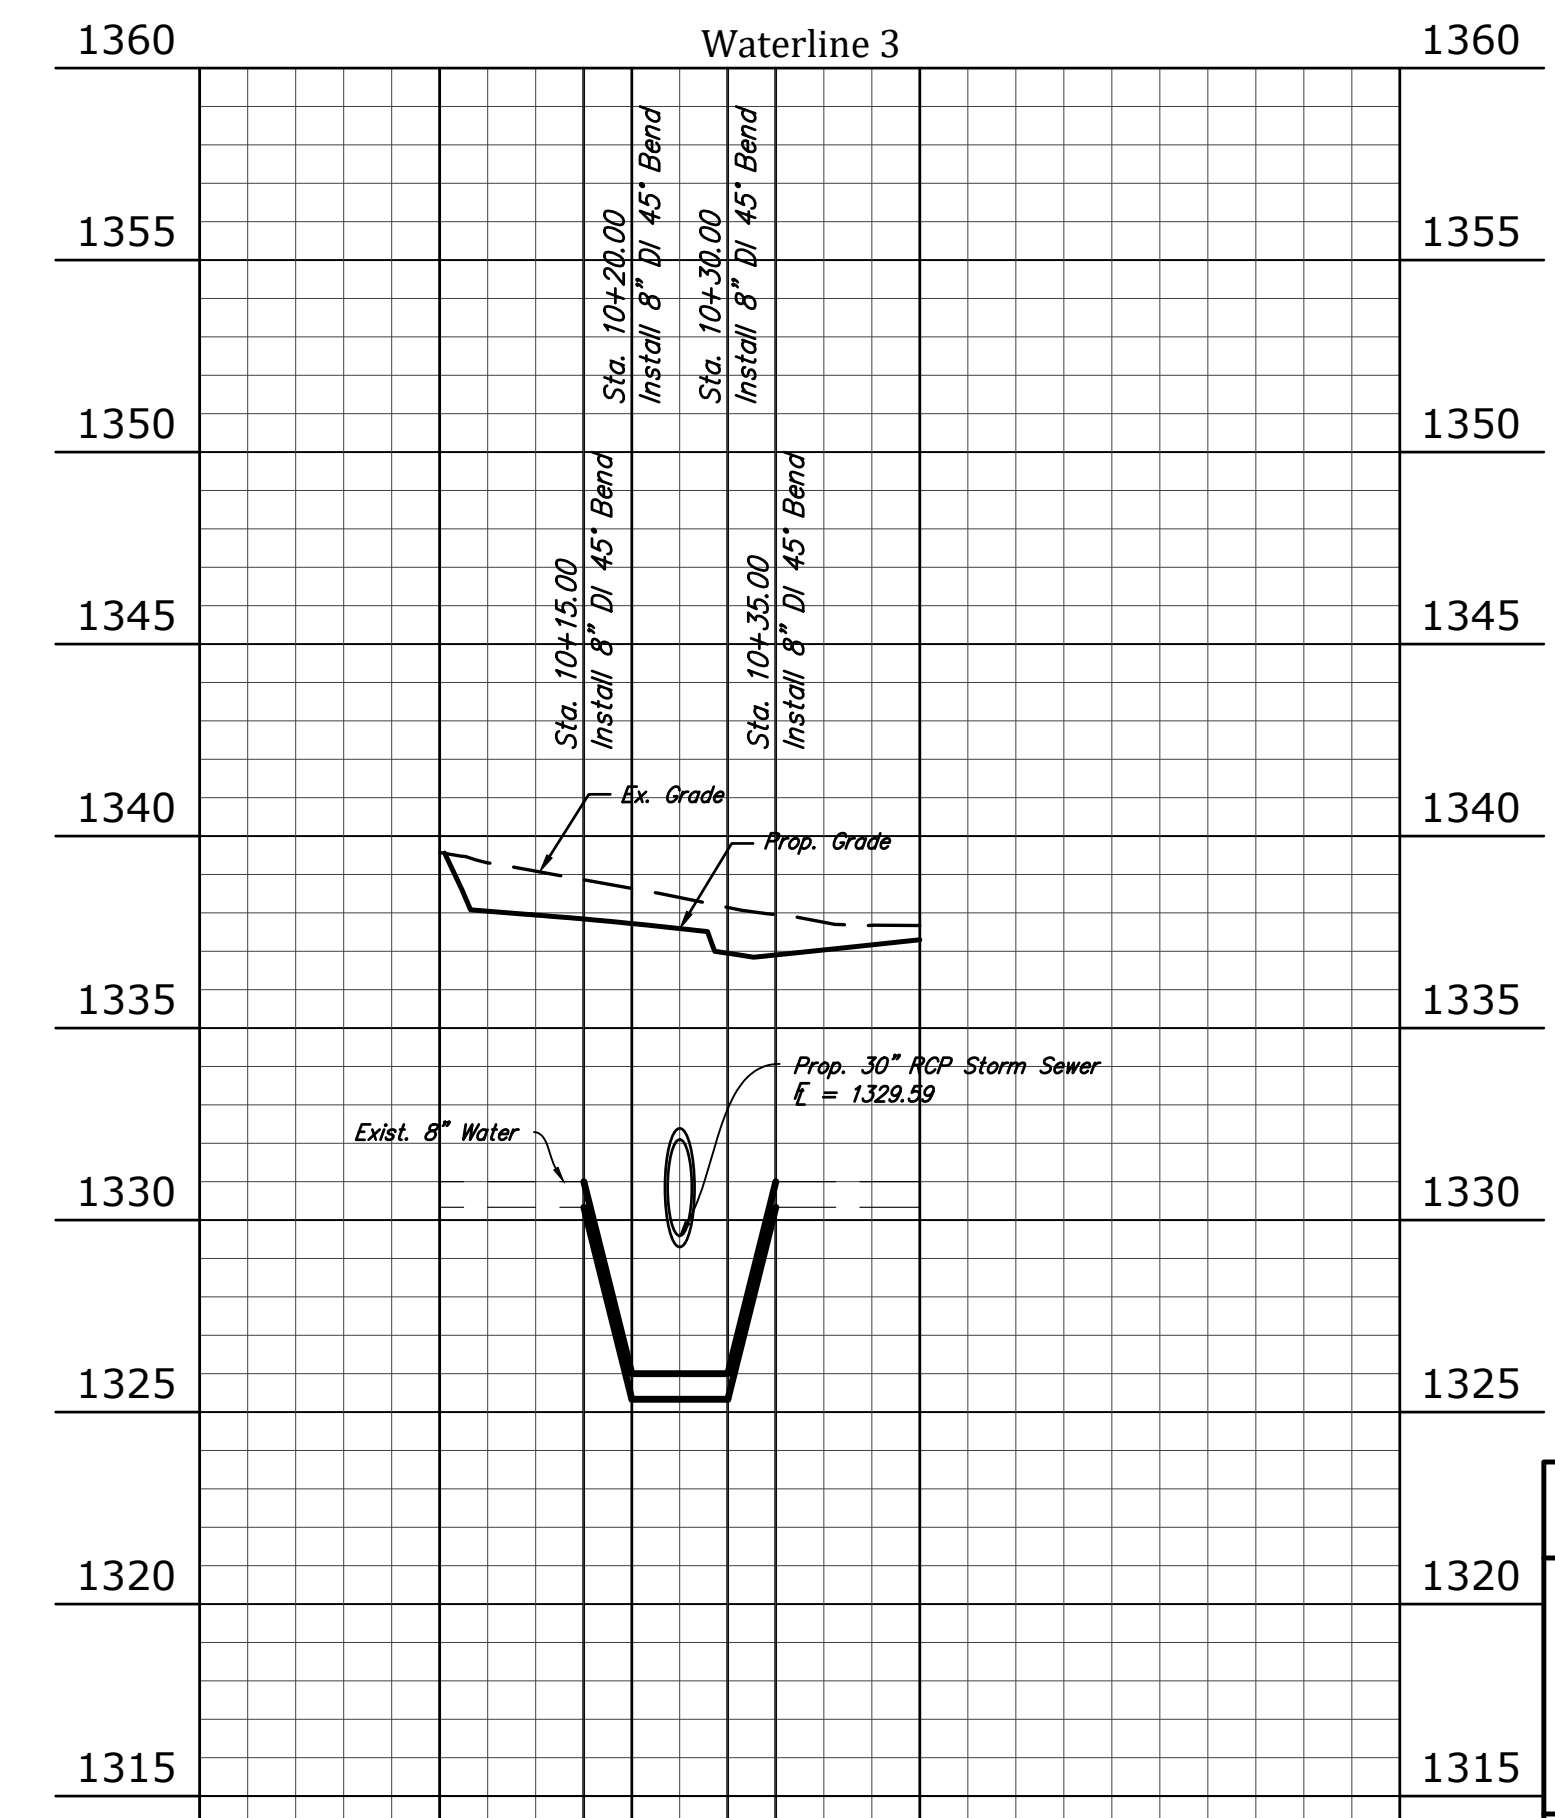


Vertical Scale: 1"=5'

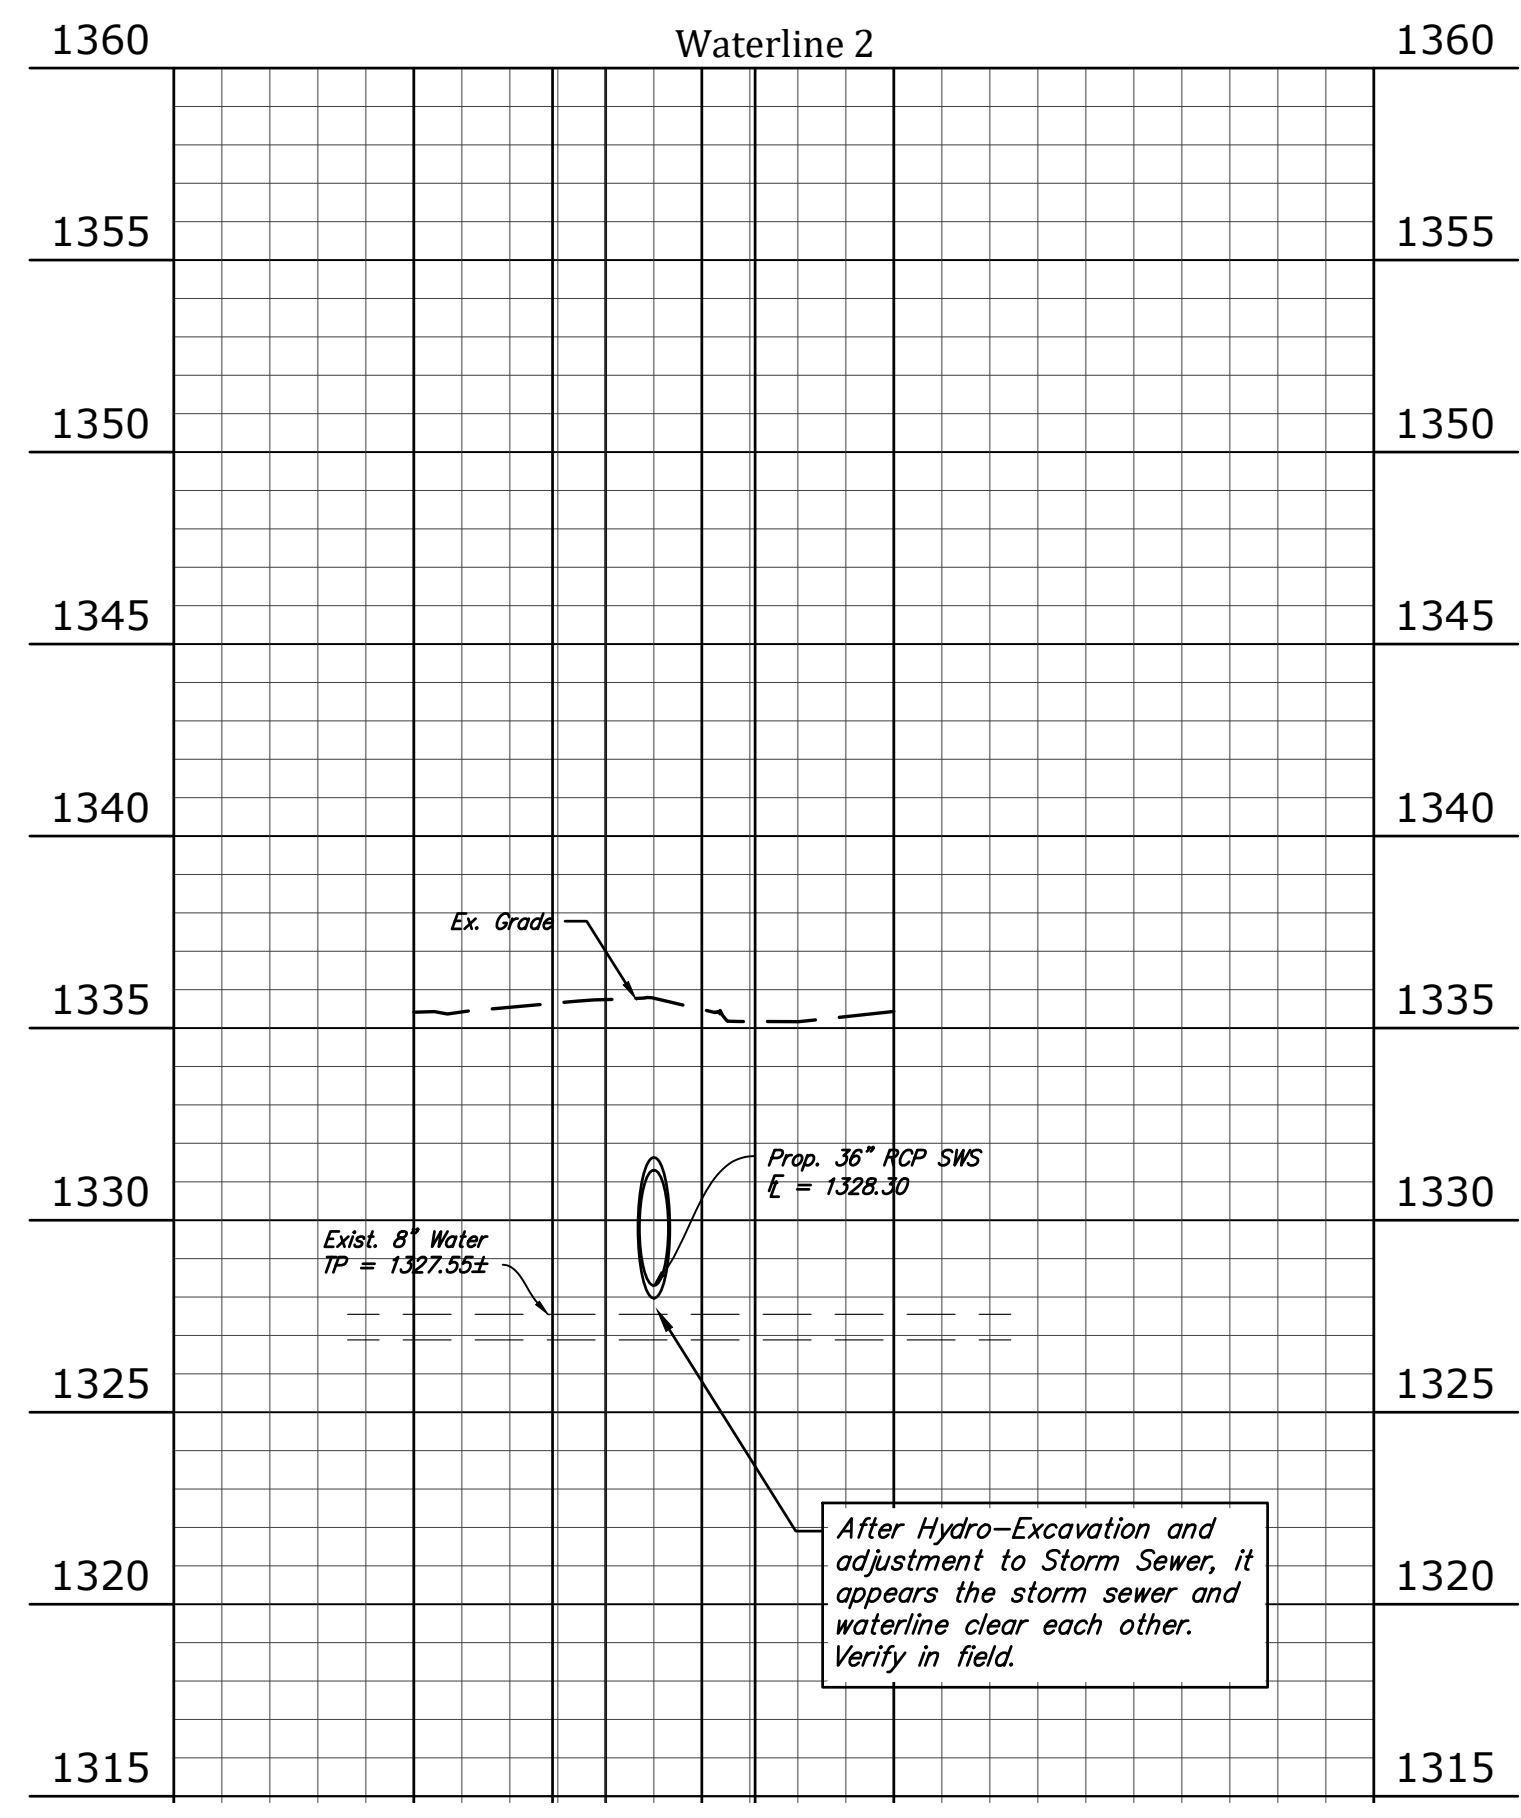

CITY OF WICHITA  
**WATER LINES 1-3  
 PLAN & PROFILE**

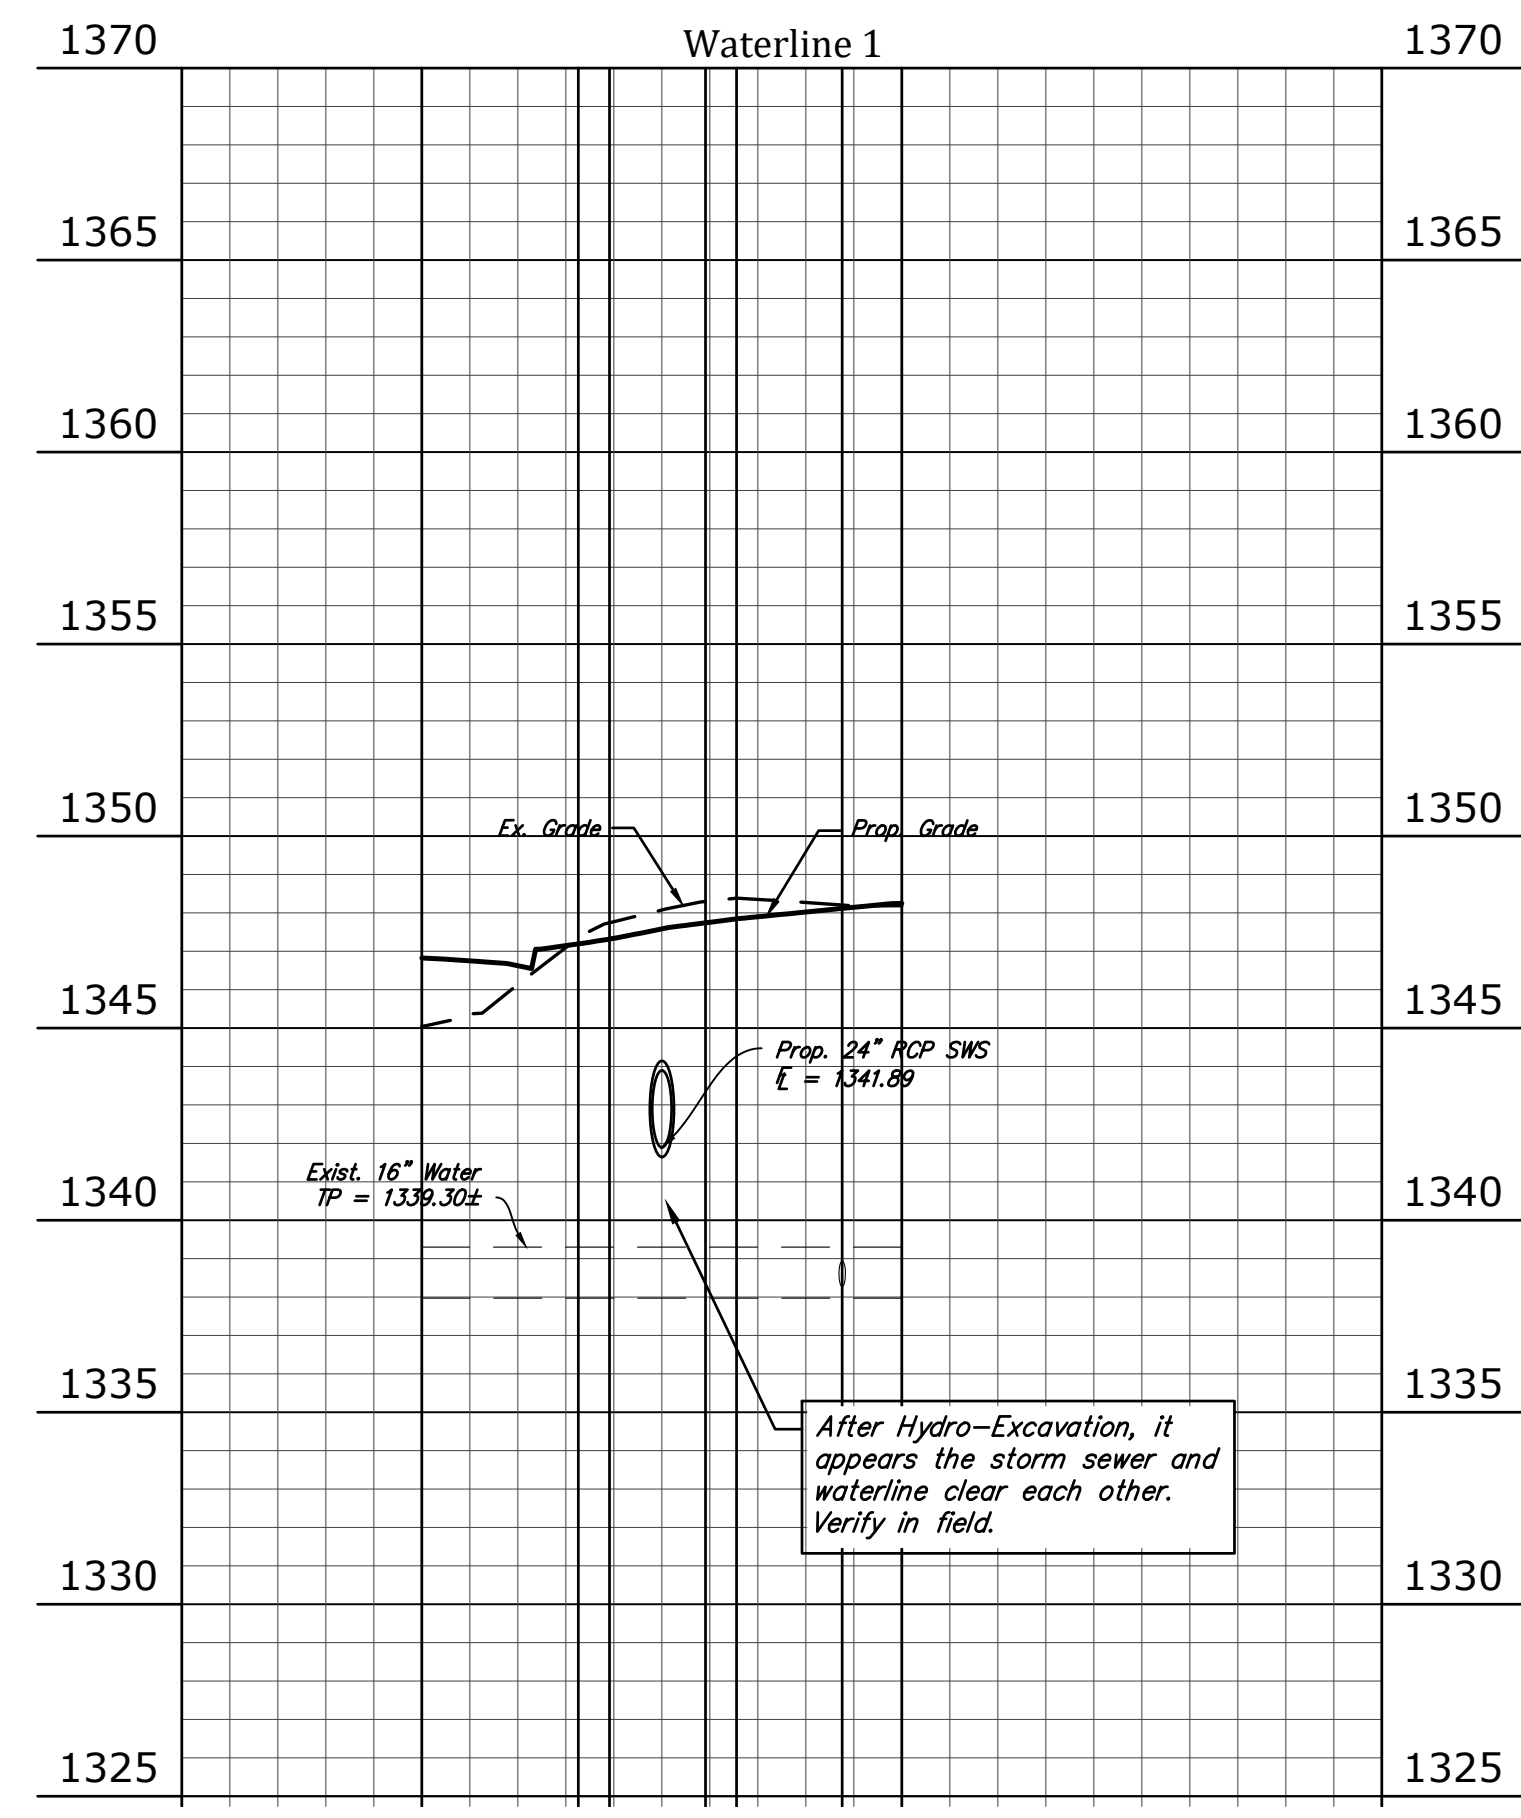

DESIGNED	MS	DRAWN	JM	SCALE	1" = 20'-0"	SHEET NO.	29
CHECKED	MS	DATE	09/18				

Drawn By: Schwab-Eaton, P.A.  
 Plotted: 5/3/2019 1:43 PM  
 File: 15.WD1 Water.dwg