



1 GREAT HALL 101 - EAST
1/2" = 1'-0"

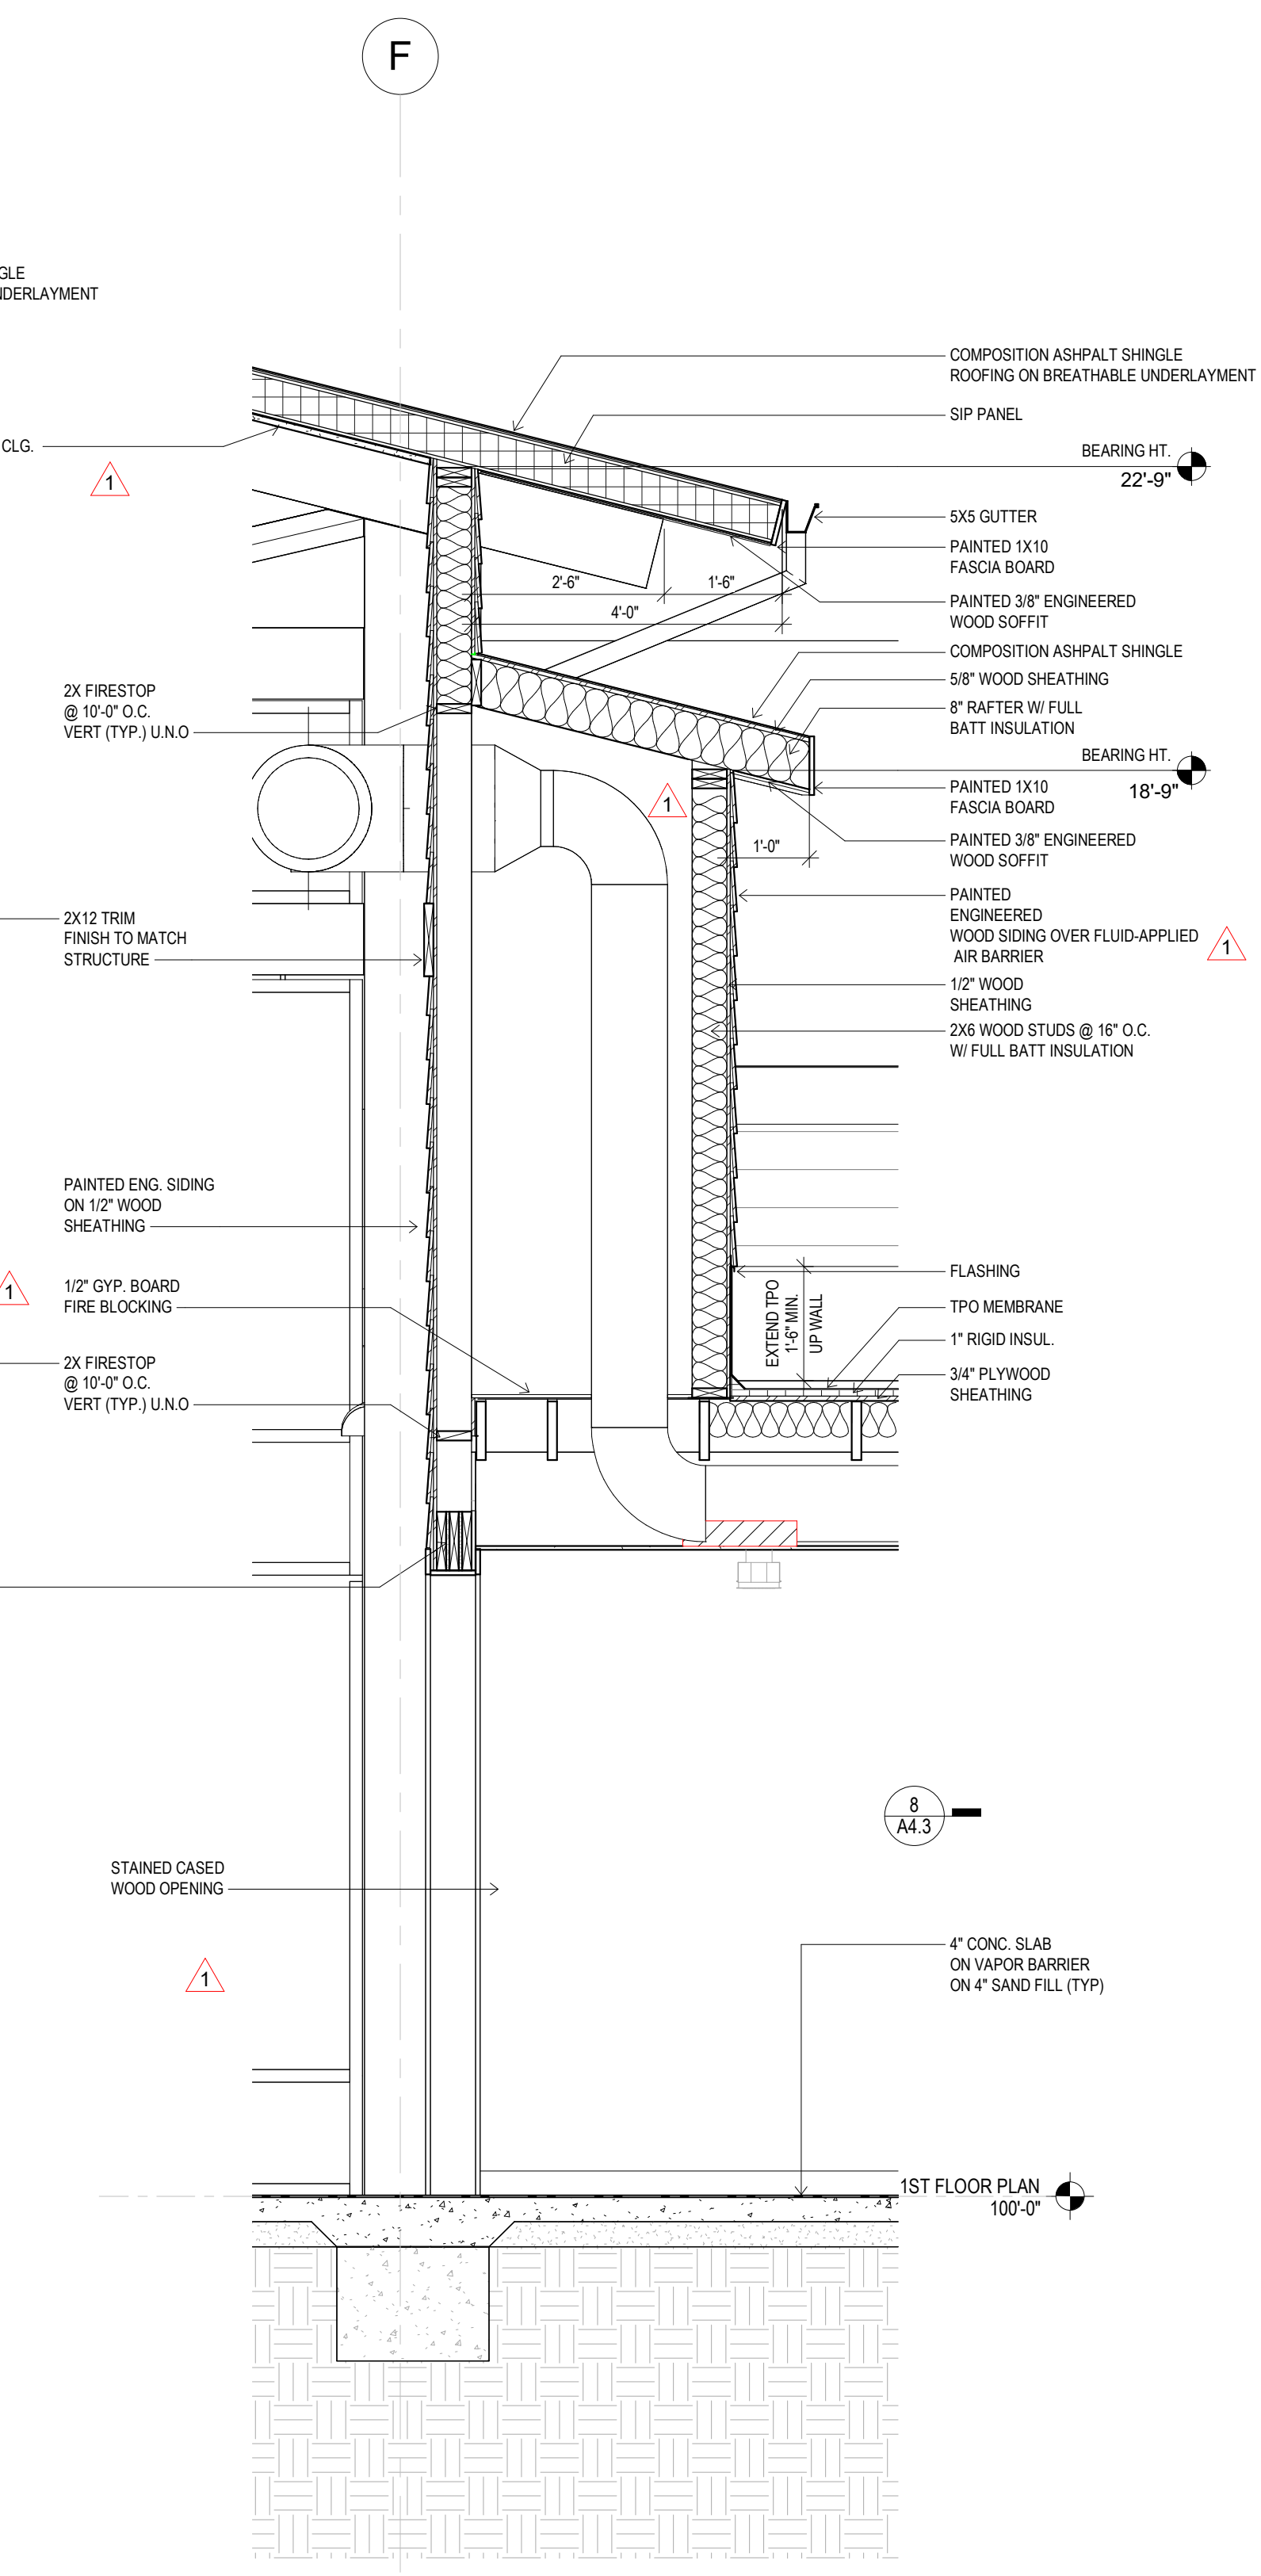

2 GREAT HALL 101 - WEST
1/2" = 1'-0"

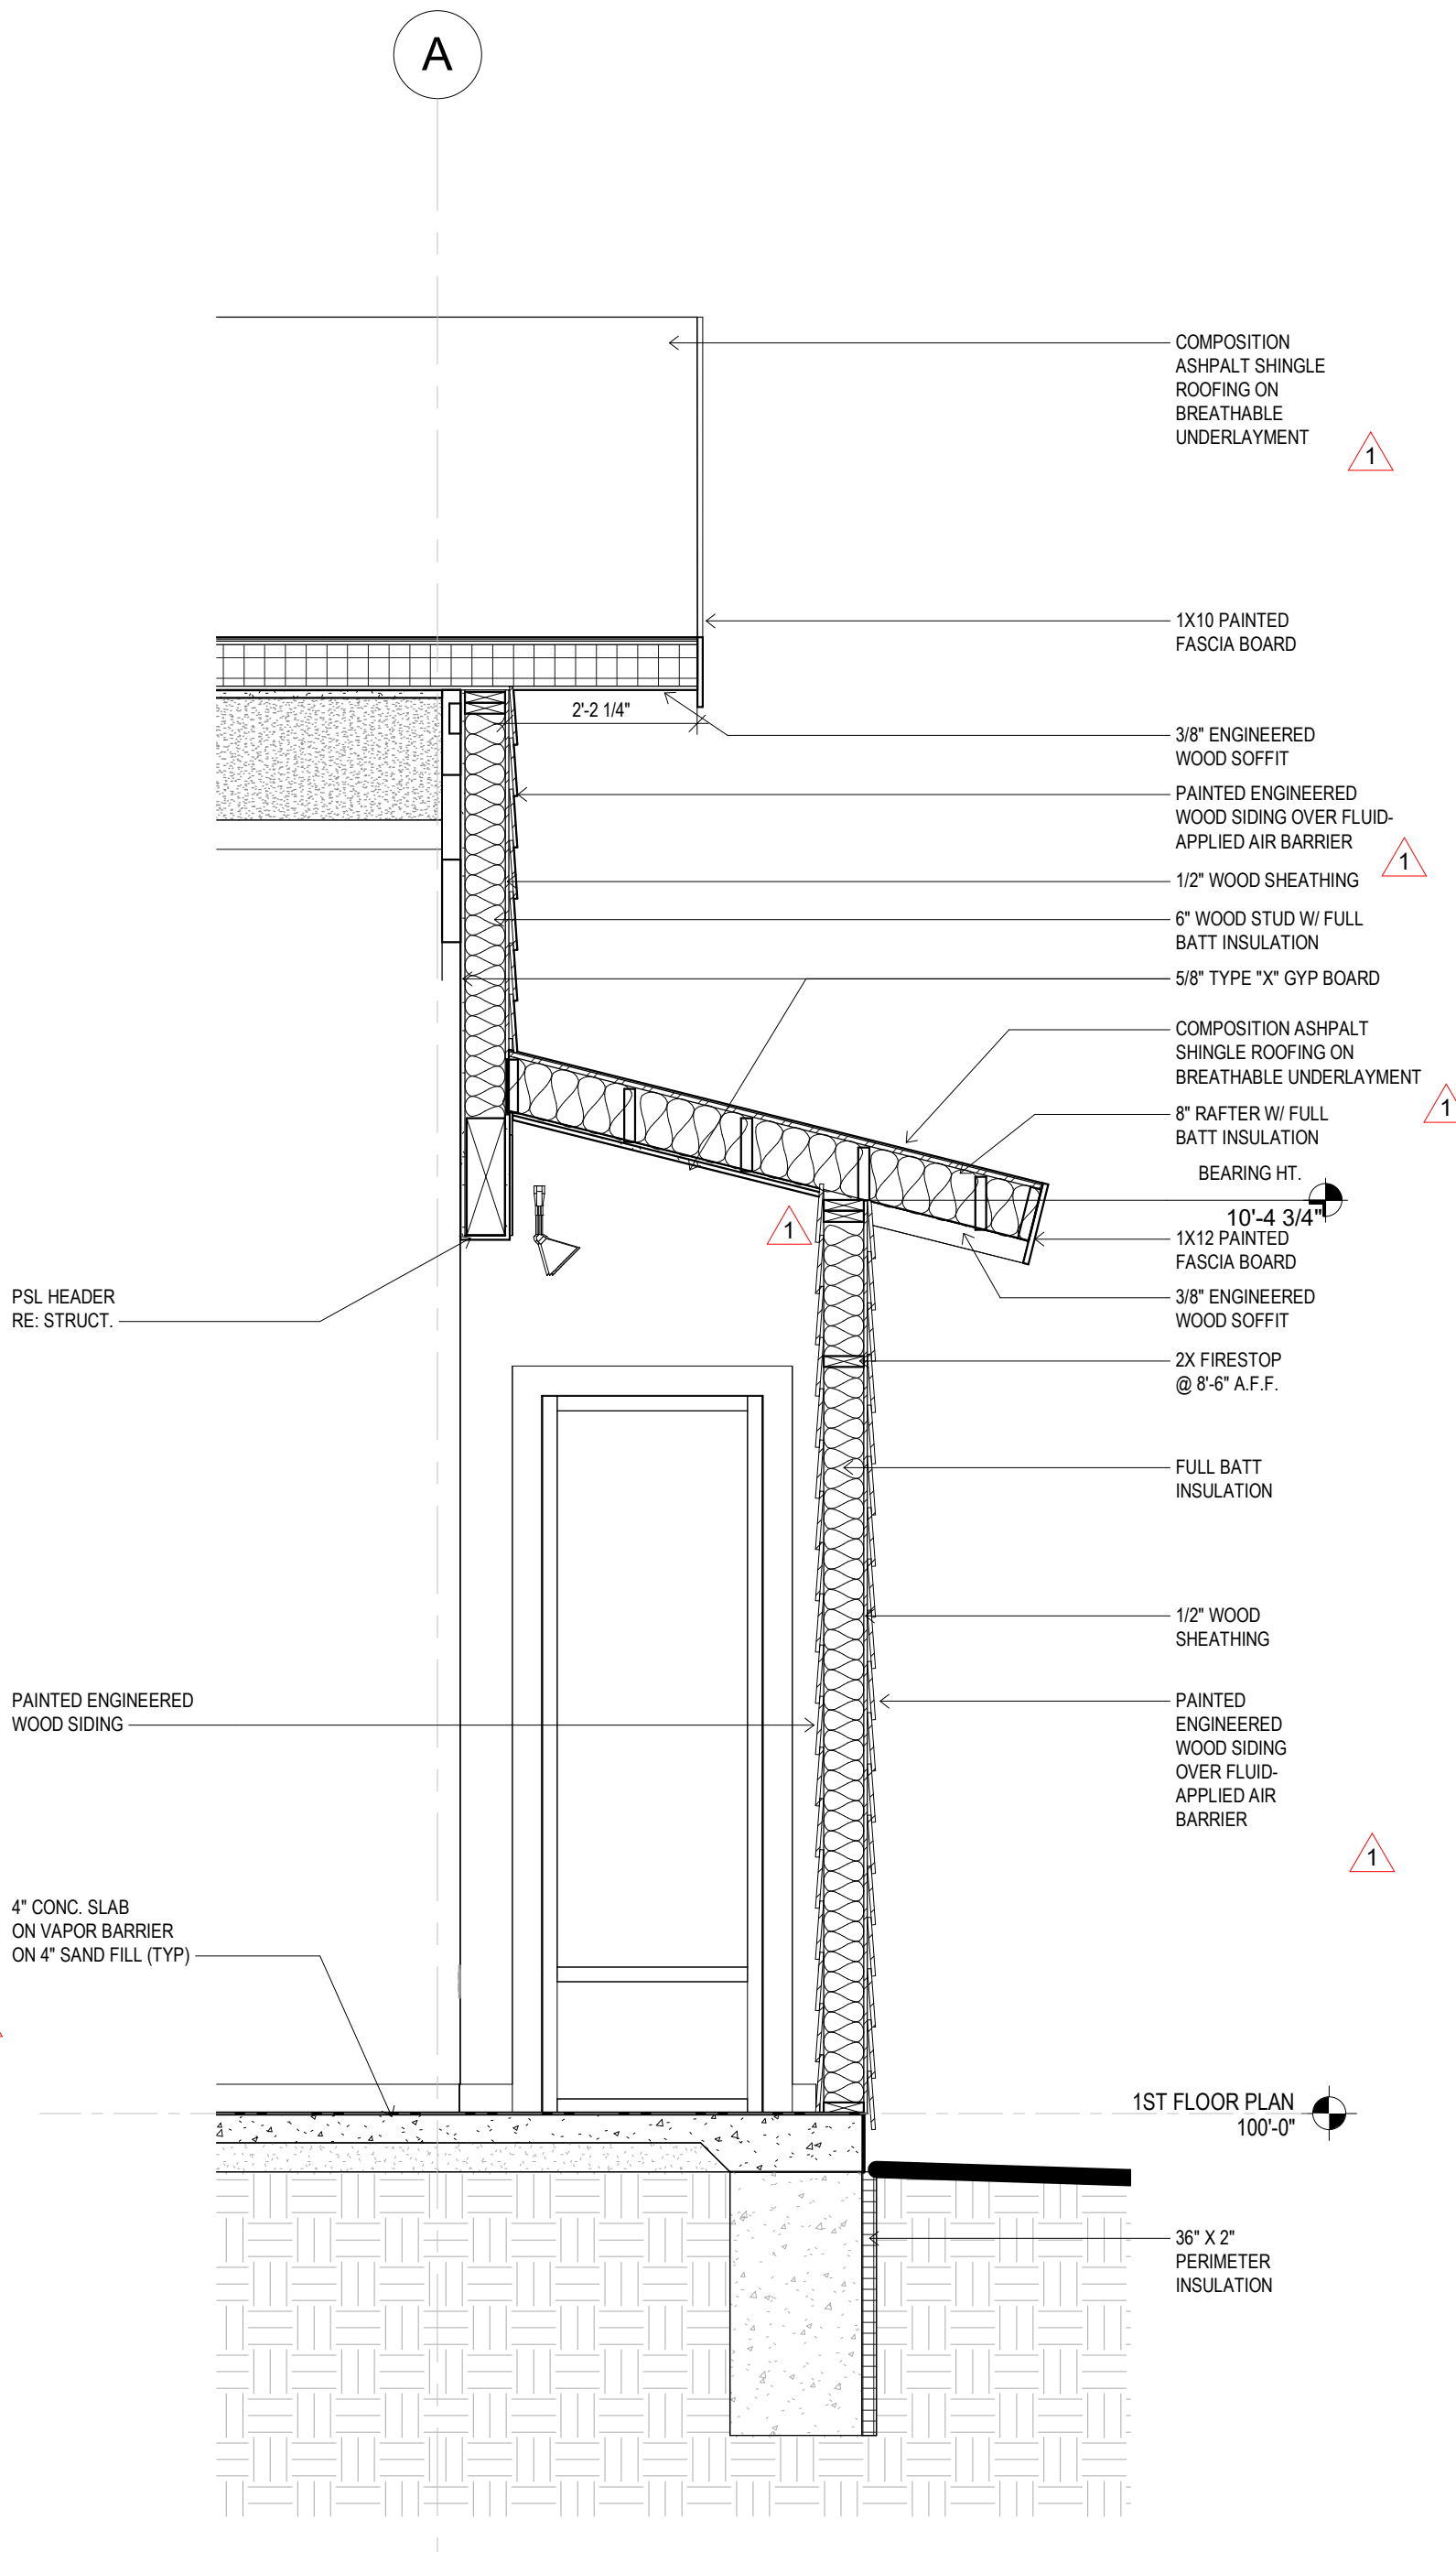

3 GREAT ROOM 105 - LOW ROOF
1/2" = 1'-0"

**O.J. WATSON PARK
EVENT CENTER**
3022 S MCLEAN BLVD., WICHITA, KS 67217

2 CITY REVISIONS 2 13 APR 20
1 CITY REVISIONS 30 MAR 20
PERMIT SET 13 FEB 20
WALL SECTIONS

A4.2