



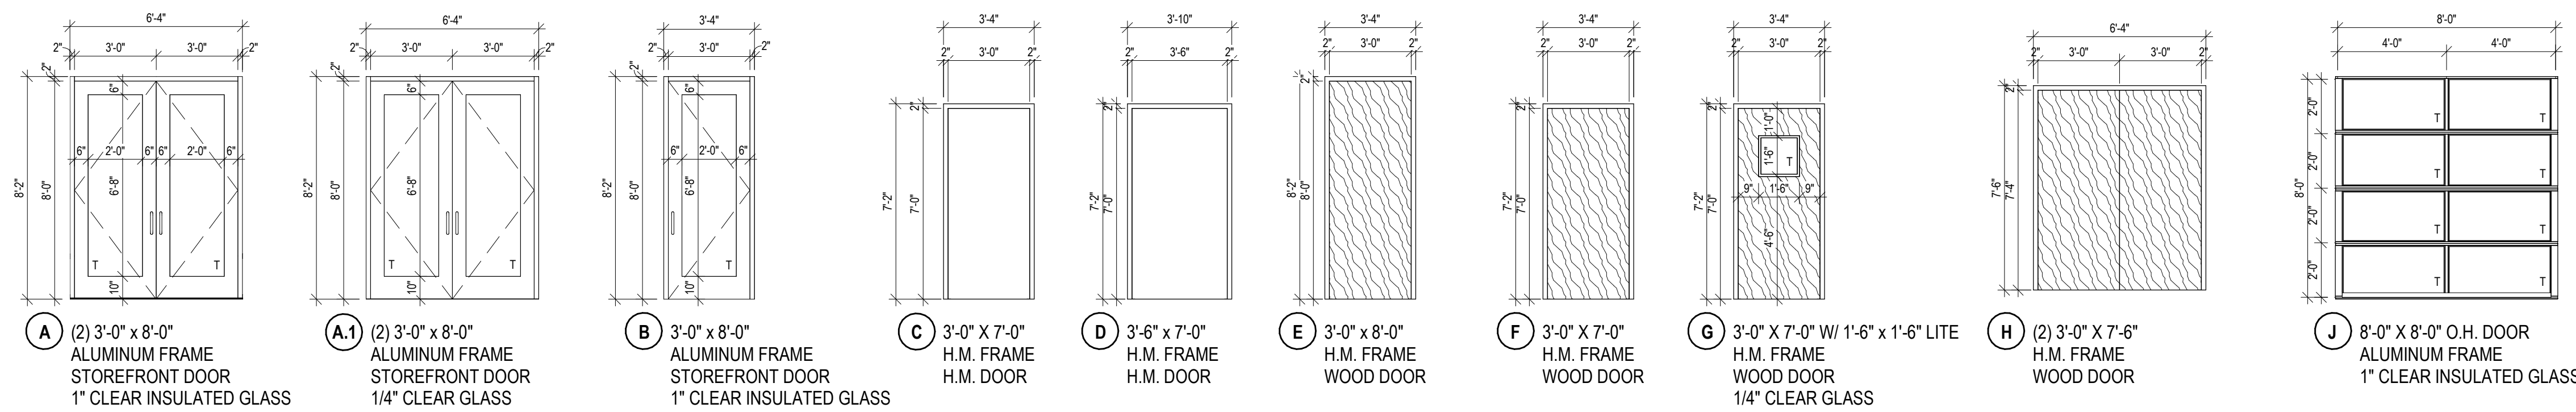

DOOR & FRAME TYPES SCALE: 1/4" = 1'
T - TEMPERED SAFETY GLASS

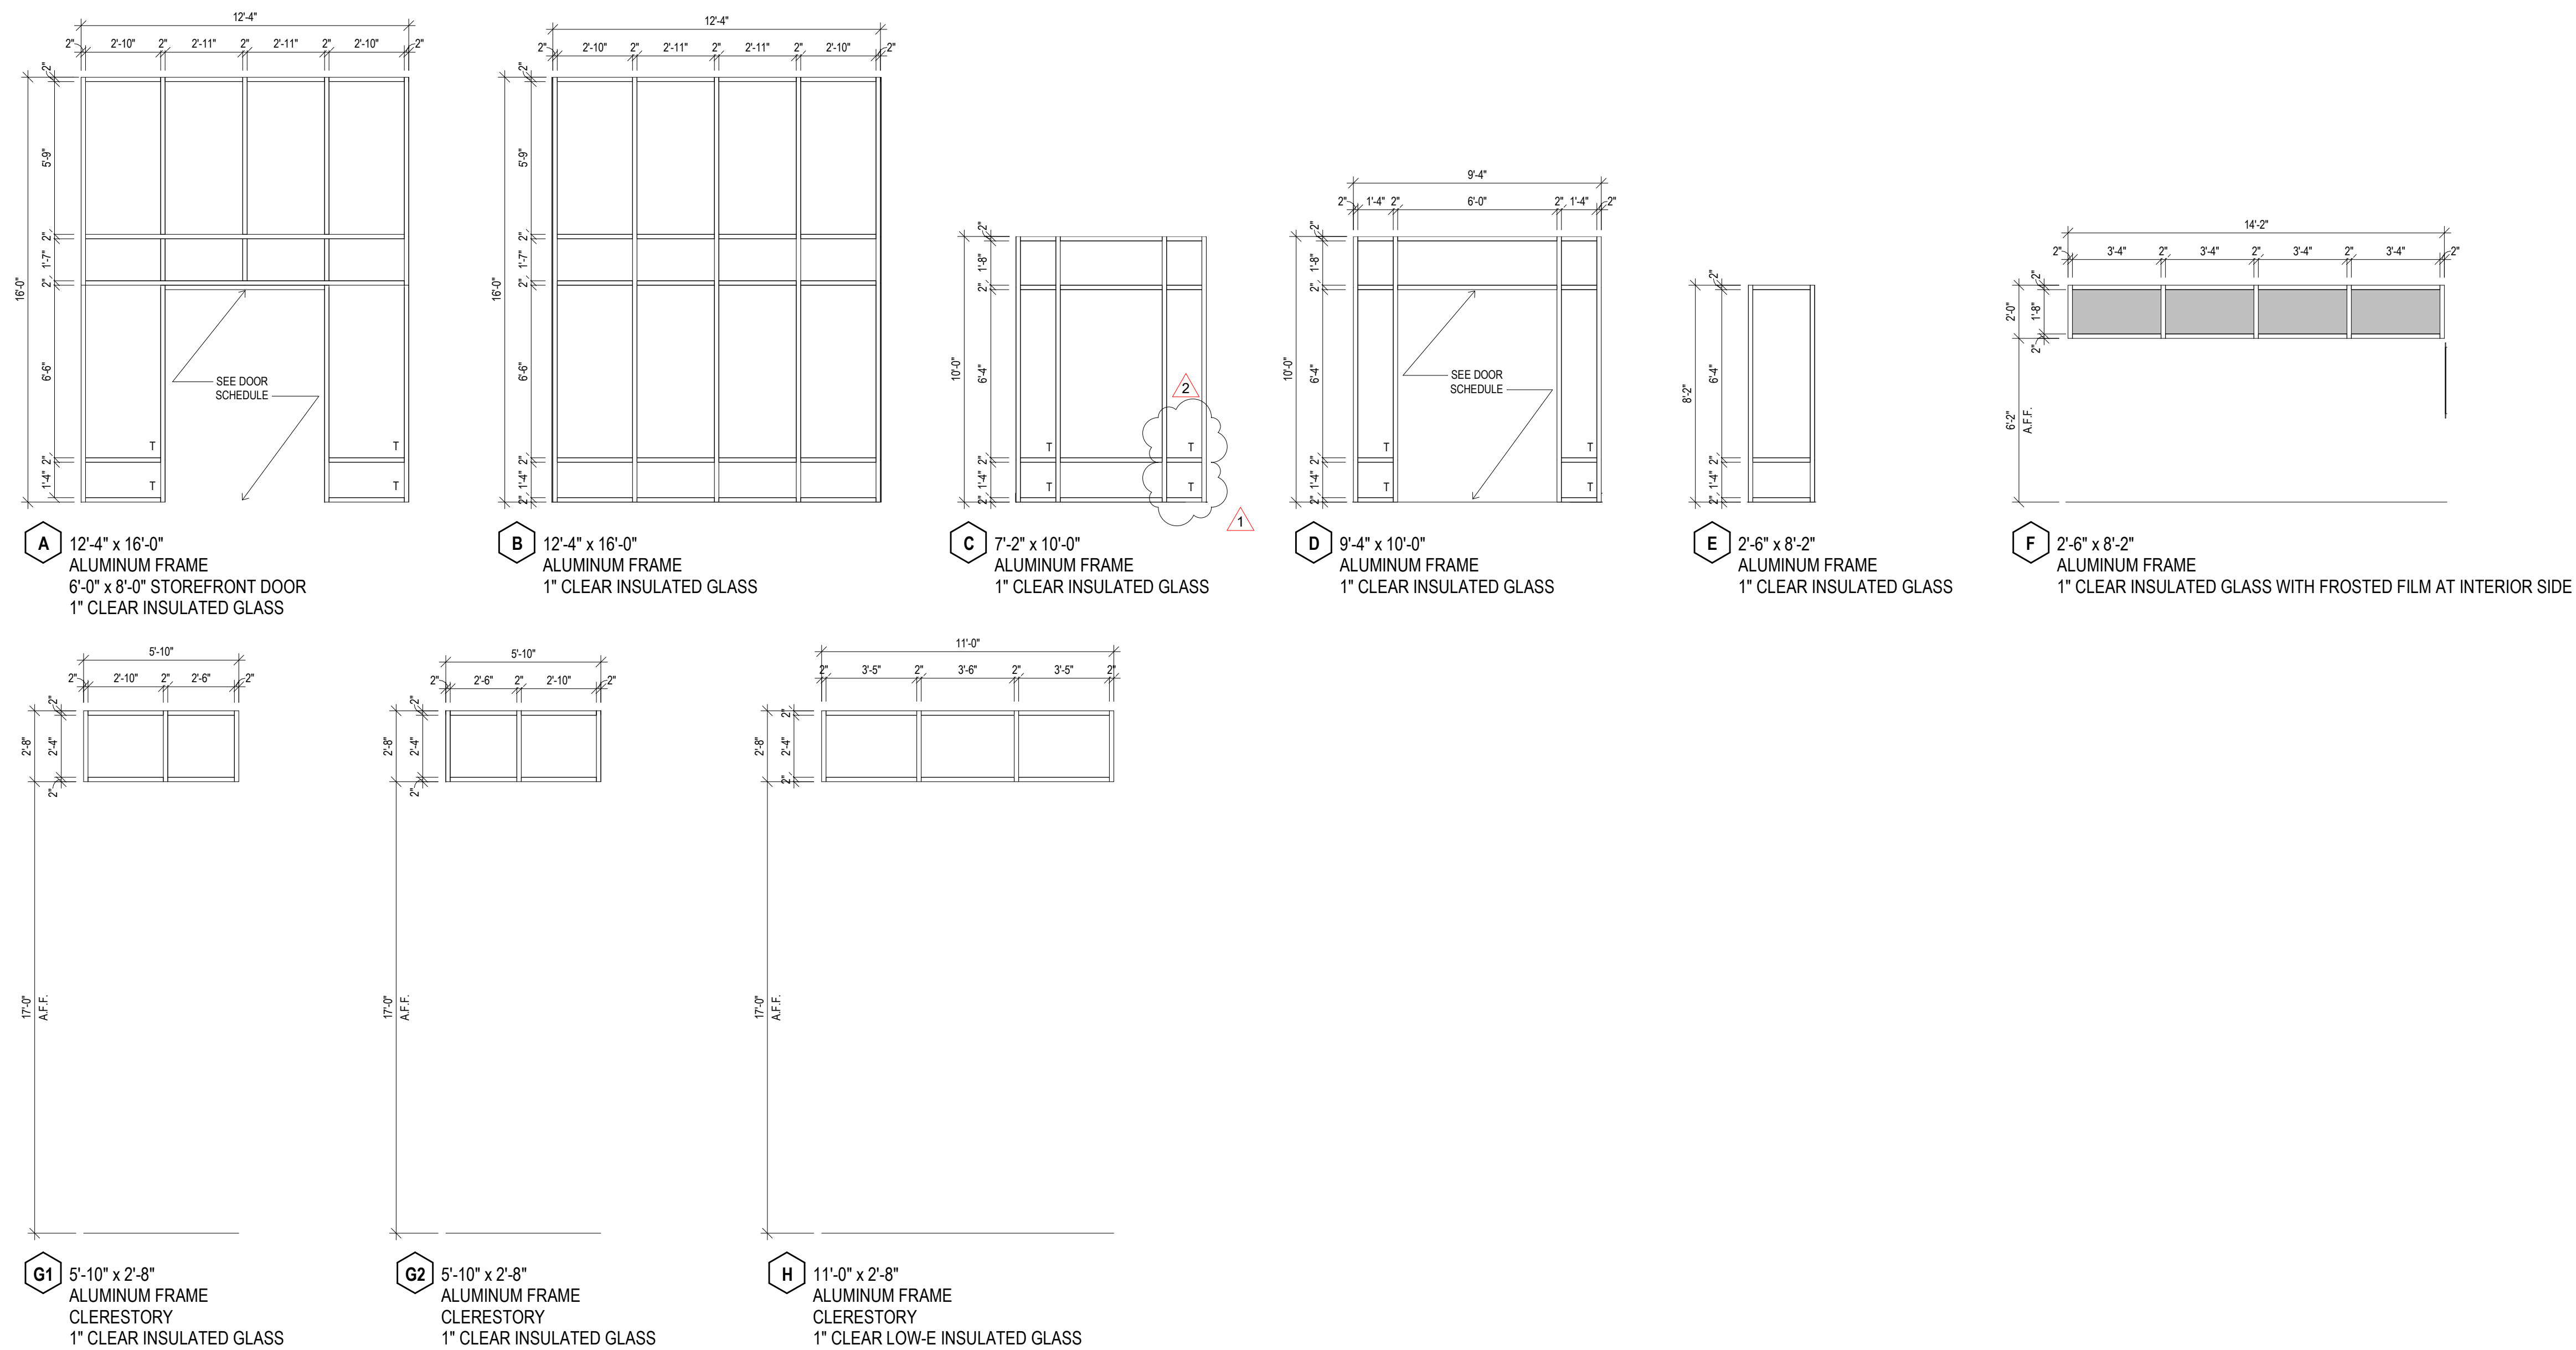

WINDOW TYPES SCALE: 1/4" = 1'
T - TEMPERED SAFETY GLASS



HARDWARE

- ① -CONTINUOUS HINGES
-PANIC DEVICE WITH CONCEALED VERTICAL RODS
-PULLS
-CLOSERS
-CYLINDER LOCK
-WEATHER STRIPPING
-THRESHOLD
- ② -CONTINUOUS HINGES
-PANIC DEVICE
-PULLS
-CLOSERS
-CYLINDER LOCK
-WEATHER STRIPPING
-THRESHOLD
- ③ -HINGES
-LEVER LOCKSET
-CLOSER
-WEATHER STRIPPING
-LATCH GUARD
-RAIN DRIP
-THRESHOLD
- ④ -CONTINUOUS HINGES
-PUSH BARS
-PULLS
-CLOSER
- ⑤ -HINGES
-LEVER LOCKSET
- ⑥ -HINGES
-LEVER LOCKSET
-CLOSER
- ⑥.1 -HINGES
-LEVER LOCKSET
-CLOSER
-ARMOR GUARD BOTH SIDES OF DOOR
- ⑦ -HINGES
-LEVER PRIVACY LOCKSET
-CLOSER
- ⑧ -HINGES
-PUSH / PULL
-CLOSER
- ⑨ -HINGES
-LEVER LOCKSET AT WEST LEAF
-TOP & BOTTOM FLUSHBOLTS

**O.J. WATSON PARK
EVENT CENTER**
3022 S MCLEAN BLVD, WICHITA, KS 67217

CITY REVISIONS 2 13 APR 20
CITY REVISIONS 30 MAR 20
PERMIT SET 13 FEB 20

DOOR & WINDOW
SCHEDULES

A8.1