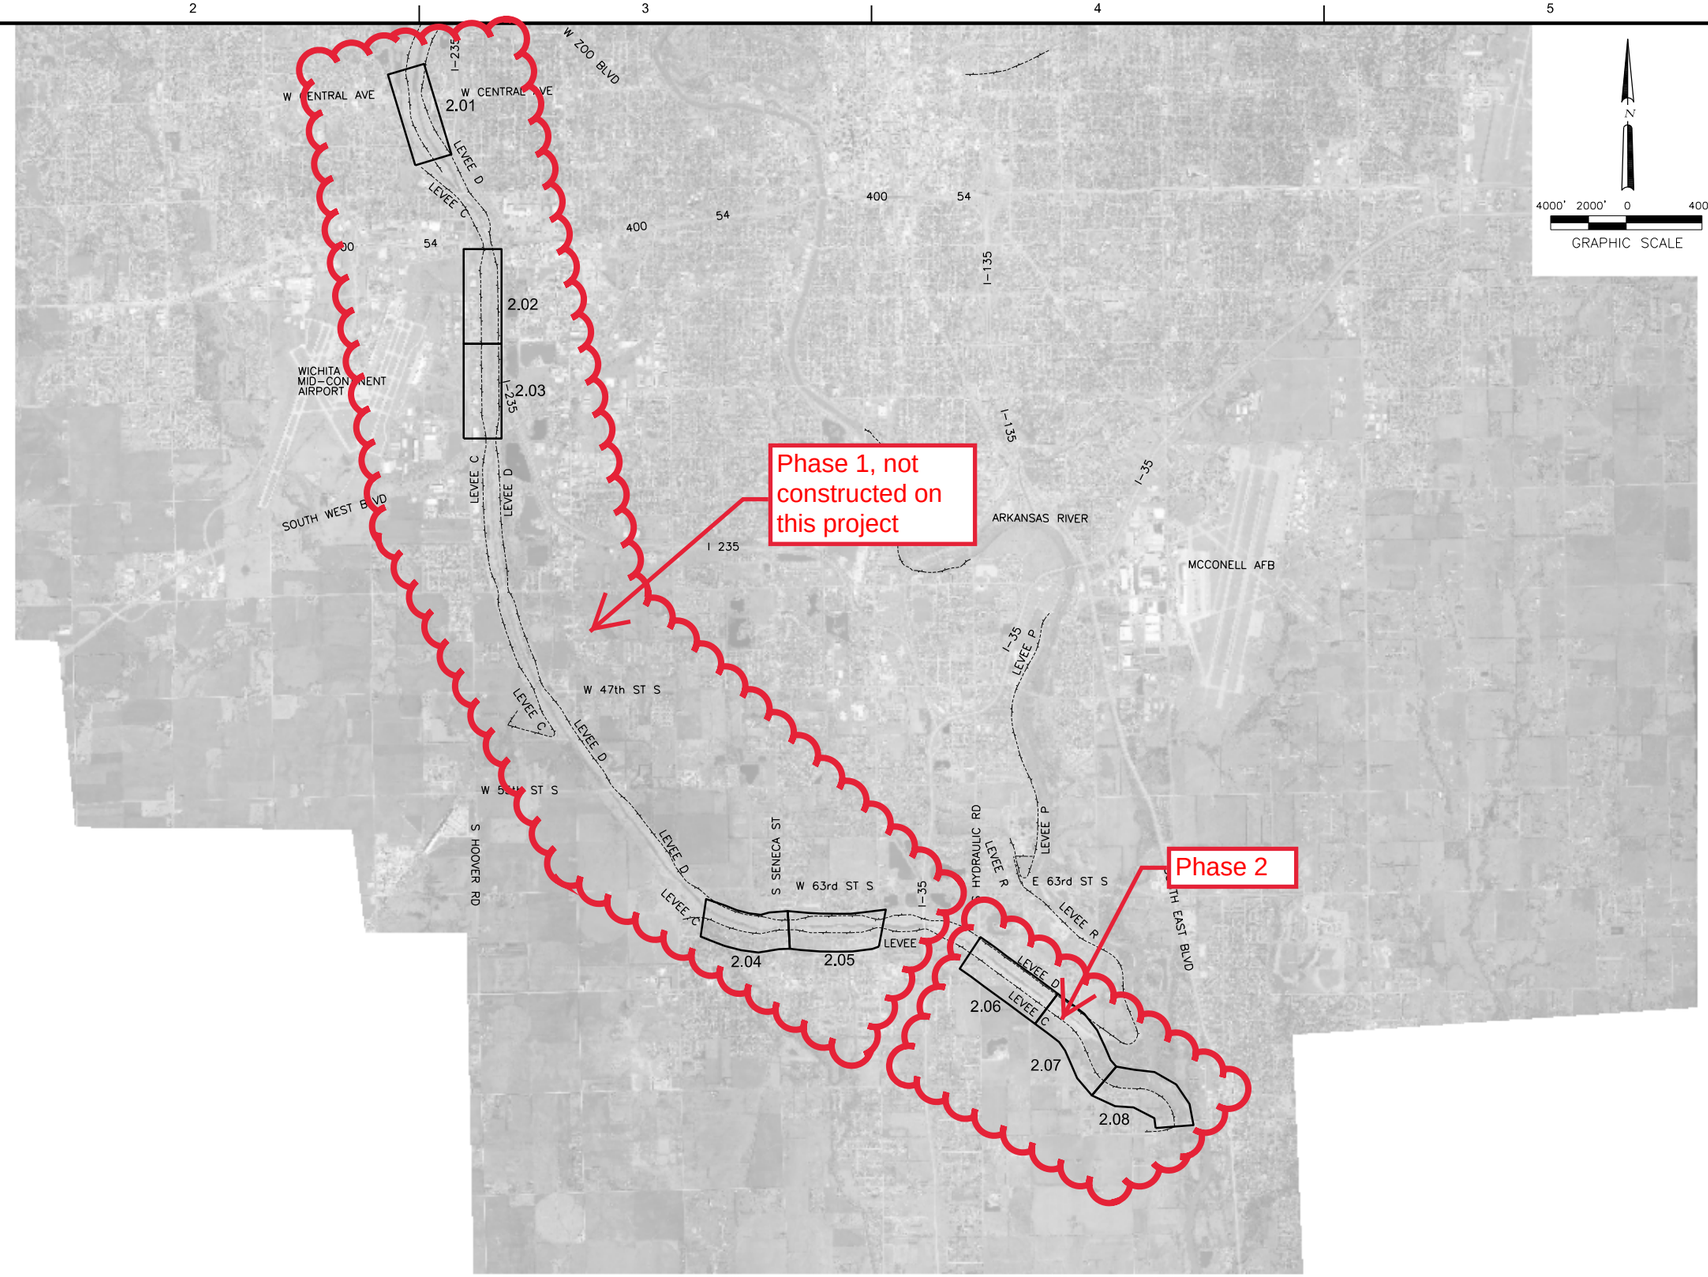

4000' 2000' 0 4000'
GRAPHIC SCALE

MARK	DESCRIPTION	DATE	APPR.

amec
AMEC Earth & Environmental, Inc.
1129 SW Wanamaker
Topeka, Kansas 66604
Phone: (785) 272-6010
Fax: (785) 272-0878

CITY OF WICHITA

LOWER LEVEE "C" TOE DRAIN REPLACEMENT
WICHITA-VALLEY CENTER LOCAL FLOOD PROTECTION PROJECT
WICHITA, KANSAS

PREPARED FOR
THE CITY OF WICHITA, KANSAS
455 N. Main
Wichita, KS 67202

LAWRENCE J. SAMPLE
LICENSED
15855
8/13/12
KANSAS
PROFESSIONAL ENGINEER

DESIGNED BY: Larry Sample, PE		DATE: 08-13-2012
DWN BY: REB	CKD BY: LBK	APP BY: L. SAMPLE
FILE NAME: 06_KEY PLAN.dgn		

AMEC PROJ. NO. 5-6150-0001

PARTIAL KEY PLAN

C-1.01

SHEET 6 OF 19