
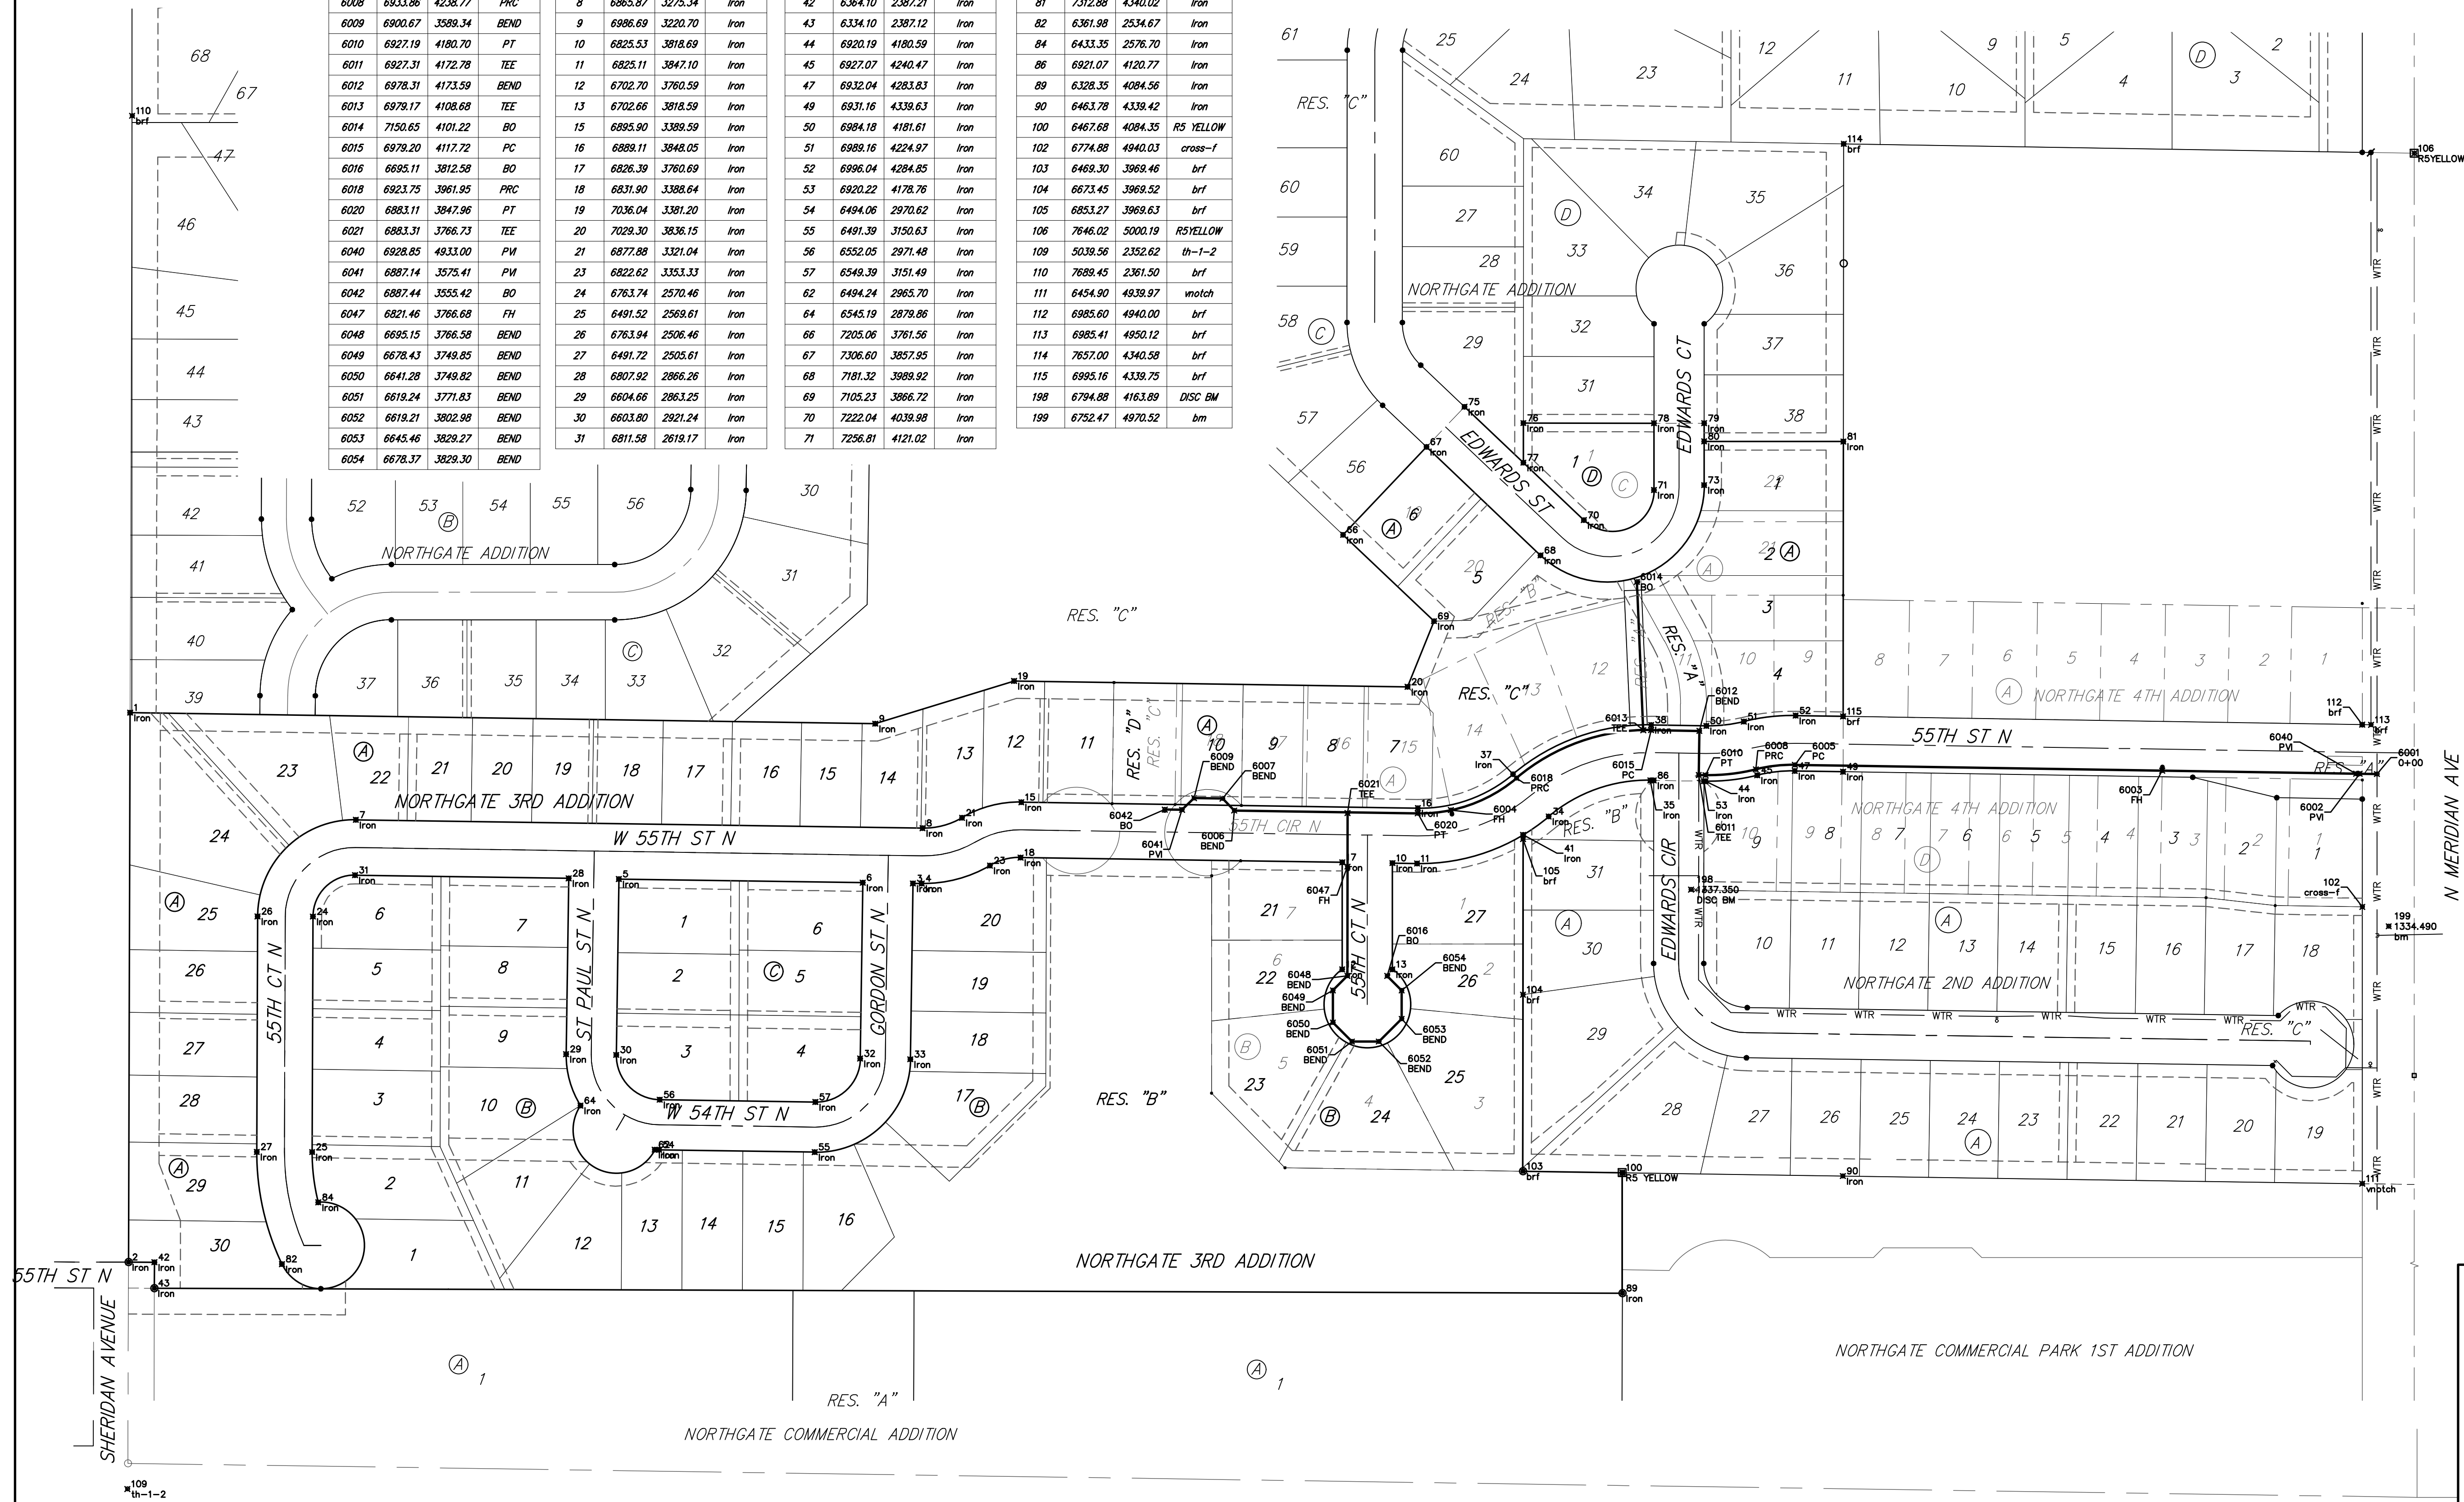


**BENCHMARKS:**  
 Chiseled square, center of storm water sewer vault, west side of Meridian, 145' S. & 30.6' E. of the NE Cor., Lot 1, Block A, Northgate 2nd Addition.  
 Elev. = 1334.49 (NAVD88)

Brass Disc in top of curb 14.8' west of southwest corner of Lot 9, Blk A, Northgate 2nd Addition.  
 Elev. = 1337.35 (NAVD88)

WTR POINTS				CONTROL POINTS				CONTROL POINTS				CONTROL POINTS				
Point #	Northing	Easting	Description	Point #	Northing	Easting	Description	Point #	Northing	Easting	Description	Point #	Northing	Easting	Description	
6001	6928.48	4956.99	O+00	1	6999.45	2359.19	Iron	32	6598.63	3203.24	Iron	73	7262.46	4179.03	Iron	
6002	6928.79	4937.00	PW	2	6364.20	2357.21	Iron	33	6598.77	3261.23	Iron	75	7353.01	3902.01	Iron	
6003	6932.37	4708.64	FH	3	6802.03	3264.24	Iron	34	6879.39	3999.31	Iron	76	7334.19	3970.08	Iron	
6004	6896.82	3886.24	FH	4	6801.88	3274.39	Iron	35	6921.11	4116.85	Iron	77	7288.42	3970.05	Iron	
6005	6939.04	4283.94	PC	5	6807.06	2924.26	Iron	37	6928.34	3958.08	Iron	78	7334.07	4121.08	Iron	
6006	6886.25	3635.77	BEND	6	6802.88	3206.25	Iron	38	6985.20	4117.81	Iron	79	7334.03	4179.08	Iron	
6007	6900.18	3622.25	BEND	7	6875.57	2620.12	Iron	41	6858.21	3969.71	Iron	80	7313.01	4179.07	Iron	
6008	6933.86	4238.77	PRC	8	6865.87	3275.34	Iron	42	6364.10	2387.21	Iron	81	7312.88	4340.02	Iron	
6009	6900.67	3589.34	BEND	9	6986.69	3220.70	Iron	43	6334.10	2387.12	Iron	82	6361.98	2534.67	Iron	
6010	6927.19	4180.70	PT	10	6825.53	3818.69	Iron	44	6920.19	4180.59	Iron	84	6433.35	2576.70	Iron	
6011	6927.31	4172.78	TEE	11	6825.11	3847.10	Iron	45	6927.07	4240.47	Iron	86	6921.07	4120.77	Iron	
6012	6978.31	4173.59	BEND	12	6702.70	3760.59	Iron	47	6932.04	4283.83	Iron	89	6328.35	4084.56	Iron	
6013	6979.17	4108.68	TEE	13	6702.66	3818.59	Iron	49	6931.16	4339.63	Iron	90	6463.78	4339.42	Iron	
6014	7150.65	4101.22	BO	15	6895.90	3389.59	Iron	50	6984.18	4181.61	Iron	100	6467.68	4084.35	RS YELLOW	
6015	6979.20	4117.72	PC	16	6889.11	3848.05	Iron	51	6989.16	4224.97	Iron	102	6774.88	4940.03	cross-f	
6016	6895.11	3812.58	BO	17	6826.39	3760.69	Iron	52	6996.04	4284.85	Iron	103	6469.30	3969.46	brf	
6018	6923.75	3961.95	PRC	18	6831.90	3388.64	Iron	53	6920.22	4178.76	Iron	104	6673.45	3969.52	brf	
6020	6883.11	3847.96	PT	19	7036.04	3381.20	Iron	54	6494.06	2970.62	Iron	105	6853.27	3969.63	brf	
6021	6883.31	3786.73	TEE	20	7029.30	3836.15	Iron	55	6491.39	3150.63	Iron	106	7846.02	5000.19	RS YELLOW	
6040	6928.85	4933.00	PW	21	6877.88	3321.04	Iron	56	6552.05	2971.48	Iron	109	5039.56	2352.62	th-1-2	
6041	6887.14	3575.41	PW	23	6822.62	3353.33	Iron	57	6549.39	3151.49	Iron	110	7889.45	2361.50	brf	
6042	6887.44	3555.42	BO	24	6763.74	2970.46	Iron	62	6494.24	2965.70	Iron	111	6454.90	4839.97	wotch	
6047	6821.46	3766.68	FH	25	6491.52	2569.61	Iron	64	6545.19	2879.86	Iron	112	6985.60	4940.00	brf	
6048	6695.15	3766.58	BEND	26	6763.94	2506.46	Iron	66	7205.06	3761.56	Iron	113	6985.41	4950.12	brf	
6049	6678.43	3749.85	BEND	27	6491.72	2505.61	Iron	67	7306.60	3857.95	Iron	114	7857.00	4340.58	brf	
6050	6641.28	3749.82	BEND	28	6807.92	2866.26	Iron	68	7181.32	3989.92	Iron	115	6995.16	4339.75	brf	
6051	6619.24	3771.83	BEND	29	6604.66	2862.25	Iron	69	7105.23	3866.72	Iron	198	6794.88	4163.89	DISC BM	
6052	6619.21	3802.98	BEND	30	6603.80	2921.24	Iron	70	7222.04	4039.98	Iron	199	6752.47	4970.52	bm	
6053	6645.46	3829.27	BEND	31	6811.58	2619.17	Iron	71	7256.81	4121.02	Iron					
6054	6678.37	3829.30	BEND													

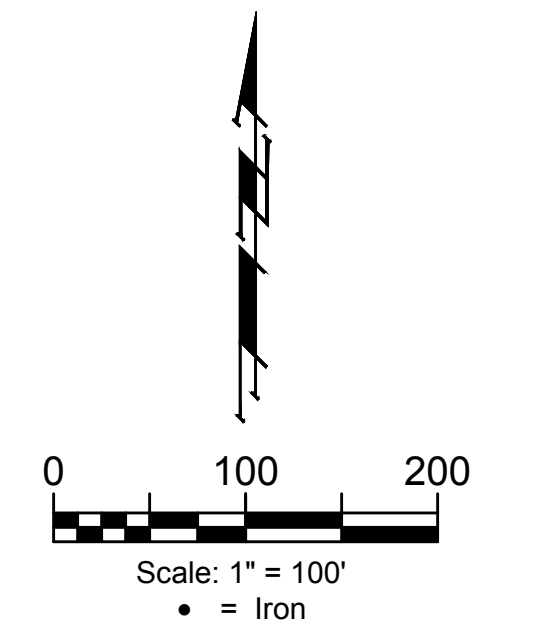

	Northgate 3rd Addition	
	<b>COORDINATES</b>	
Water Distribution System		
Baughman Company, P.A. 315 Ellis St. Wichita, KS 67211 P 316-262-7271 F 316-262-0149		
ENGINEERING   SURVEYING   PLANNING   LANDSCAPE ARCHITECTURE		
PROJECT NUMBER 448-2020-004499	DESIGN AEG	DRAWN JAK
REVISIONS:	APPROVED	DATE June 15, 2020
	SCALE Noted	SHEET <b>13 OF 14</b>