


RISER/MANHOLE COORDINATES		
POINT NAME	NORTHING	EASTING
MH-10	1736568	1606721
MH-11	1736638	1607715
MH-12	1736495	1608592
MH-13	1736087	1609504
R-21	1736389	1606156
R-22	1736515	1606530
R-23	1736605	1606914
R-24	1736647	1607307
R-25	1736638	1607702
R-26	1736616	1607986
R-27	1736528	1608483
R-28	1736398	1608856
R-29	1736230	1609213
R-30	1736055	1609567

RISER/MANHOLE COORDINATES AND TOE-DRAIN PIPE INVERT ELEVATIONS ARE BASED LIDAR TOPOGRAPHIC DATA AND MAY REQUIRE MINOR HORIZONTAL AND VERTICAL ADJUSTMENTS TO BE MADE IN THE FIELD. ANY FIELD CHANGES TO THE TOE-DRAIN ALIGNMENT OR PIPE INVERTS SHALL BE APPROVED BY THE CITY OF WICHITA'S STORMWATER ENGINEER.

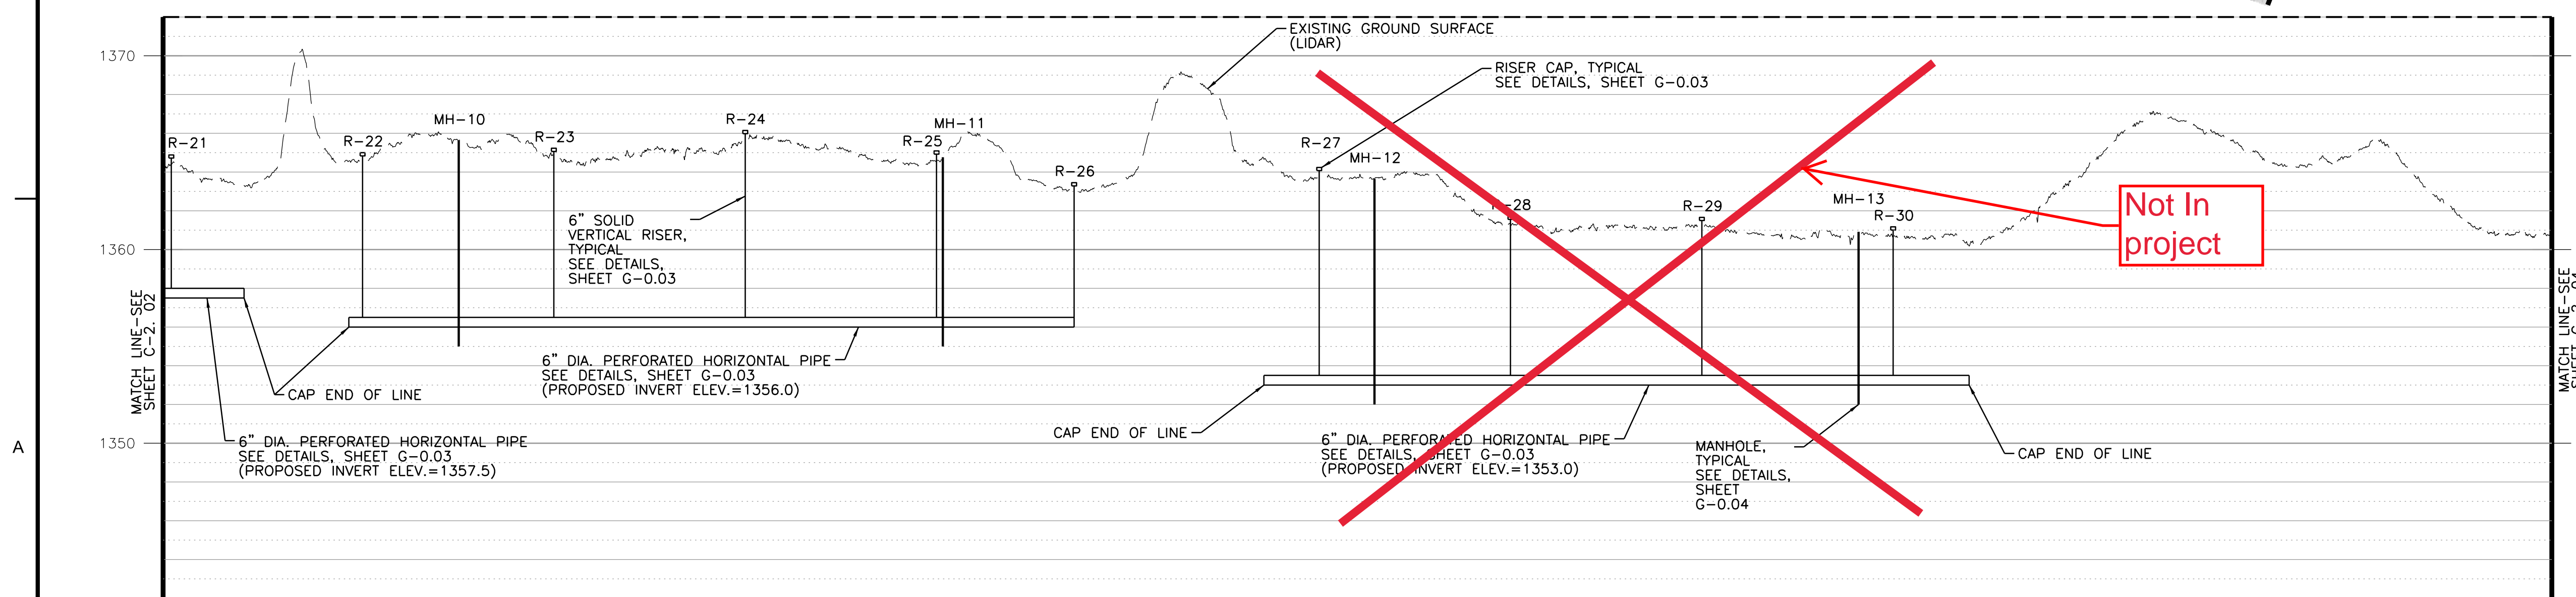

PROFILE SCALE (40:1 EXAGGERATION):
 HORIZONTAL: 1"=200'
 VERTICAL: 1"=5'

DATE	APPR
DESCRIPTION	MARK

amec
 AMEC Earth & Environmental, Inc.
 1129 SW Wisconsin
 Topeka, Kansas 66604
 Phone: (785) 272-6830
 Fax: (785) 272-6878



UPPER LEVEE TOE DRAIN INSTALLATION
 WICHITA-VALLEY CENTER LOCAL
 FLOOD PROTECTION PROJECT
 WICHITA, KANSAS

PREPARED FOR
 THE CITY OF WICHITA, KANSAS
 455 N. Main
 Wichita, KS 67202



DESIGNED BY: Larry Sample, PE	DATE: 08-13-2012
DWN BY: RES	CKD BY: LBK
APP BY: L. SAMPLE	
FILE NAME: 09_C-2.3.dgn	
AMEC PROJ. NO. 5-6150-0001	

LEVEE TOE DRAIN PLAN
 AND PROFILE
C-2.03
 SHEET 9 OF 24