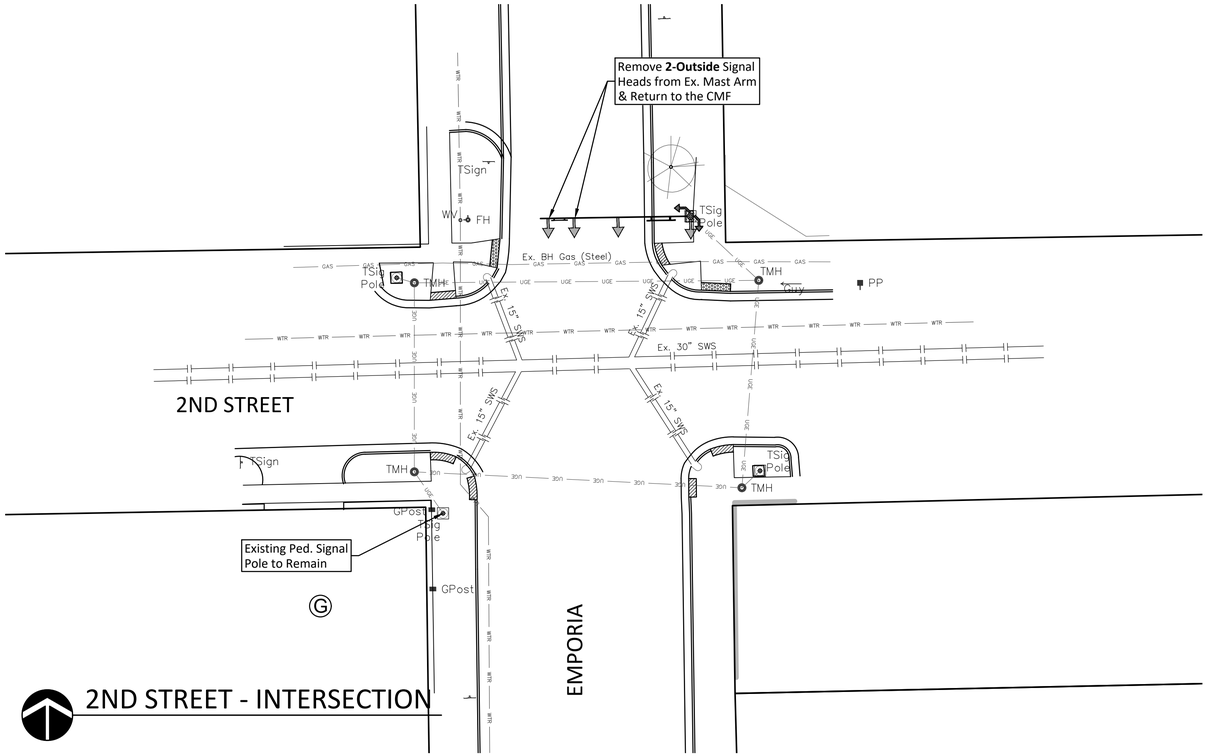

2ND STREET - INTERSECTION

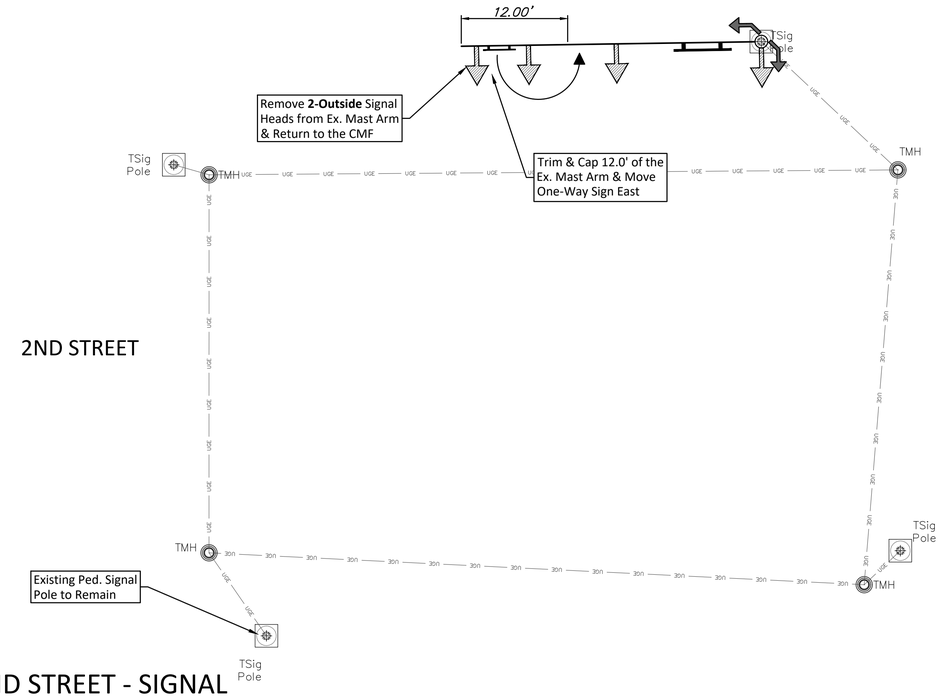

2ND STREET - SIGNAL

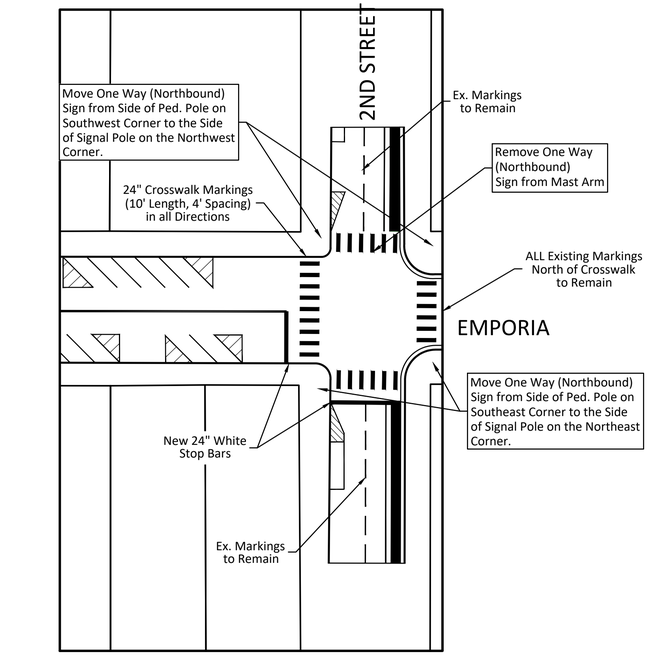

2ND STREET - MARKING & SIGNING REVISIONS

BID INFORMATION
IF the BASE BID and ADD ALTERNATE #1 are Accepted, **DISREGARD THIS SHEET**
IF ONLY the BASE BID is Accepted, **USE** Add Alternate #1 Modifications - **Sheet 16** for Changes to the Base Plans

MODIFICATIONS TO THE BASE PLAN
Pedestrian Signal Pole on Southwest Corner to Remain. Modifications to the Signal Heads on the North Mast Arm. See Revised Marking & Signing Plan for the 2nd Street Intersection. Omit Marking and Signing North of 2nd Street from the Base Plan

BAUGHMAN COMPANY
315 Ellis St. Wichita, KS 67211 316-262-7271
BaughmanCo.com

EMPORIA TWO-WAY CONVERSION
ADD ALTERNATE #1 MODIFICATIONS
CAPITAL IMPROVEMENT PROJECT

PROJECT NUMBER 472-085610
INTERNAL NUMBER 20-03-E546
DESIGN: LP
DRAWN: LP
DATE: Nov, 2020
SHEET 16 OF 16

File: K:\EMPORIA\20-03-E546\CAD\PLANS\PROJECT\20-03-E546_SHEET_16.DWG