

BENCHMARK:

BM #9 - City of Wichita Bench Mark Disc, 48.6' South and 32.4' West of Centerlines Hydraulic and Mac Arthur Sta. 168+35.3, 32.4' Rt. Elev. = 86.98 (City Datum)

CHRISTIAN ADDITION

JONH C. VAN VESSUM, II, et al
B - 12209

W.L. Sta. 0+00.00, Begin Line 8 =
B.L. Sta. 164+00.00, 29.95' Rt.
1 - 45° C.I.M.J. Bend (V)

W.L. Sta. 1+31.33, Line 8 =
B.L. Sta. 165+27.92, 33.54' Rt.
Install Fire Hydrant Assy (E)
L = 350' 6.5
Valve Box Elev. = 84.90
Bury Line Elev. = 85.60

16"x6" Tee
6"x12" V
2"x6" D.I.C.L. PIPE
2"x90° Bend (V)
22"x6" D.I.C.L. PIPE (V)
6"x90° Bend (V)
24"x6" D.I.C.L. PIPE


JOHN C II & DIANA M VAN VESSUM
B - 12207
Part of Lot 9

Contractor Shall Temporarily Replace All Roadway, Drive and Sidewalk Pavement as Necessary to Maintain Pedestrian and Vehicular Traffic Until Construction of Permanent Pavement is Complete.

W.L. Sta. 3+87.3, Line 8 =
B.L. Sta. 167+96.77, 32.70' Rt.
1 - 45° C.I.M.J. Bend (V)
Restrainer/Block as Necessary


JERRY & LINDA HANSEN
B - 12208
Part of Lot 9

CAUTION!
Ex. Gas S/L
Prop. Gas S/L
Crossings

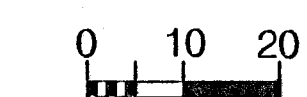

SCALE: 1" = 20'

Note:
Pavement, Sidewalks, and Etc. To Be Removed Are Indicated By:

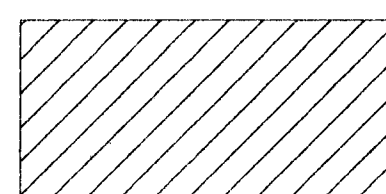

Note:
Trees/Shrubs to be removed are marked thus:



W.L. Sta. 0+07.42, Line 8 =
B.L. Sta. 164+04.10, 33.94' Rt.
1 - 45° C.I.M.J. Bend (V)
Block as Necessary
B.C. 164+15.0

B.L. Sta. 165+18.87, 34.37' Rt.
Remove Hydrant & Blocking
Remove 6" D.I.C.L. as Required.

PENTECOSTAL SECOND ADDITION

FIRST UNITED PENTECOSTAL CHURCH INC
C - 43602

CAUTION!
Proposed 18" SWS Crossing


2" V #20798
6"-2" PVC PIPE
2"x90° Bend (V)
3"x1"-2" PVC PIPE
2"x90° Bend
1 1/2" 8" PVC Coupling

W.L. Sta. 3+01.81, Line 8 =
B.L. Sta. 167+05.28, 32.98' Rt.
1 - 2" Service Outlet Assembly
Contractor Shall use Fittings and Pipe as Necessary to Match

T. J. OF KANSAS, Inc.
GLADYS MORRIS, et al
C - 116 - UP
Film 75, Page 993

W.L. Sta. 4+00.00, End Line 8 =
B.L. Sta. 168+00.00, 28.69' Rt. 16796
1 - 45° C.I.M.J. Bend (V)

MAC ARTHUR ROAD

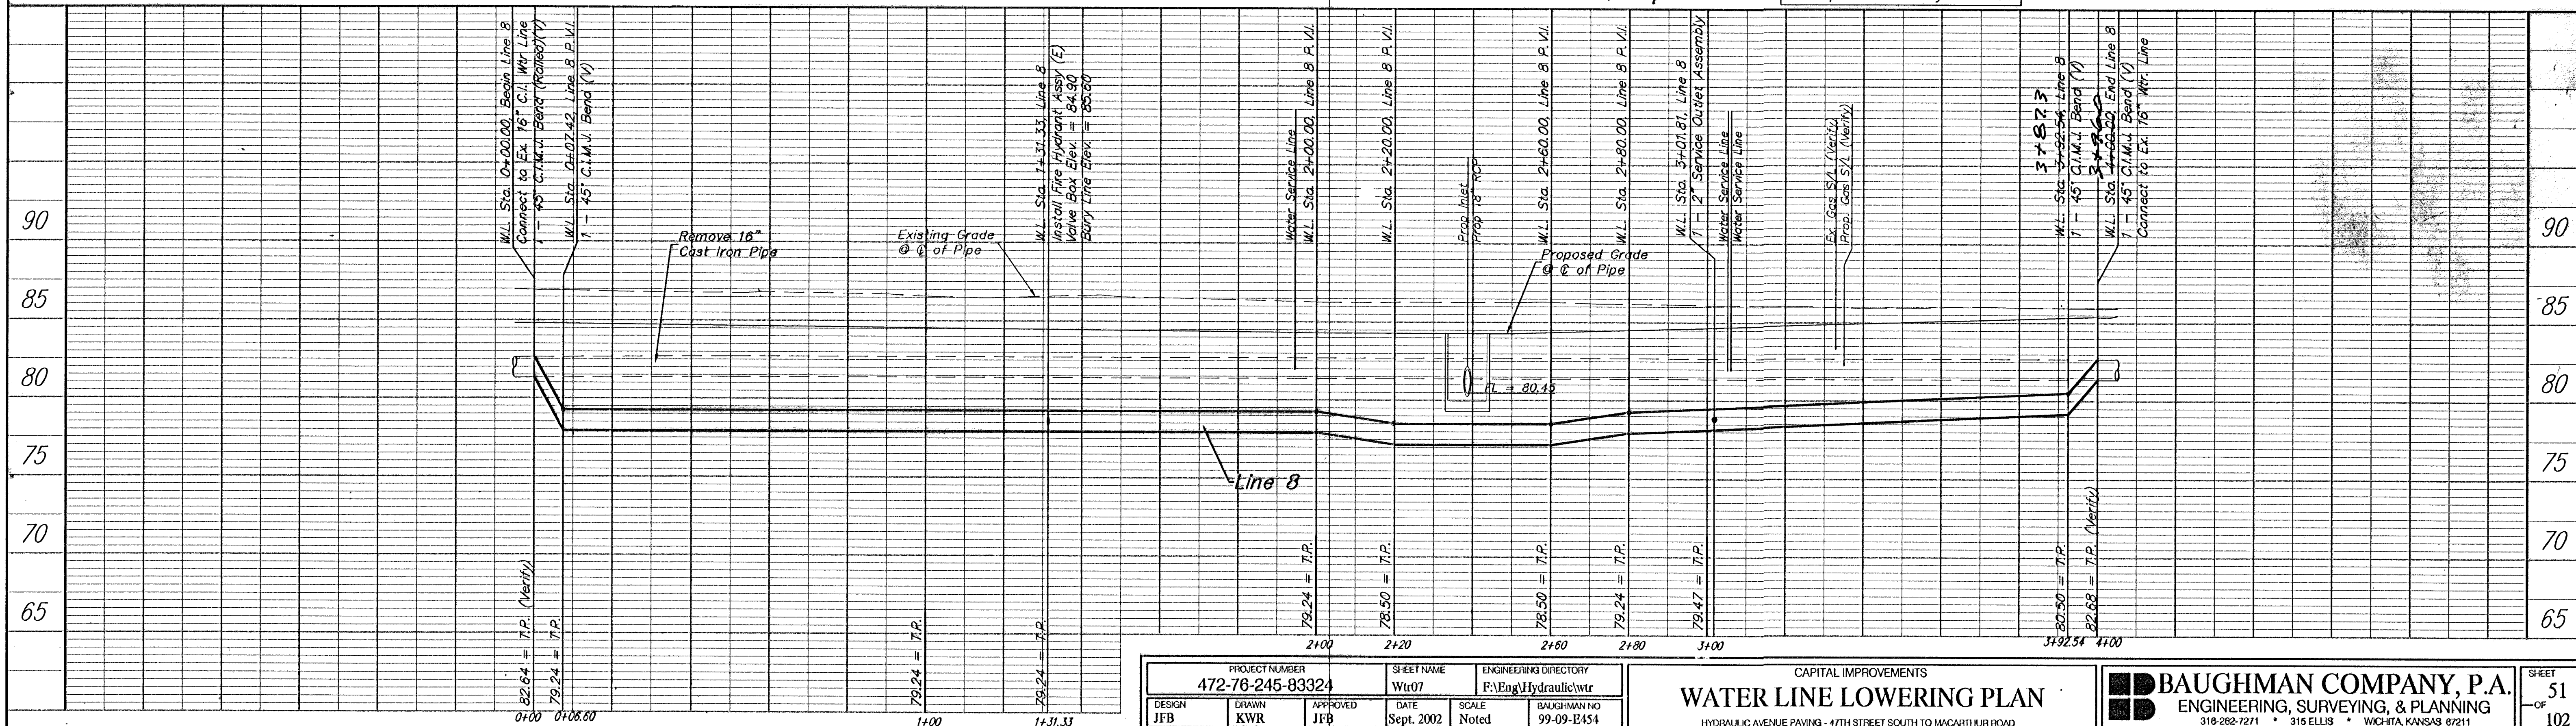

DESIGN	DRAWN	APPROVED	DATE	SCALE	BAUGHMAN NO
JFB	KWR	JFB	Sept. 2002	Noted	99-09-E454

WATER LINE LOWERING PLAN
HYDRAULIC AVENUE PAVING - 47TH STREET SOUTH TO MACARTHUR ROAD

BAUGHMAN COMPANY, P.A.
ENGINEERING, SURVEYING, & PLANNING
318-282-7271 • 315 ELLIS • WICHITA, KANSAS 67211

SHEET 51 OF 102