
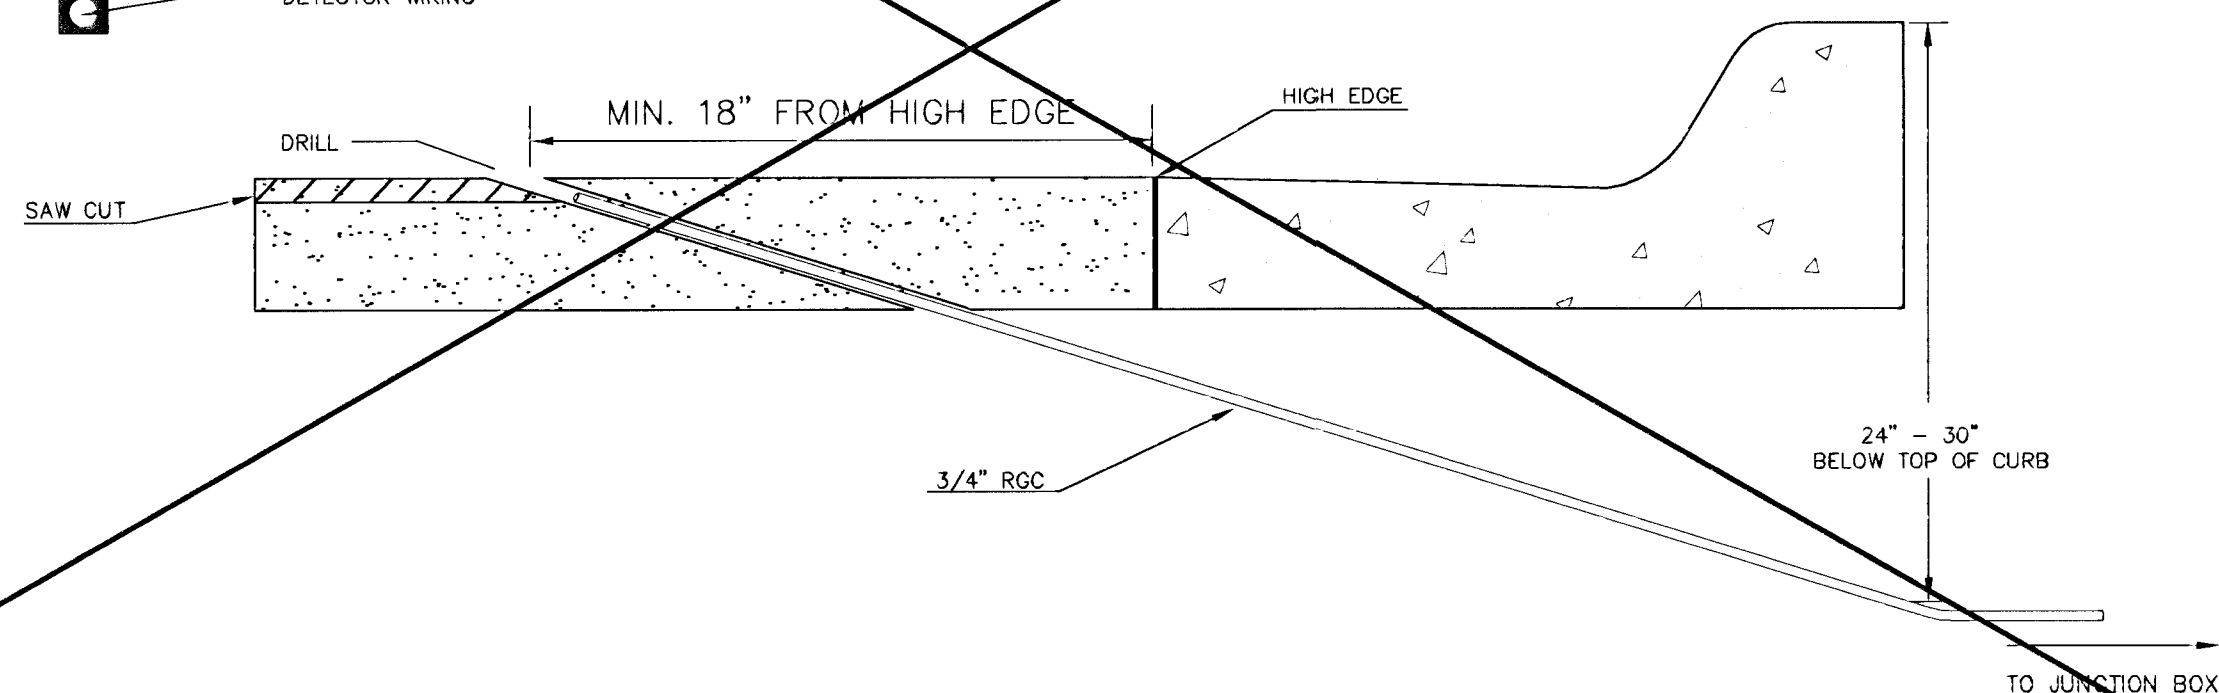
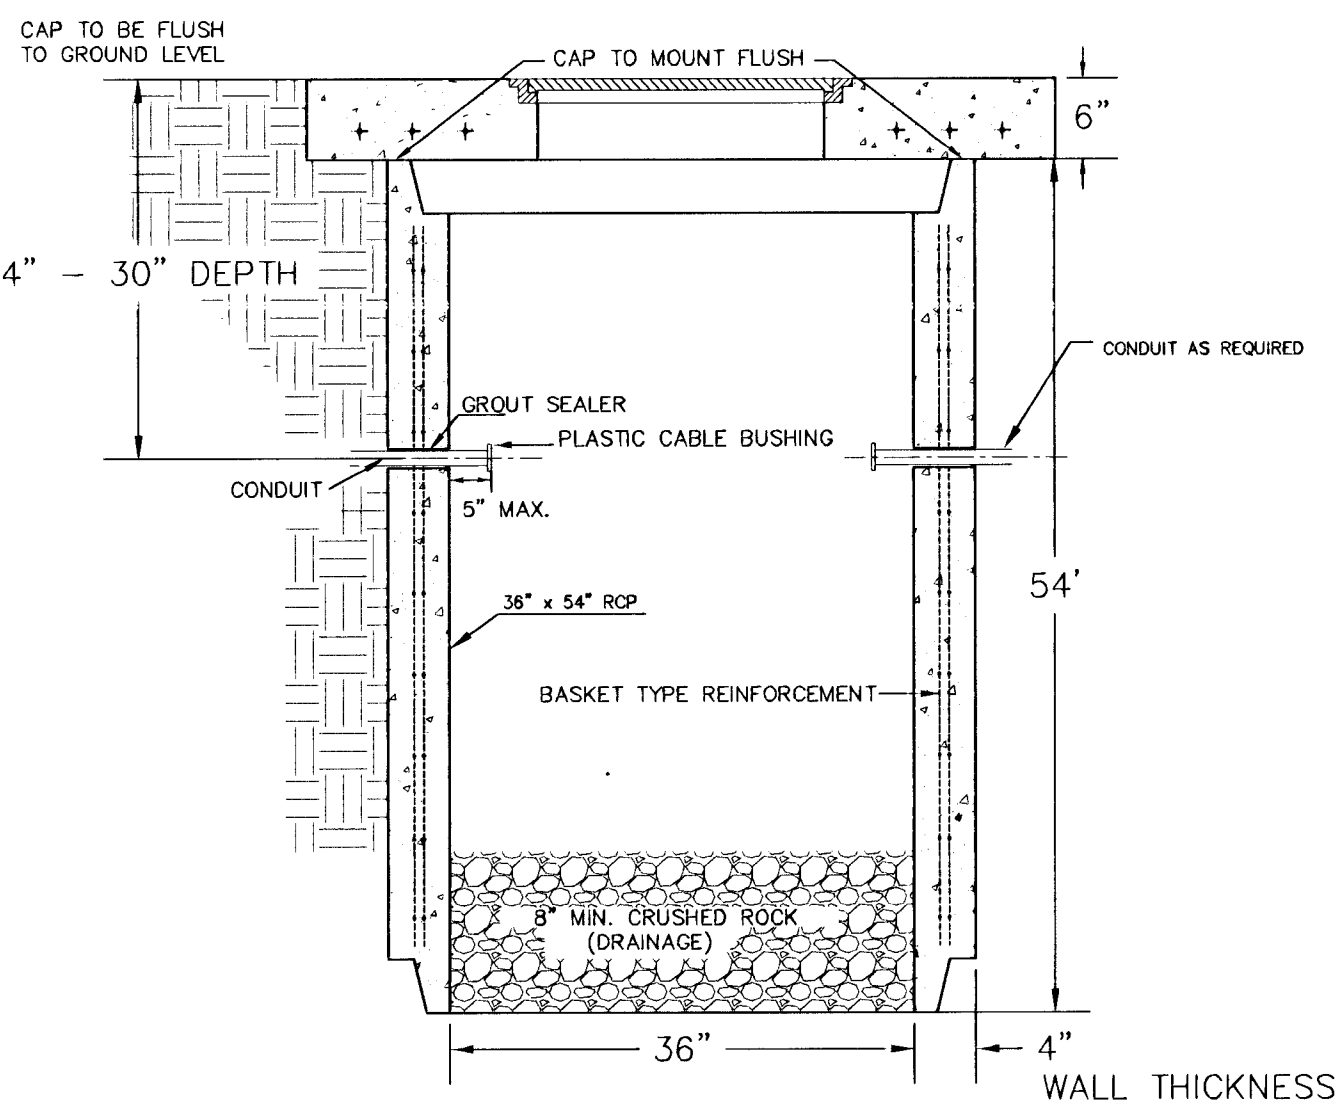
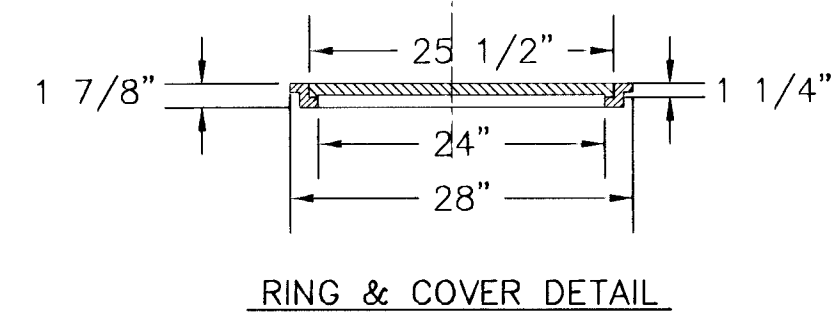


(36" I.D. X 54" RCP)
with 6" CAP

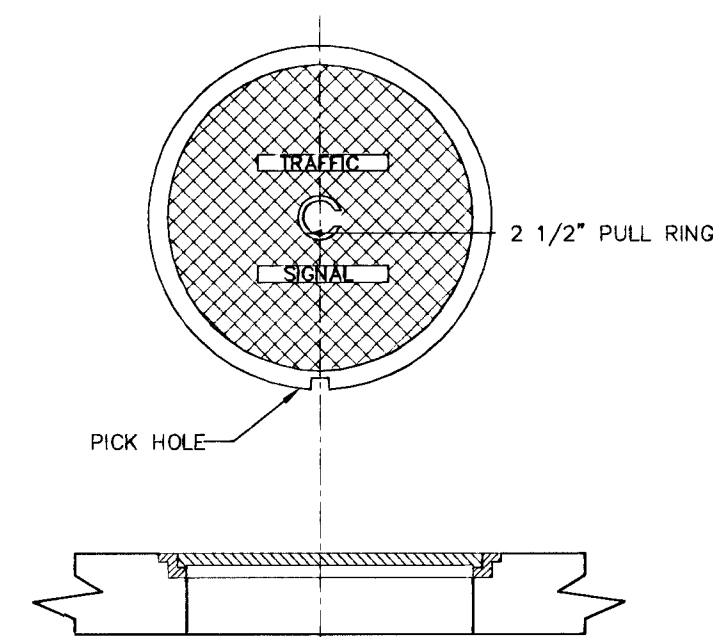

P.C.C. PAD FLUSH WITH UNPAVED AREAS, SIDEWALKS & PAVED AREAS.

PERMISSIBLE CONDUIT AREA
9"x16"



4"

16"

7"

9"

CABINET FRONT

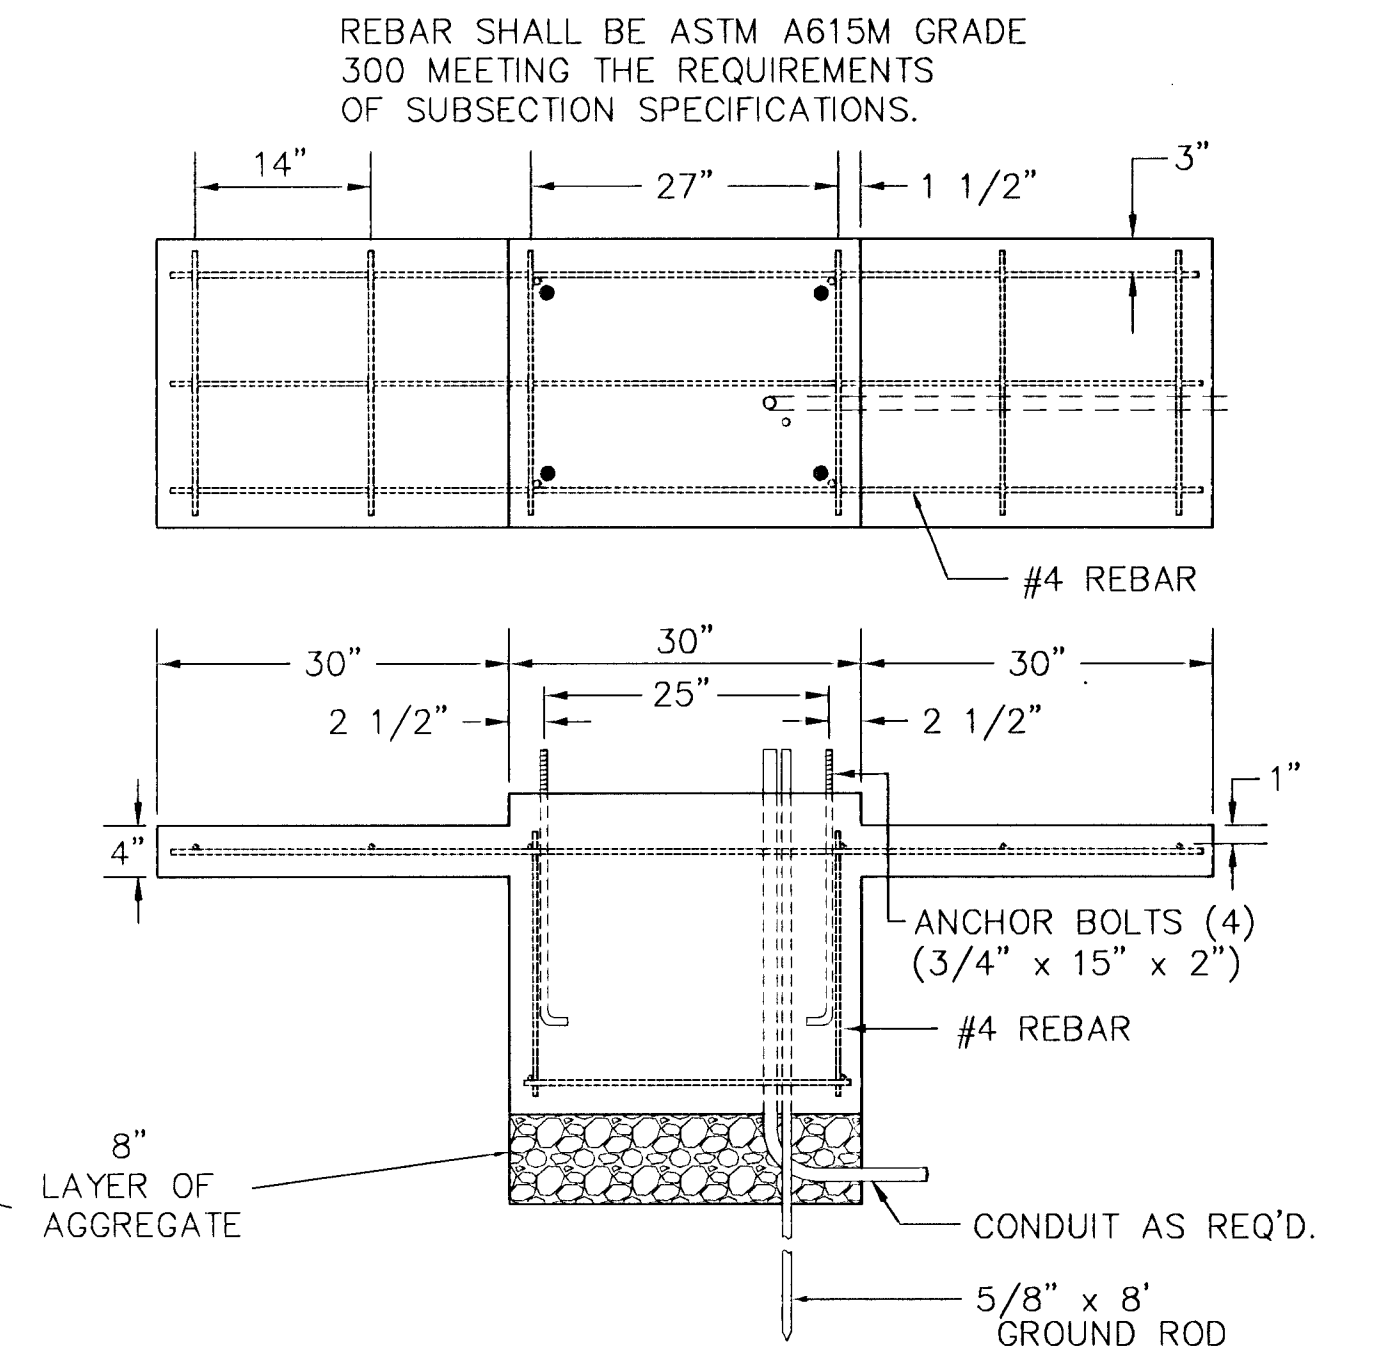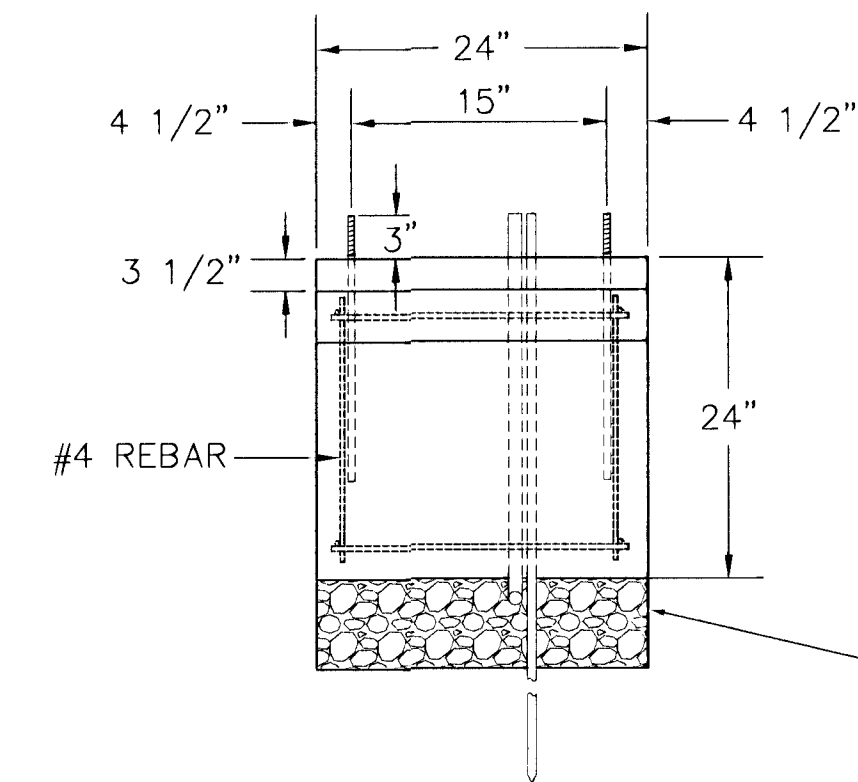

PRE-FAB Junction Box
(24" I.D. X 36" R.C.P.)

30"


24"

36"


6" ☐ Blockout
@ 90°

8" Minimum Crushed Rock

SECTION A-A

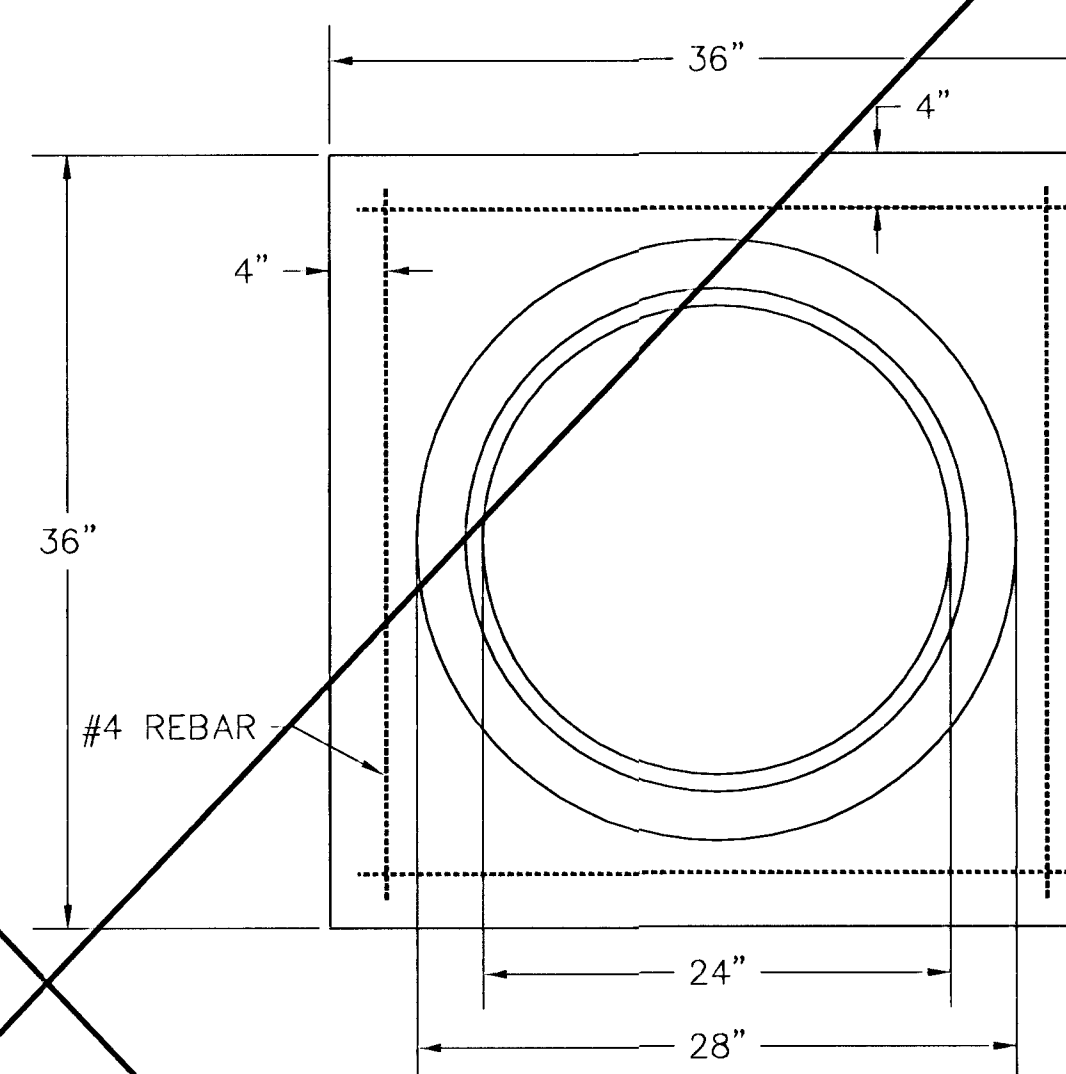

36" x 36" x 6"
TOP OF CAP TO BE FLUSH WITH
GROUND LEVEL.

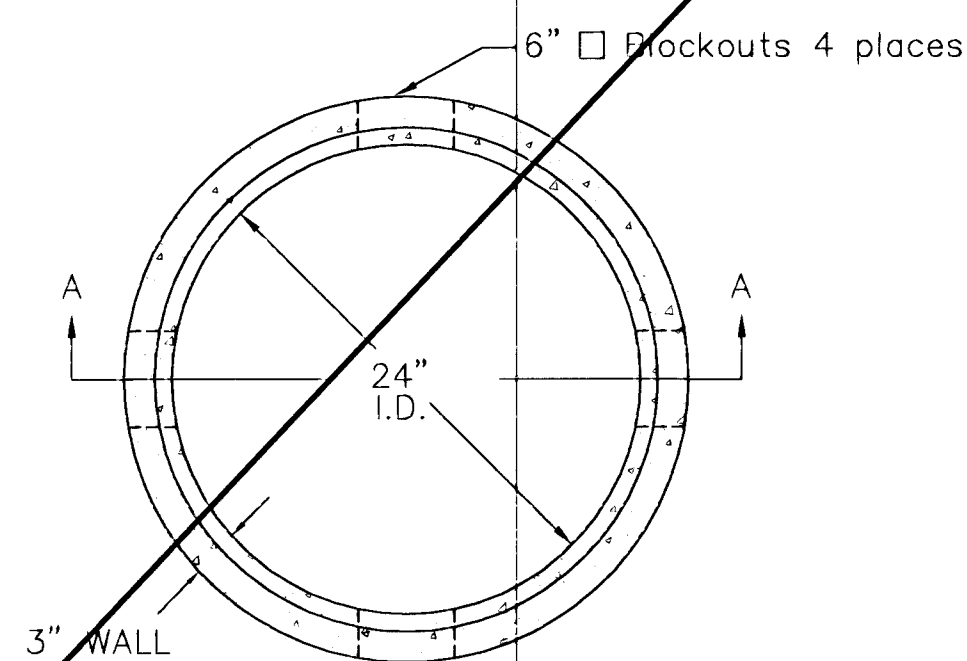

*SEE SERVICE BOX INSTALLATION
FOR RING & COVER DETAILS.

SERVICE & JUNCTION BOX:

1. CONDUIT CONNECTION TO BE FLUSH TO WITHIN 5" OF INSIDE FACE OF SIDE WALL, CONDUIT TO DRAIN INTO SERVICE BOX.
2. CONDUIT CONNECTIONS TO SERVICE BOX SHALL BE TERMINATED WITH PLASTIC CABLE BUSHING.
3. CONDUIT SHALL BE SEALED WITH APPROVED SEALER AT INSIDE WALL FACE.
4. ALL SERVICE & JUNCTION BOXES TO HAVE 8" OF CRUSHED ROCK.

TRENCHING:

1. DEPTH TO BE 30" MINIMUM WITH ROCK & STUBBLE FREE BACKFILL TO SERVE AS BEDDING MATERIAL. MAINTAIN MINIMUM CONDUIT DEPTH IN TRENCH.
2. BACKFILL TO BE COMPACTED IN 6" LOOSE LIFTS BY HAND OR MECHANICAL TAMPING TO A 95% STANDARD DENSITY.

CONDUIT:

1. SLOPE CONDUIT TO DRAIN AS DIRECTED BY THE ENGINEER.
2. 3" RIGID STEEL CONDUIT BTWN. SERVICE BOXES.

1 1/4"	"	"	"	BTWN. SERVICE & JUNCTION BOXES.
3/4"	"	"	"	BTWN. JUNCTION BOXES.
3/4"	"	"	"	BTWN. JUNCTION BOX & DETECTOR LOOP SAW CUT

[illegible]

1 2 83
