
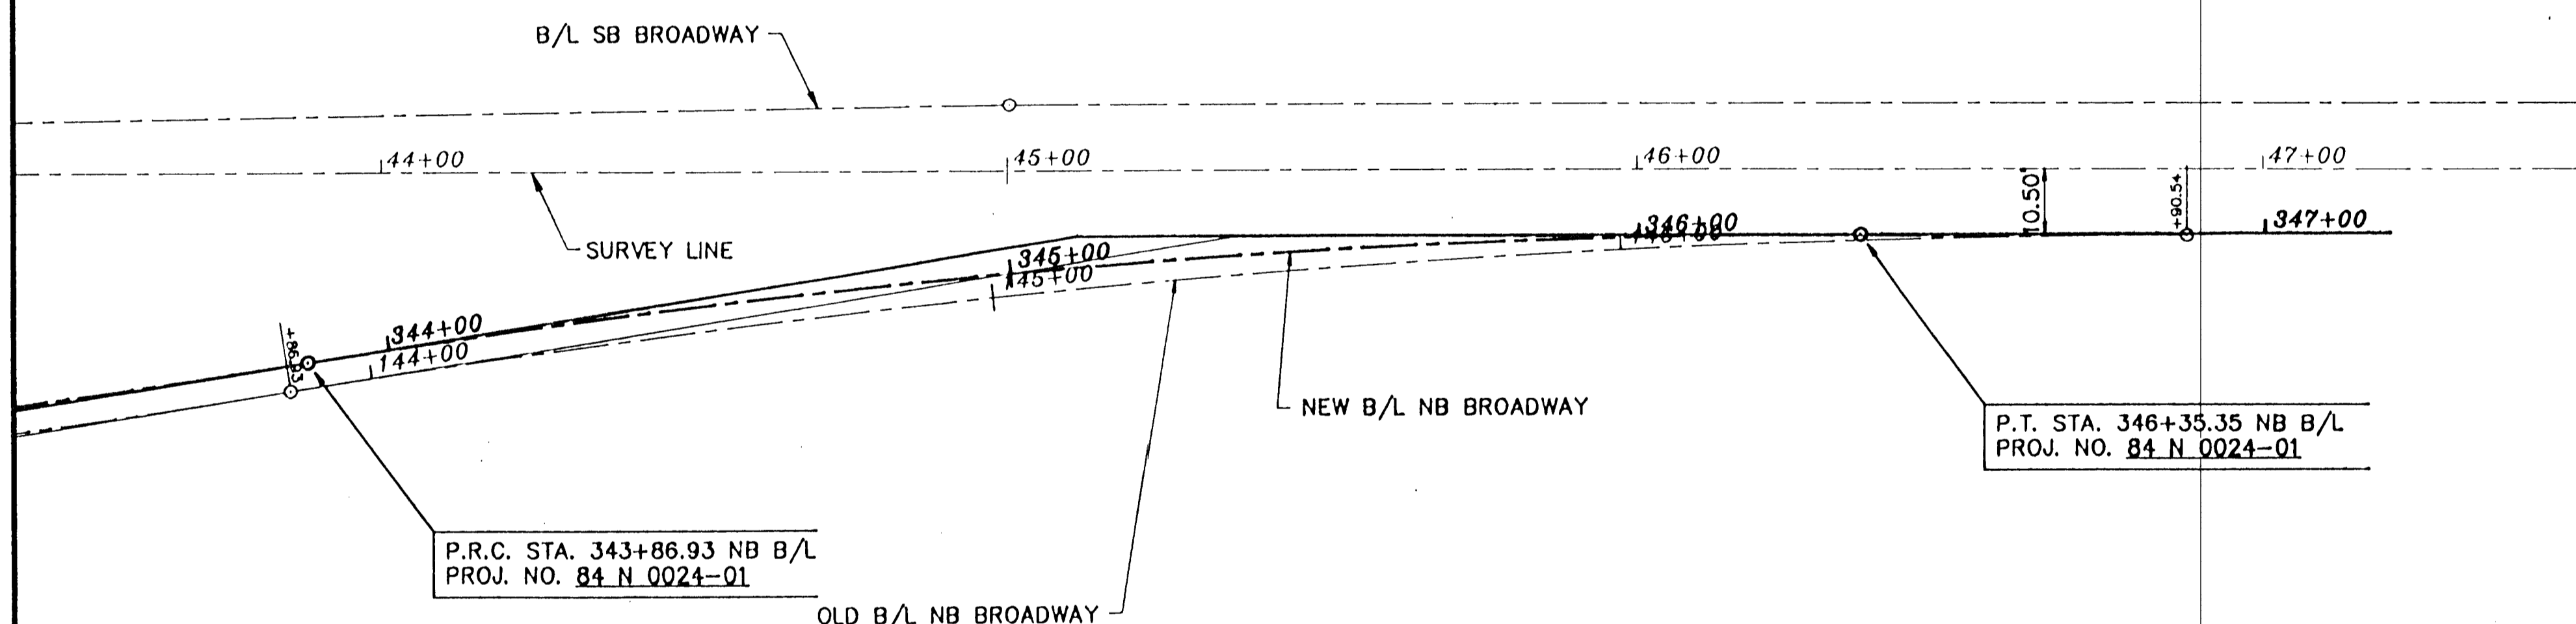
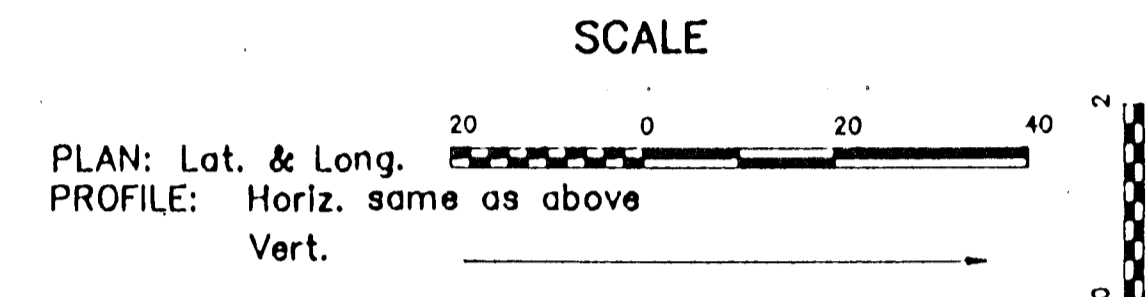


FHWA REGION NO.	STATE	PROJECT NO.	YEAR	SHEET NO.	TOTAL SHEETS
7	KANSAS	87 N 0024 - 01	1994	4	4

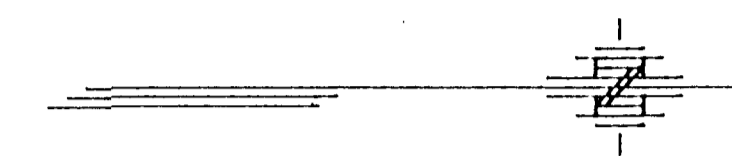

**CURVE DATA
NEW NB BROADWAY**

P.I. STA. 345+11.14 =
10.50' RT. STA. 45+11.23 SURVEY LINE
Δ = 9°05'28.8" LT.
D = 3°39'34.8"
R = 1565.60'
T = 124.47'
L = 248.42'
E = 4.94'

RE-ALIGNMENT	
GARBER SURVEYING SERVICE, P.A. 423 WEST FIRST AVENUE HUTCHINSON, KANSAS 67601 PH 316-685-7032 Fax 316-685-7401	
BROADWAY PLAN STA. 343+00 to STA. 347+00	
Drawn By: RDB	Checked By: DEC
Scale: 1"=20'	Job No.: C95-143
Date: 05/23/1995	Sheet 4 of 4 Sheets