BENCHMARKS:

#1 Top of 1/2" Iron in 6"x6" Box Located At the NE Cor., NE 1/4 Sec. 25, Twp. 27-S, R-2-W ELEV. = 141.03 CITY DATUM

#2 RR Spike in Guypole Located 9.28' E & 52.92' S of the SE Cor. of Reserve "A". ELEV. = 128.92 CITY DATUM

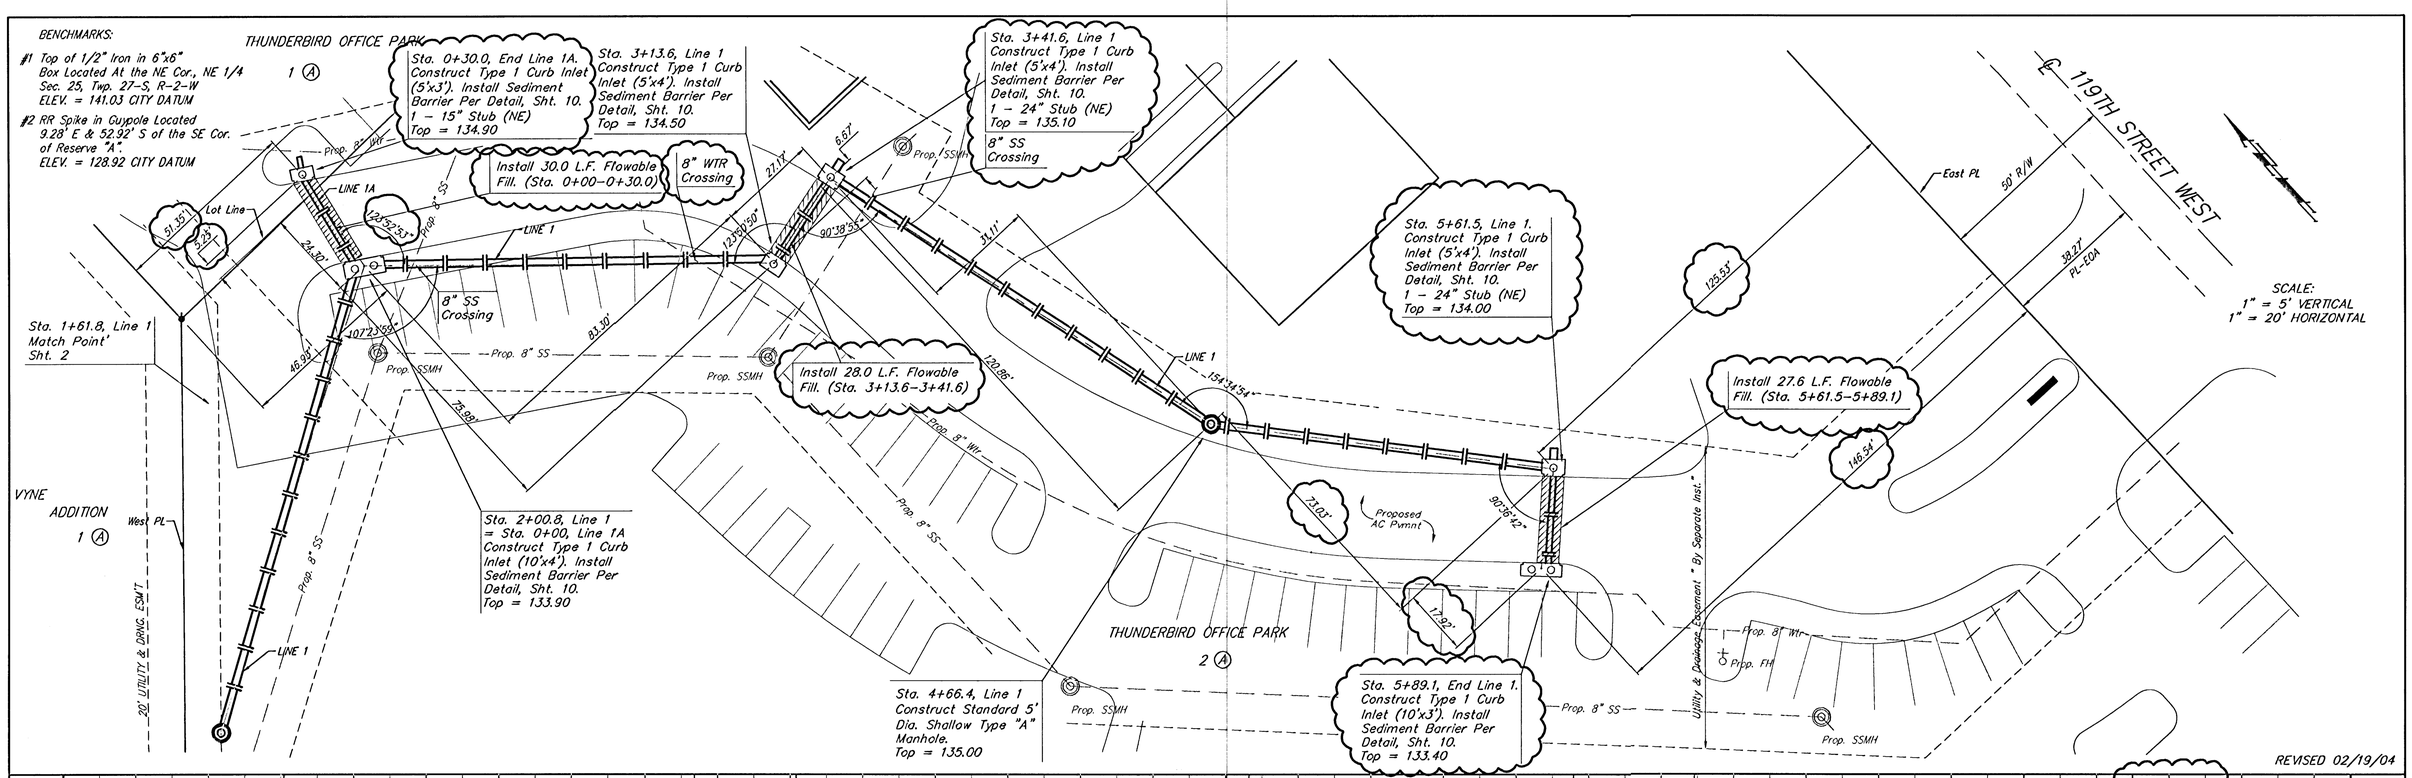

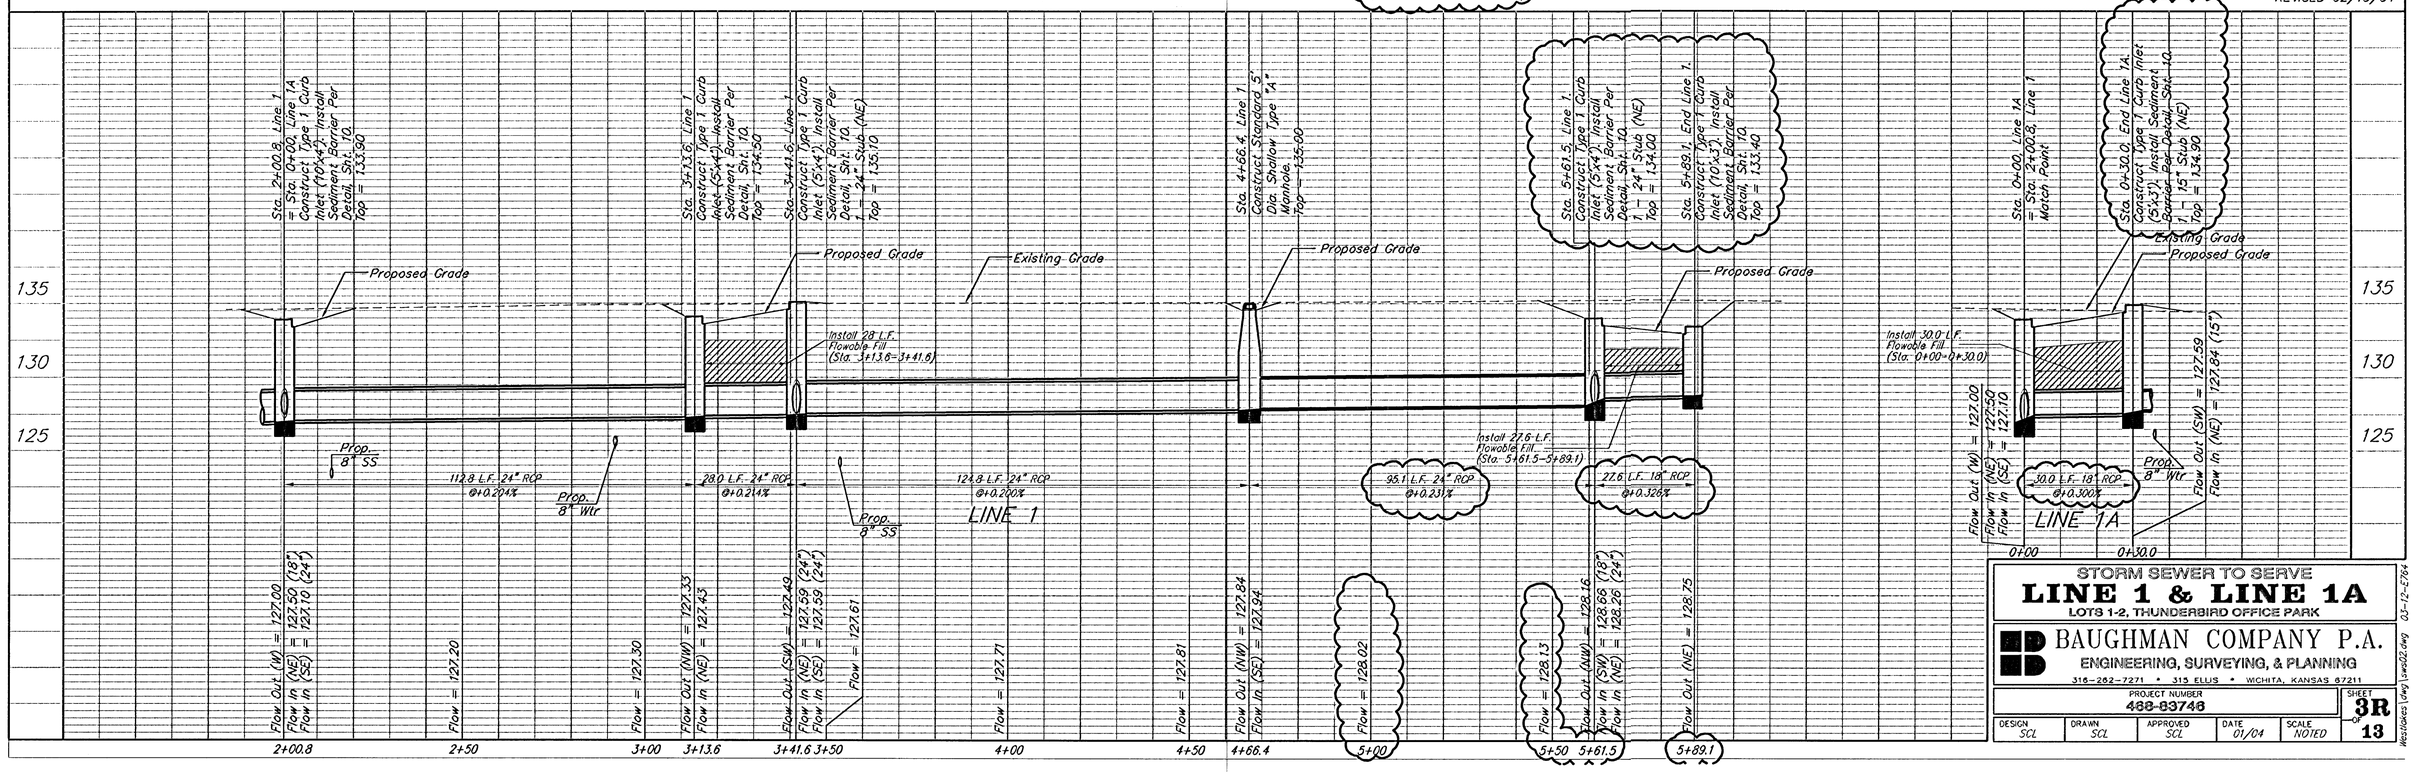

STORM SEWER TO SERVE

LINE 1 & LINE 1A

LOTS 1-2, THUNDERBIRD OFFICE PARK

BAUGHMAN COMPANY P.A.

ENGINEERING, SURVEYING, & PLANNING

316-262-7271 • 315 ELLIS • WICHITA, KANSAS 67211

PROJECT NUMBER	SHEET
488-83746	3R of 13

DESIGN	DRAWN	APPROVED	DATE	SCALE
SCL	SCL	SCL	01/04	NOTED

03-12-2764

Westlakes\dwg\sewer02.dwg