


DATE	
BY	
FINAL SURVEY PLOTTED	
NOTE BOOK	
AREAS CHECKED	

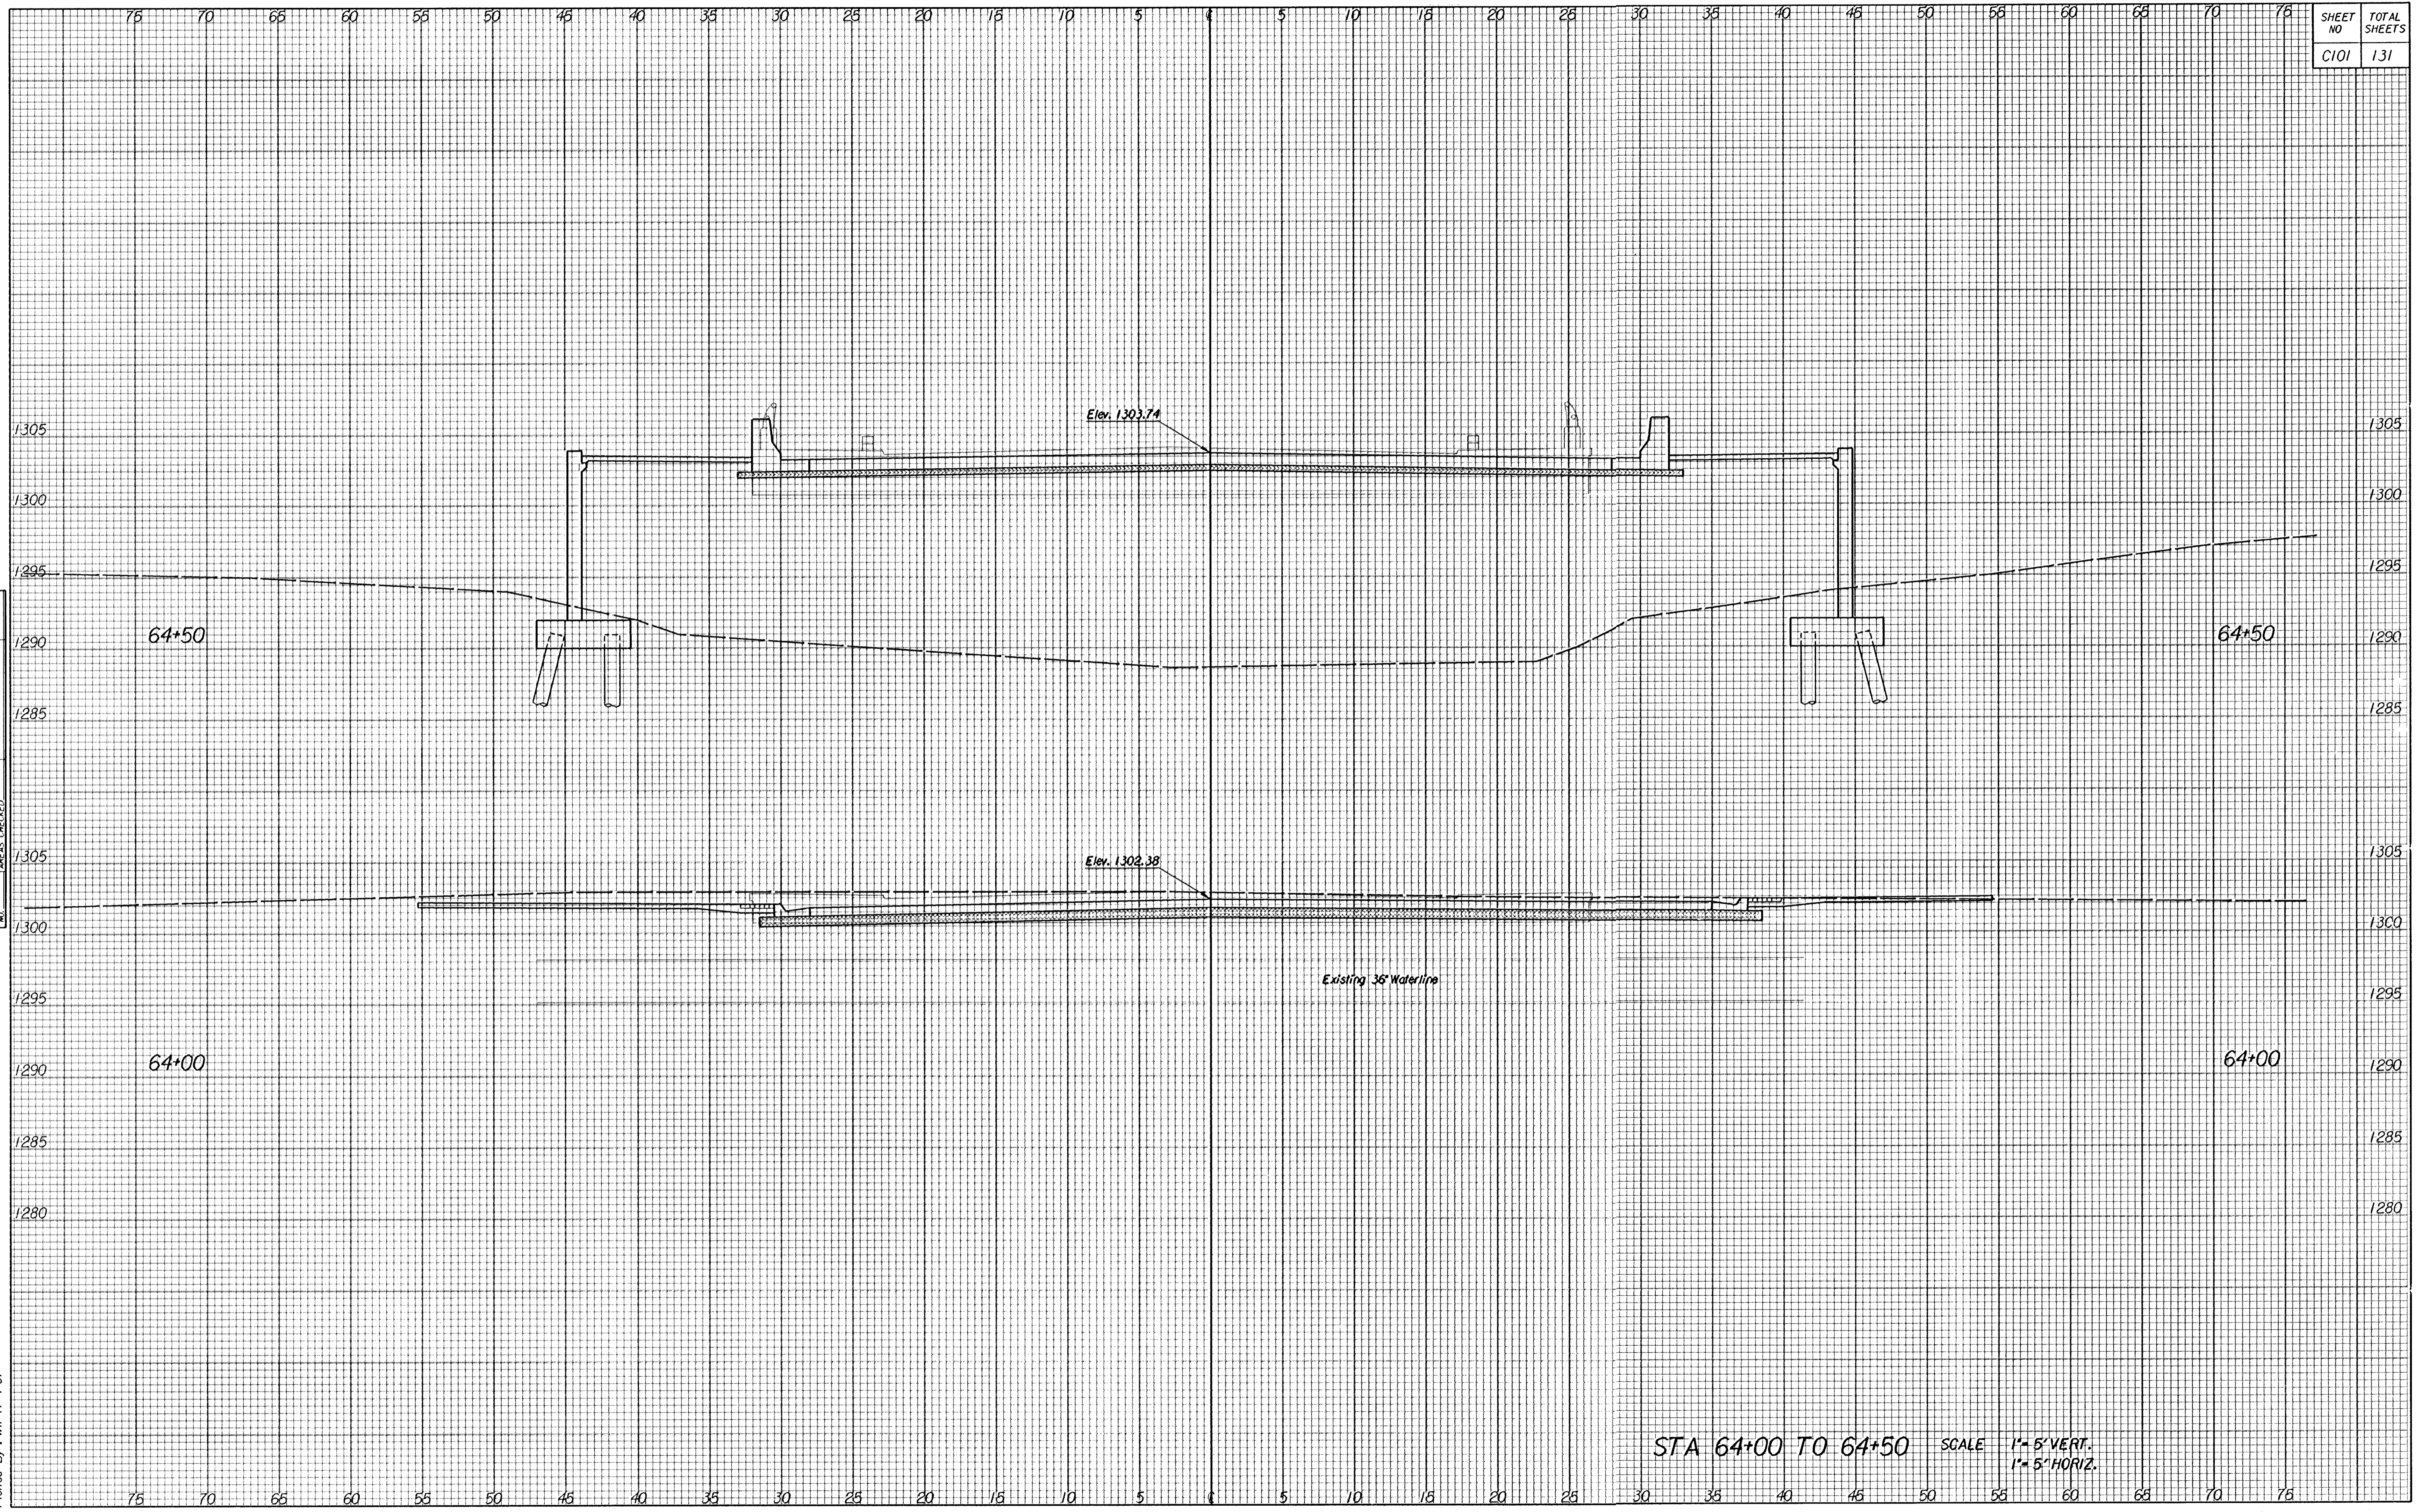

Drawing Name : I:\1995\95088\douglas\drsec.dgn
 Plotted By : wil 11-4-97

STA 64+00 TO 64+50 SCALE 1" = 5' VERT.
 1" = 5' HORIZ.