FEEDER SCHEDULE

(THIS SHEET ONLY)

FEEDER IDENT.	CONDUCTORS			GROUND SIZE	ISOLATED GROUND SIZE	CONDUIT SIZE
	SETS	QUANT. PER SET	SIZE	PER SET		PER SET
1	1	4	#10	#10	--	3/4"
2	1	3	#10	#10	--	3/4"
3	1	2	#10	#10	--	3/4"

NOTE: FEEDERS ARE LISTED ON THE BASIS OF USING METALLIC CONDUITS IF P.V.C. IS USED FOR UNDERGROUND FEEDERS, AN EQUIPMENT GROUND CONDUCTOR SIZED PER N.E.C. MUST BE ROUTED IN CONDUIT WITH CIRCUIT CONDUCTORS. CONDUIT SIZE AS LISTED MUST BE INCREASED AS REQUIRED.

PLAN NOTES,

1. REFER TO RELATED DRAWINGS FOR ALL CONTROL AND DISTRIBUTION REQUIREMENTS, AND ALL LIGHT FIXTURES AND BASES.

2. ALL CONDUCTORS TO BE CLEARLY AND PERMANENTLY MARKED AT ALL ENDS AND JUNCTION POINTS WITH PANEL DESIGNATION AND CIRCUIT NUMBER.

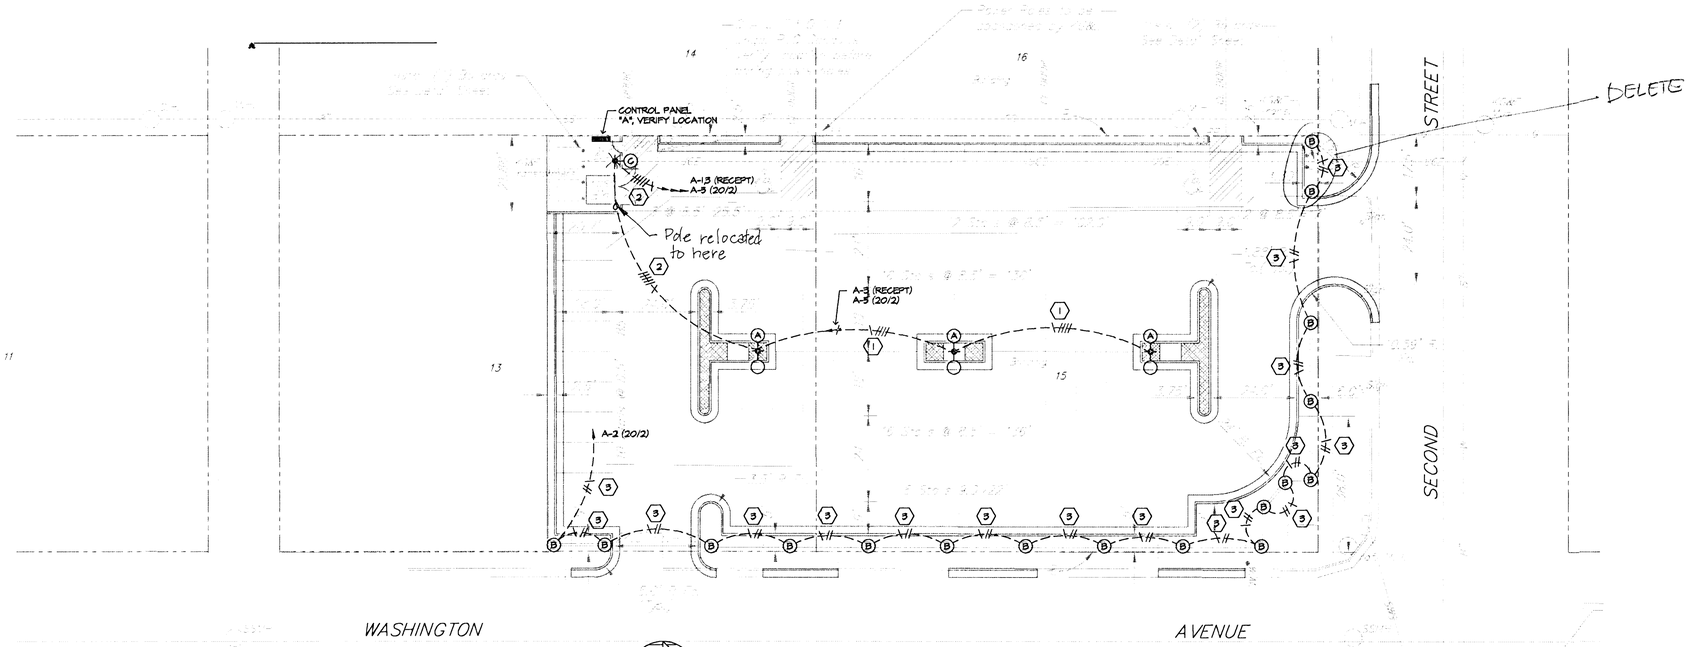

NORTH

LIGHTING FOR PARKING LOT #10

SCALE: 1" = 20' - 0"

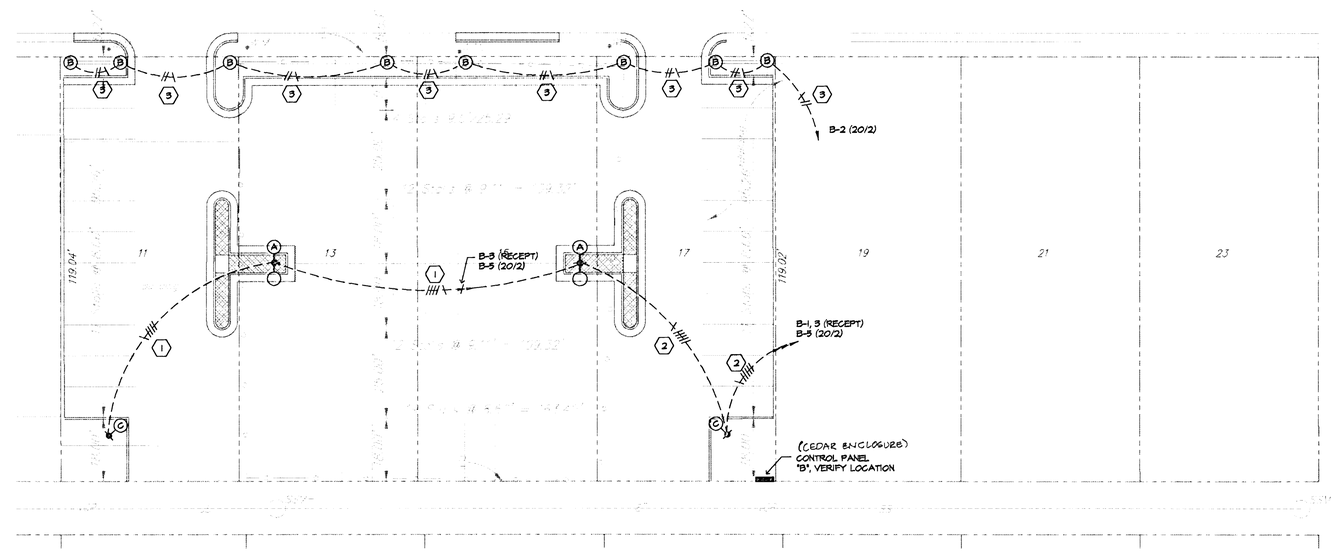

NORTH

LIGHTING FOR PARKING LOT #9

SCALE: 1" = 20' - 0"

PHILIP JOHN VOEGELI
11701
2-18-94
KANSAS
PROFESSIONAL ENGINEER

Stefan, Voegeli & Associates Inc.

Electrical Engineering and Design

626 N. Broadway, Suite B
Wichita, Ks. 67214-3587
(316) 264-3081
FAX: (316) 264-3542

RECORD COPY - REVISED 7-11-94

OLD TOWN PARKING LOTS

LOTS #9 AND #10

SRB 841 SOUTH HILLSIDE WICHITA KANSAS 67211 316-652-7754 FAX 652-7932

SAVOY, RUGGLES & BOHM, P.A.
ENGINEERING & SURVEYING

PROJECT NUMBER

DRAWN	DESIGN	REVIEW	DATE	UTILITY	SRB JOB
SVA	SVA	SVA	2/18/94		113E

REVISED

DWG. FILE 4023E03

9

14

S.V.A. DWG. NAME: D:\SHADY\WEIGEL\ DATE: 02/18/94 TIME: 07:45