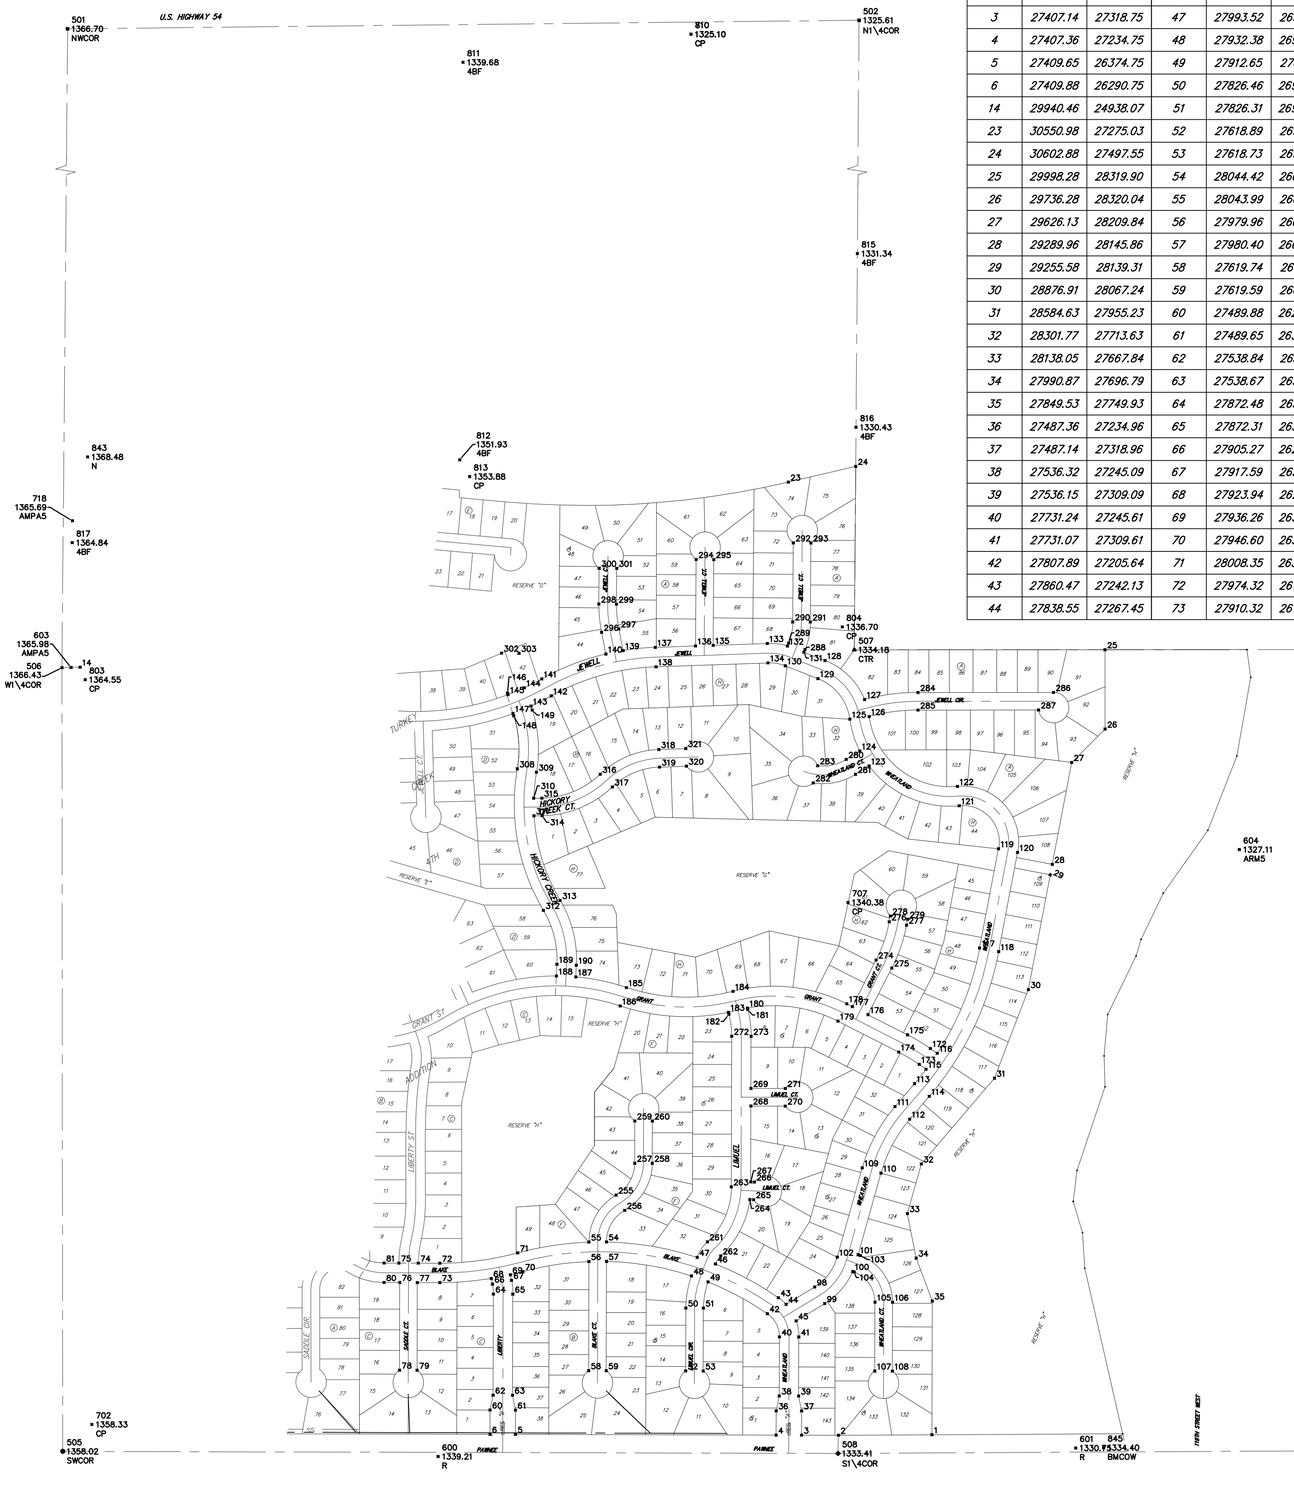

Irons			Irons			Irons			Irons			Irons			Irons		
Point #	Northing	Easting	Point #	Northing	Easting	Point #	Northing	Easting	Point #	Northing	Easting	Point #	Northing	Easting	Point #	Northing	Easting
1	27408.50	27748.76	45	27783.83	27300.63	74	27974.51	26054.26	119	29341.60	27968.38	148	29779.67	26369.20	263	28226.23	27086.93
2	27406.82	27440.43	46	27971.75	27034.69	75	27974.68	25990.26	120	29329.63	28031.25	149	29798.99	26430.21	264	28184.46	27148.05
3	27407.14	27318.75	47	27993.52	26974.51	76	27910.67	25993.09	121	29483.48	27838.97	172	28682.56	27743.43	265	28183.92	27160.57
4	27407.36	27234.75	48	27932.38	26955.58	77	27910.52	26051.09	122	29547.18	27832.83	173	28630.13	27706.74	266	28241.87	27163.07
5	27409.65	26374.75	49	27912.65	27010.12	78	27621.40	25992.32	123	29614.81	27541.44	174	28670.71	27639.23	267	28242.39	27150.98
6	27409.88	26290.75	50	27826.46	26936.87	79	27621.25	26050.32	124	29664.08	27510.84	175	28727.71	27668.32	268	28492.93	27151.65
14	29940.46	24938.07	51	27826.31	26994.87	80	27910.81	25941.20	125	29769.11	27478.13	176	28794.24	27537.95	269	28550.93	27151.80
23	30550.98	27275.03	52	27618.89	26936.31	81	27974.81	25941.37	126	29777.75	27541.54	177	28820.60	27486.29	270	28492.63	27264.97
24	30602.88	27497.55	53	27618.73	26994.31	98	27895.80	27361.86	127	29833.79	27526.59	178	28830.02	27467.83	271	28550.63	27265.12
25	29998.28	28319.90	54	28044.42	26675.13	99	27841.08	27395.04	128	29962.51	27396.10	179	28773.01	27438.74	272	28722.89	27088.26
26	29736.28	28320.04	55	28043.99	26617.13	100	27947.00	27487.52	129	29902.90	27372.81	180	28816.15	27139.85	273	28722.72	27152.26
27	29626.13	28209.84	56	27979.96	26617.28	101	28002.30	27505.25	130	29945.04	27264.97	181	28811.50	27141.06	274	28974.39	27564.77
28	29289.96	28145.86	57	27980.40	26675.28	102	27994.20	27436.53	131	29989.72	27326.45	182	28795.44	27079.11	275	28948.02	27616.43
29	29255.58	28139.31	58	27619.74	26616.31	103	27999.52	27512.64	132	30010.18	27272.18	183	28801.88	27077.44	276	29100.40	27607.92
30	28876.91	28067.24	59	27619.59	26674.31	104	27945.24	27492.20	133	30018.71	27205.67	184	28871.14	27092.55	277	29089.56	27664.90
31	28584.63	27955.23	60	27489.88	26290.97	105	27845.66	27560.92	134	29954.75	27207.91	185	28883.51	26740.78	278	29119.78	27611.61
32	28301.77	27713.63	61	27489.65	26374.97	106	27845.51	27618.92	135	30012.44	27026.92	186	28822.84	26720.40	279	29108.93	27668.59
33	28138.05	27667.84	62	27538.84	26301.10	107	27618.44	27560.31	136	30010.40	26968.90	187	28918.61	26573.78	280	29636.22	27465.99
34	27990.87	27696.79	63	27538.67	26365.10	108	27618.29	27618.31	137	30005.74	26836.22	188	28921.58	26509.85	281	29586.95	27496.59
35	27849.53	27749.93	64	27872.48	26301.99	109	28288.87	27518.96	138	29941.78	26838.46	189	28960.37	26511.65	282	29558.73	27357.16
36	27487.36	27234.96	65	27872.31	26365.99	110	28271.63	27580.59	139	29995.19	26730.15	190	28957.39	26575.59	283	29615.24	27371.91
37	27487.14	27318.96	66	27905.27	26298.85	111	28491.08	27626.77	140	29983.77	26673.28	255	28199.15	26706.79	284	29856.96	27702.88
38	27536.32	27245.09	67	27917.59	26361.65	112	28449.51	27675.43	141	29901.66	26461.55	256	28148.68	26735.38	285	29798.96	27702.91
39	27536.15	27309.09	68	27923.94	26295.18	113	28566.50	27691.19	142	29845.70	26492.61	257	28304.10	26768.14	286	29857.19	28149.97
40	27731.24	27245.61	69	27936.26	26357.99	114	28524.94	27739.86	143	29812.19	26426.03	258	28303.95	26826.14	287	29799.17	28100.65
41	27731.07	27309.61	70	27946.60	26399.29	115	28614.25	27729.43	144	29872.41	26403.82	259	28443.54	26768.51	288	29999.04	27330.09
42	27807.89	27205.64	71	28008.35	26382.47	116	28666.68	27766.12	145	29849.89	26350.15	260	28443.38	26826.51	289	30020.15	27276.07
43	27860.47	27242.13	72	27974.32	26125.45	117	29014.19	27906.06	146	29854.90	26348.53	261	28044.78	27008.20	290	30090.08	27289.53
44	27838.55	27267.45	73	27910.32	26125.28	118	29002.23	27968.93	147	29787.72	26366.65	262	27998.16	27052.05	291	30089.62	27347.53

Irons		
Point #	Northing	Easting
292	30350.68	27291.57
293	30350.23	27349.57
294	30295.97	26971.13
295	30295.52	27029.13
296	30055.49	26658.88
297	30066.91	26715.75
298	30148.83	26649.97
299	30148.38	26707.97
300	30266.87	26650.90
301	30266.41	26708.89
302	29986.68	26328.69
303	29986.23	26386.69
308	29605.20	26380.86
309	29594.18	26443.90
310	29508.17	26435.00
311	29450.18	26435.80
312	29138.16	26467.05
313	29170.97	26522.01
314	29450.55	26462.89
315	29508.55	26462.09
316	29587.30	26654.47
317	29545.39	26694.56
318	29668.95	26848.04
319	29610.99	26850.08
320	29614.10	26938.84
321	29672.07	26936.81

Control Points			
Point #	Northing	Easting	Desc.
501	32584.25	24901.96	NWCOR
502	32612.53	27513.28	N1\4COR
503	29999.21	30061.99	E1\4COR
504	27360.78	29997.18	SECOR
505	27353.64	24880.59	SWCOR
506	29939.11	24878.07	W1\4COR
507	29997.85	27492.82	CTR
508	27346.81	27439.22	S1\4COR
600	27336.68	26119.57	R
601	27364.65	28223.19	R
602	29803.90	30075.28	N
603	29939.45	24908.10	AMPA5
604	29338.88	28762.95	ARM5
606	29999.06	30022.07	ARM5
607	29751.25	29799.36	N
702	27442.50	24976.73	CP
707	29164.34	27472.03	CP
710	32566.65	26958.64	CP
718	30423.52	24912.64	AMPA5
801	27376.51	29966.08	PK

Control Points			
Point #	Northing	Easting	Desc.
803	29899.34	24954.88	CP
804	30073.40	27453.20	CP
810	32566.64	26958.64	CP
811	32473.94	26206.49	4BF
812	30624.50	26190.89	4BF
813	30569.47	26223.82	CP
815	31305.15	27502.90	4BF
816	30731.98	27498.38	4BF
817	30351.39	24911.86	4BF
822	27390.46	30036.25	BMCOW
843	30634.08	24962.62	N
845	27365.81	28315.31	BMCOW

Scale: 1" = 250'

250 0 250

- = #4 REBAR W/ "BAUGHMAN" CAP (SET)
- = BOLT OVER STONE (FOUND)
- = 1/2" IRON IN THIMBLE (FOUND)
- = 1" IRON IN BROKEN STONE (FOUND)
- = #5 REBAR IN THIMBLE (FOUND)
- = 1" SQUARE PIN OVER STONE (FOUND)
- = 3/4" IRON (FOUND)
- = 1/2" IRON (FOUND)

BAUGHMAN COMPANY
315 Ellis St.
Wichita, KS 67211
316-262-7271
BaughmanCo.com

TURKEY CREEK 3RD ADDITION
PHASE 4

Coordinate **Sheet**

Street Paving Imporvements

PROJECT NUMBER: 472-2020-085616

DESIGN: DMV DRAWN: JAK

DATE: Apr. 1, 2021

SHEET 25 OF 26

File: E:\Projects\Turkey Creek 3rd\Engineering\Phase 4\Str_20-02-E497\Coord.dwg