
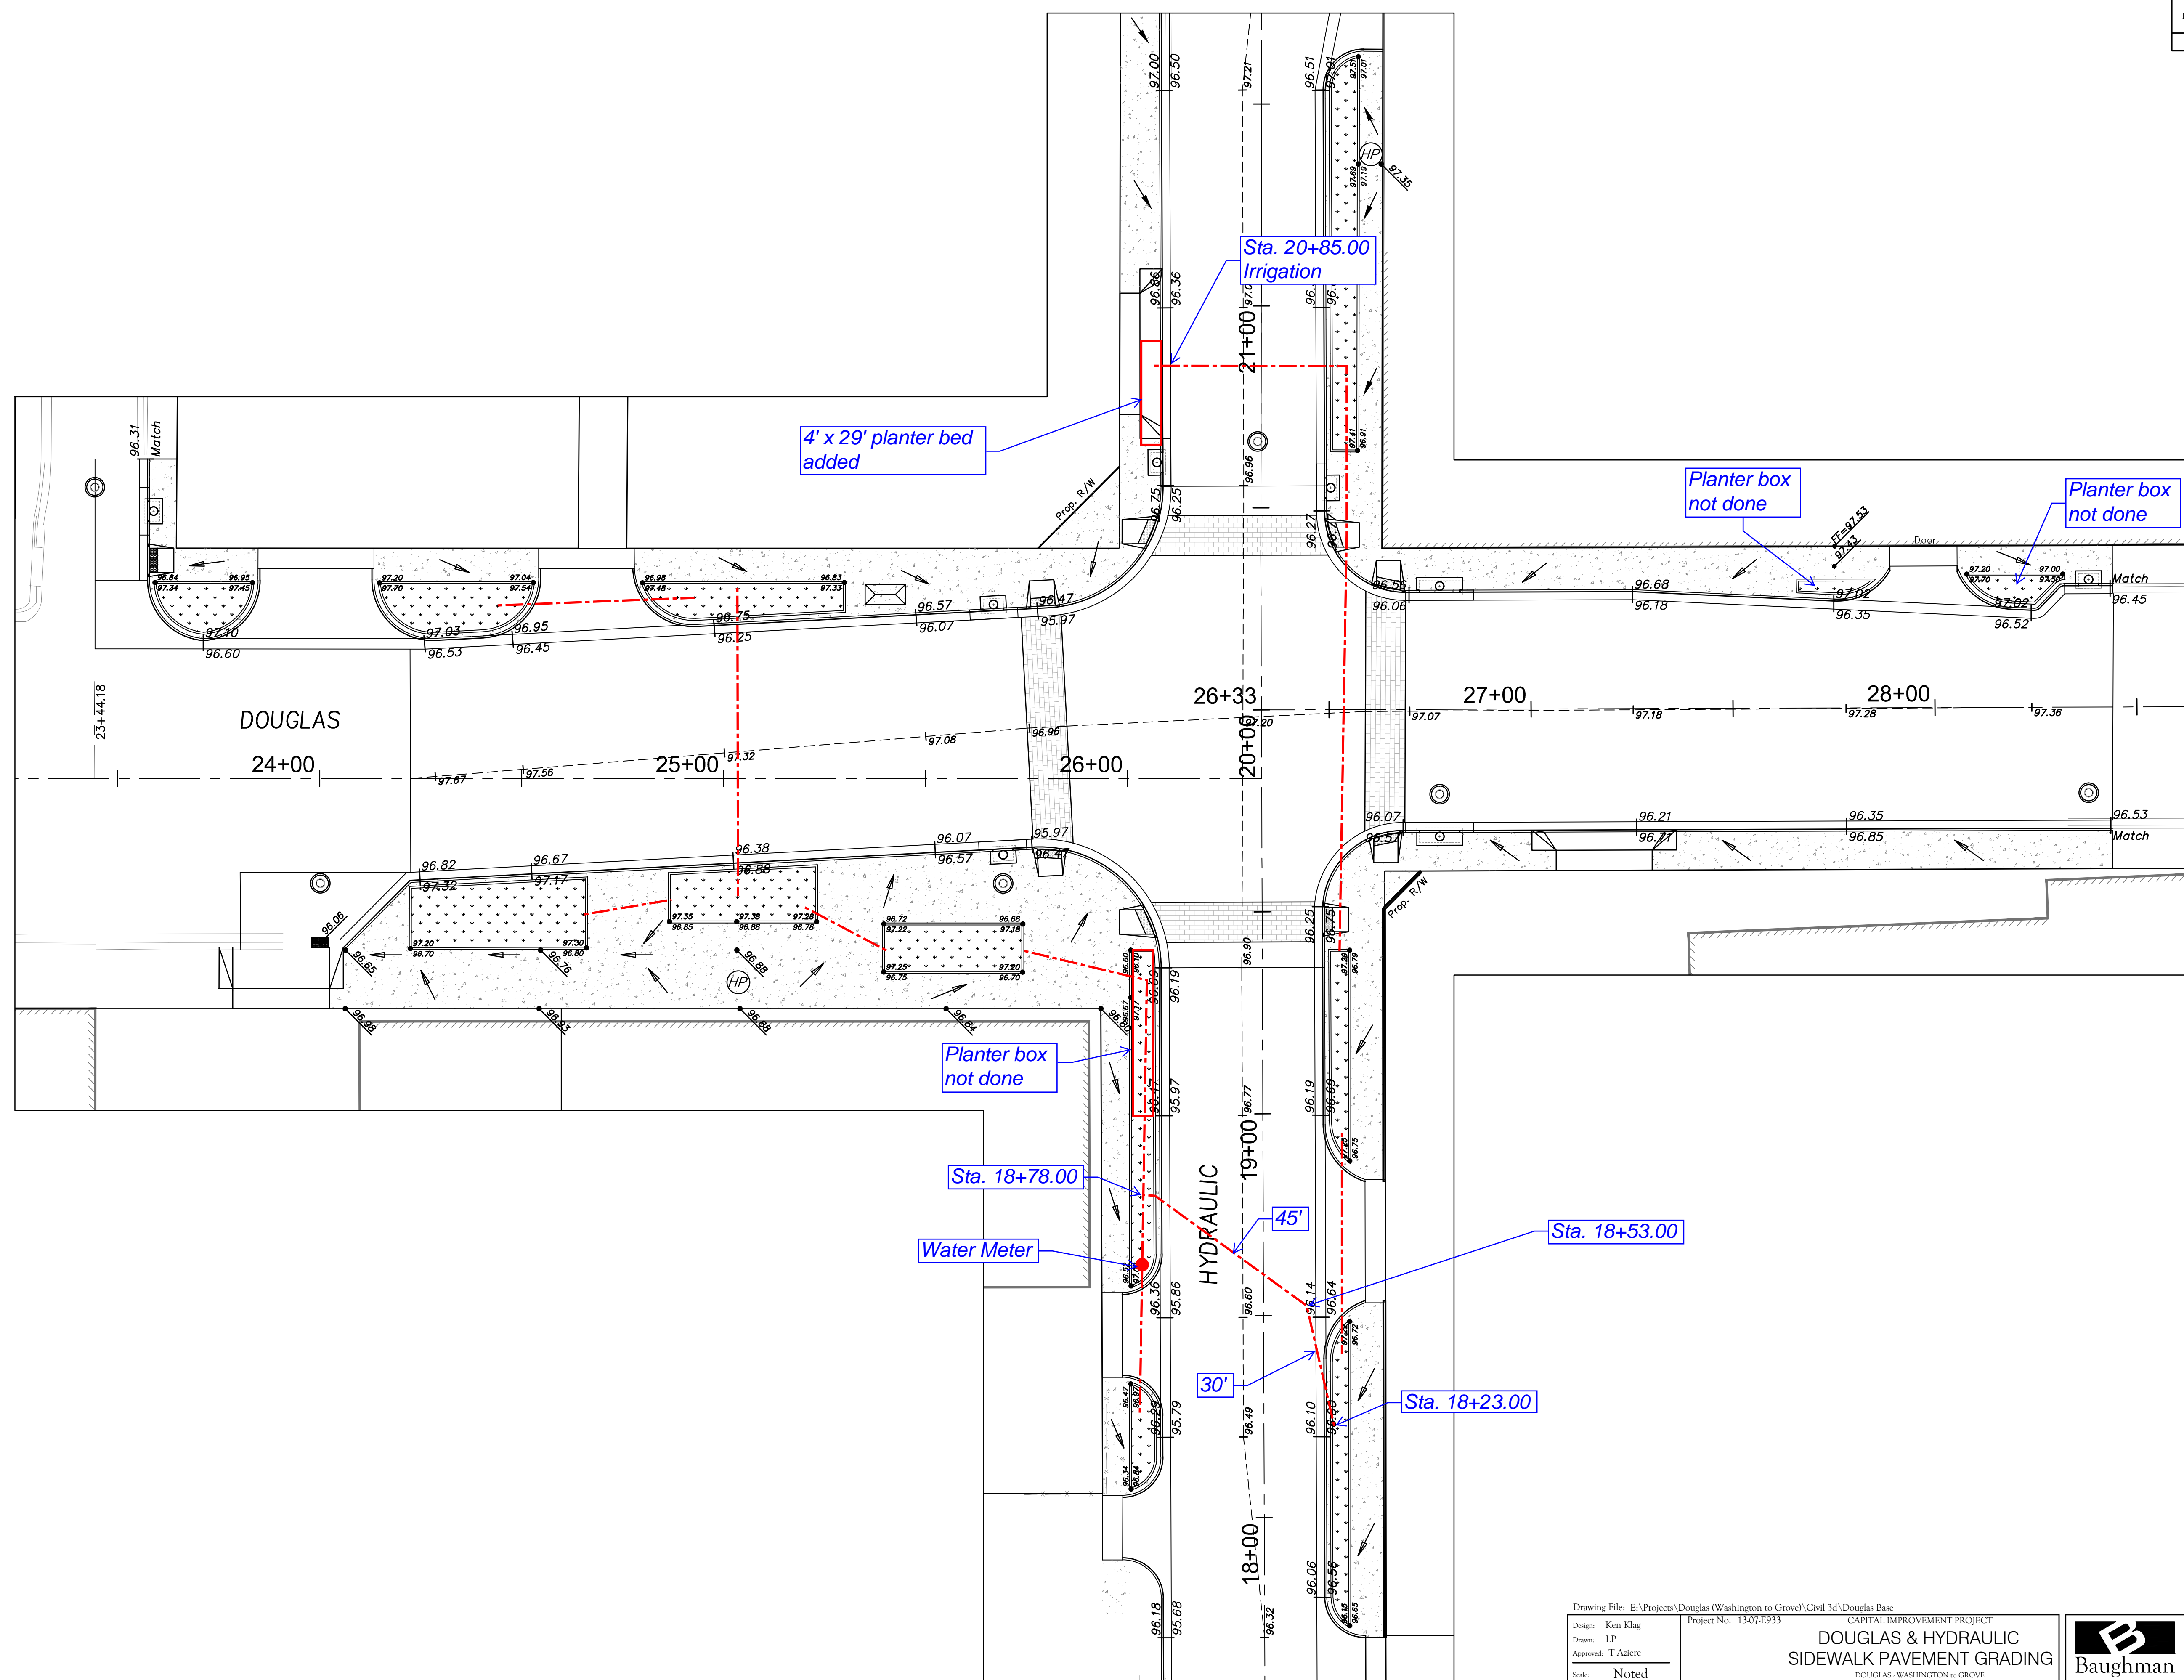


FHWA REGION NO.	STATE	PROJECT NO.	FISCAL YEAR	SHEET NO.	TOTAL SHEETS
7	KANSAS	U-0639-01	2017	16b	58

HSIP-N063(801)

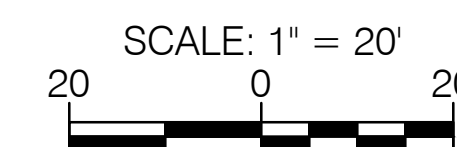

Drawing File: E:\Projects\Douglas (Washington to Grove)\Civil 3D\Douglas Base Design: Ken Klag Drawn: LP Approved: T Alieri Scale: Noted		Project No. 13-07-E933 DOUGLAS & HYDRAULIC SIDEWALK PAVEMENT GRADING <small>DOUGLAS - WASHINGTON TO GROVE</small>	Baughman Company, P.A. <small>315 Ellis St. Wichita, KS 67211 P 316-262-7271 F 316-262-0149</small> <small>ENGINEERING SURVEYING PLANNING LANDSCAPE ARCHITECTURE</small>	MARCH, 2017 SHEET 16b OF 58
--	--	--	---	--