
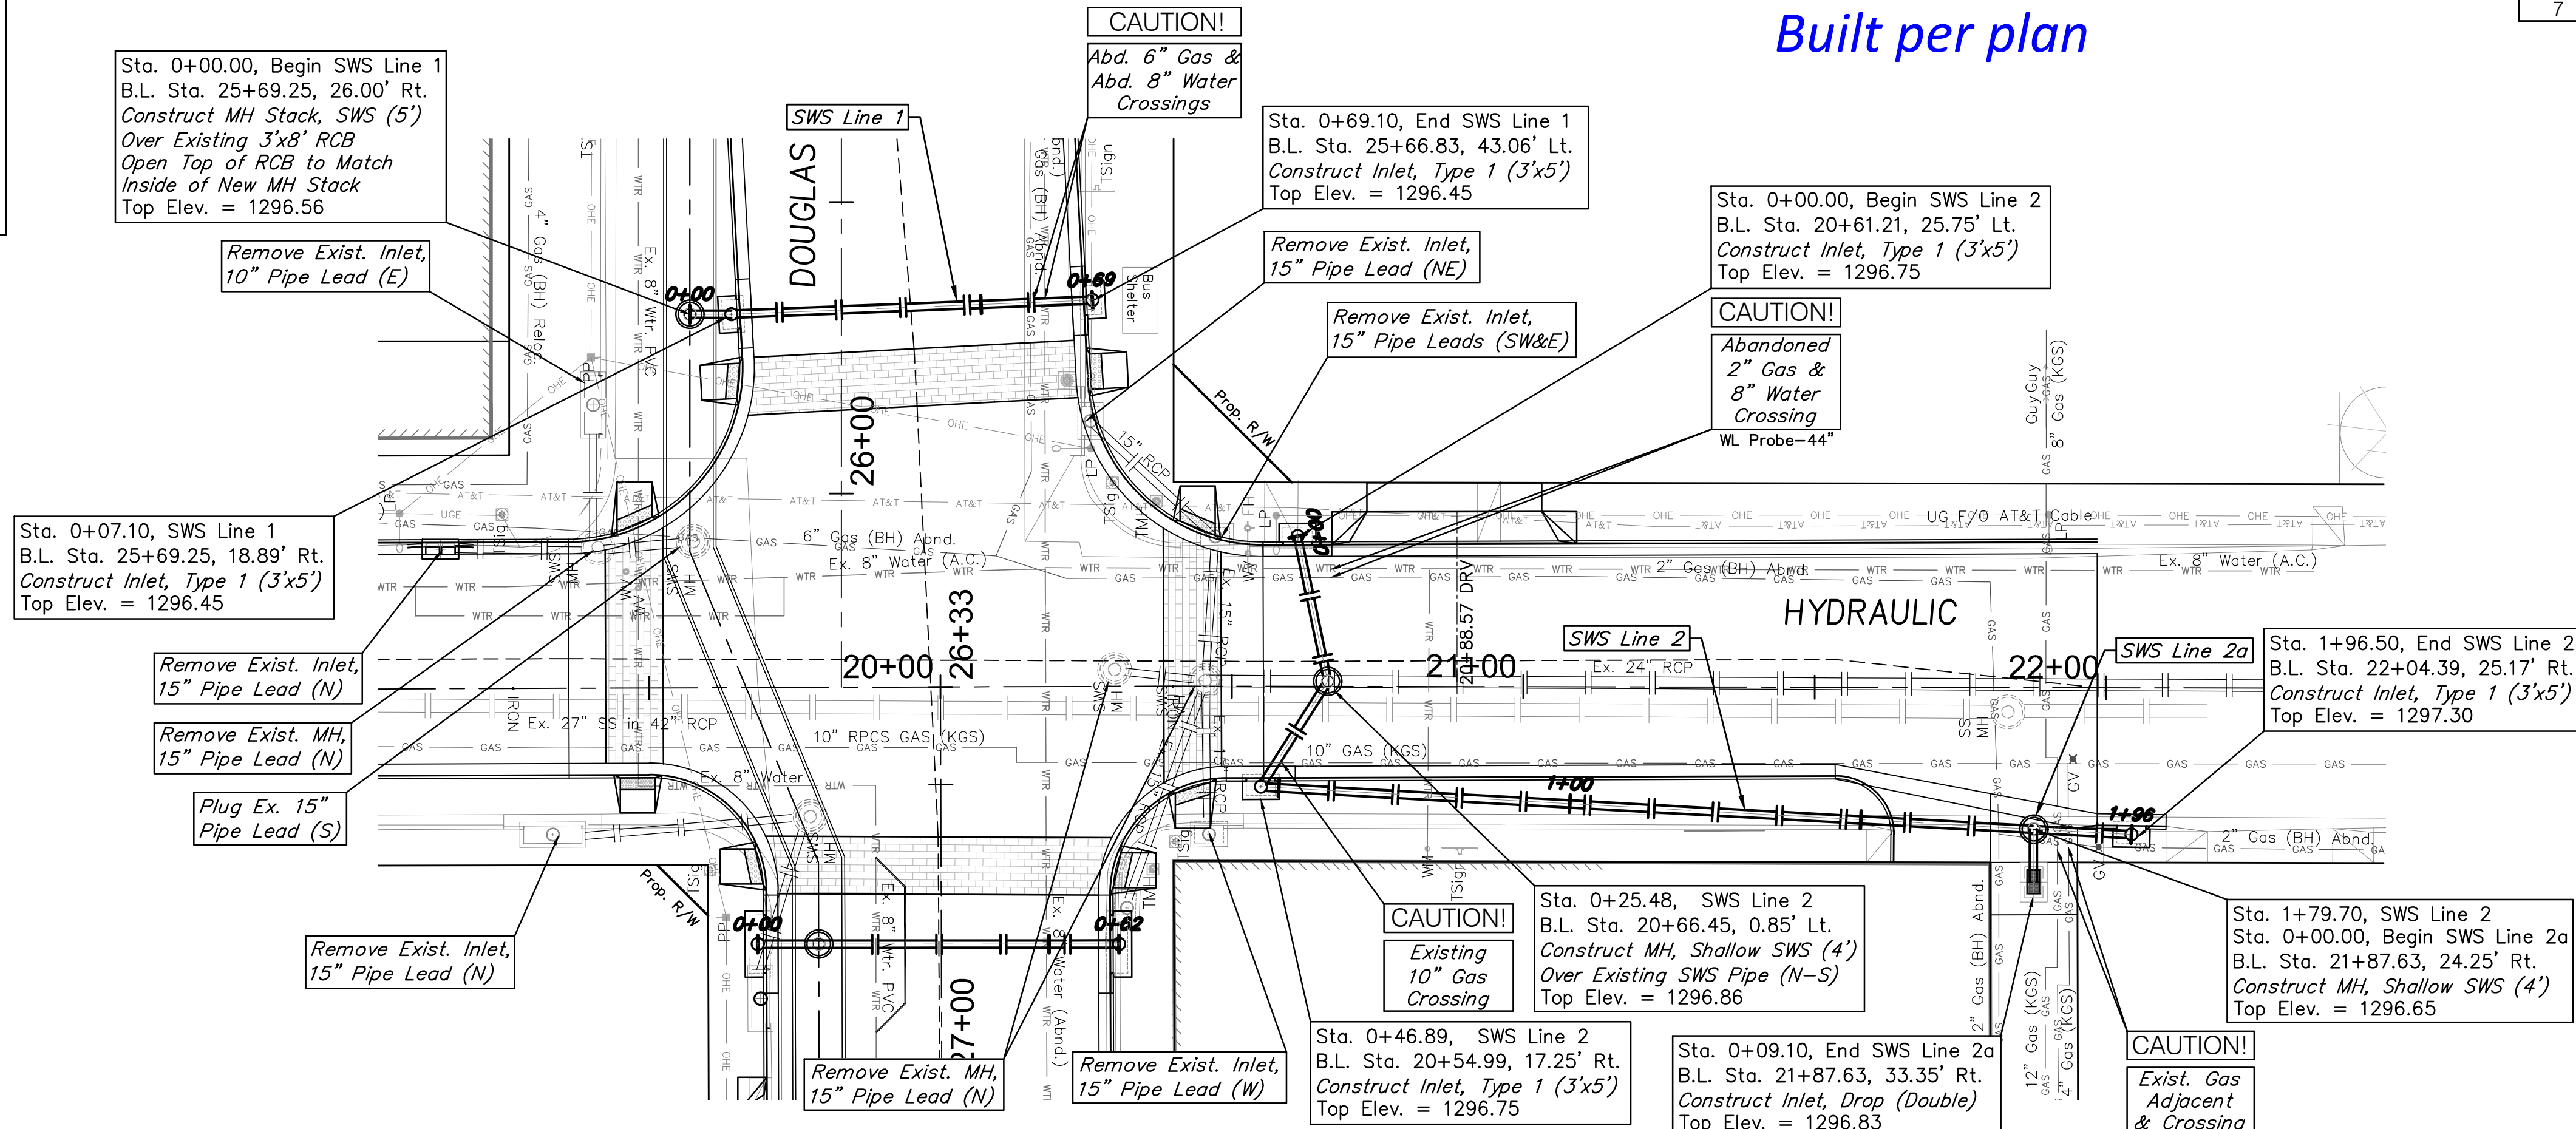


BENCHMARKS:

BM #6 - City of Wichita Benchmark Disc on the Northwest Corner of the Traffic Signal Base at the Southwest Corner of Douglas and Hydraulic.
Elev. = 1296.82 (NAVD 88)

BM #7 - Chiseled "□" 4' South of the Northwest Curb Return at the Intersection Douglas and Kansas, 41.2' North & 16.2' East of the Centerline of Both.
Elev. 1297.67 (NAVD 88)

FHWA REGION NO.	STATE	PROJECT NO.	FISCAL YEAR	SHEET NO.	TOTAL SHEETS
7	KANSAS	U-0639-01	2017	18	58

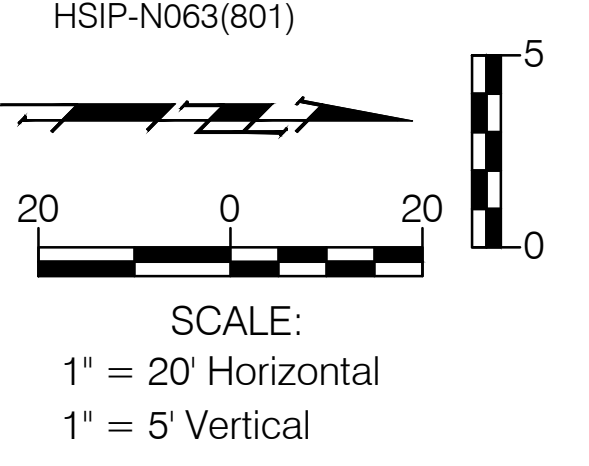

SWS Line 1

SWS Line 2

SWS Line 2a

