


ARKANSAS RIVER TO SENECA

CITY OF WICHITA

CIF PROJECT NO. 472 83608

OCA 706846

MICHAEL E. LINDEBAK, P.E., CITY ENGINEER

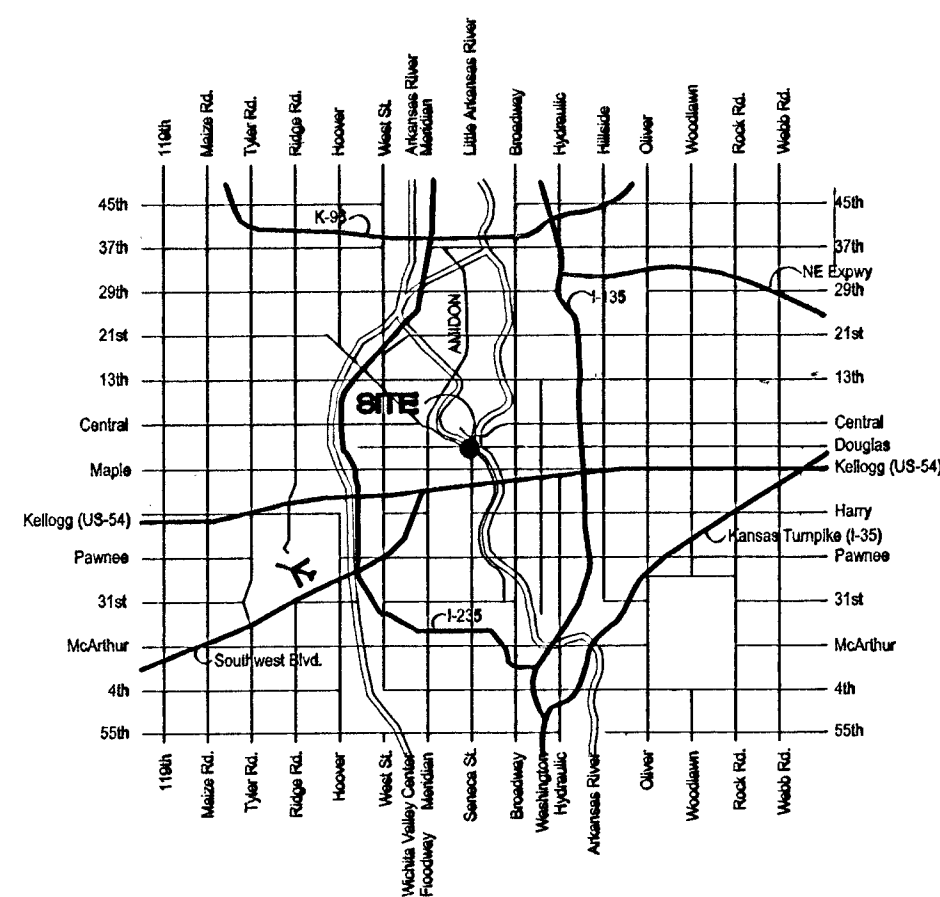

VICINITY MAP - WICHITA, KANSAS

**JOHNSON ENGINEERING
ELECTRICAL CONSULTANTS
330 LAURA
WICHITA, KS 67211**

STEVE MURILLO
MURILLO STUDIO
PUBLIC ART CONSULTANT

**K.E. MILLER, PE
K.E. MILLER ENGINEERING
516 S. MARKET
WICHITA, KS 67202**


DRAWING INDEX		SHEET NO. SHEET TITLE	
C10	COVER SHEET AND INDEX	ARCHITECTUAL A11 CLOCK TOWER A12 CLOCK TOWER DETAILS A13 CLOCK TOWER DETAILS A01 ARCH DETAILS A02 ARCH DETAILS	
CIVIL			
C11	PAVING PLAN 1	STRUCTURAL S1 ARCH DETAILS	
C12	PAVING PLAN 2		
C13	PAVING PLAN 3	ELECTRICAL E11 ELECTRICAL DETAILS & SCHEDULES E12 ELECTRICAL PLANS 1 & 2 E13 ELECTRICAL PLANS 3 & 4 E14 ELECTRICAL PLAN 5 & DETAILS	
C14	PAVING PLAN 4		
C15	PAVING PLAN 5		
C16	PAVING PLAN 6		
C17	TYPICAL SECTION		
C21	STORM SEWER PLAN AND PROFILE PAGE 1		
C22	STORM SEWER PLAN AND PROFILE PAGE 2		
C23	STORM SEWER PLAN AND PROFILE PAGE 3		
C24	STORM SEWER PLAN AND PROFILE PAGE 4		
C25	STORM SEWER PLAN AND PROFILE PAGE 5		
C26	STORM SEWER PLAN AND PROFILE PAGE 6		
C27	STORM SEWER PLAN AND PROFILE PAGE 7		
C28	STORM SEWER PLAN AND PROFILE PAGE 8		
C29	STORM SEWER PLAN AND PROFILE PAGE 9		
C210	STORM SEWER PLAN AND PROFILE PAGE 10		
C211	STORM SEWER PLAN AND PROFILE PAGE 11		
C31	TYPE 2 INLET MH DETAIL		
C32	TYPE 2 INLET SINGLE DETAIL		
C33	5' TYPE 1A INLET DETAIL		
C34	DRIVE INLET DETAIL		
C35	MANHOLE DETAILS		
C41	STRIPING PLAN		
C42	STRIPING PLAN FOR ROUNDABOUT		
C43	SIGNAGE PLAN		
C44	SIGNAGE DETAILS		
C45	TRAFFIC CONTROL PLAN		
C46	ROUNDABOUT DETAIL		
C47	JOINT PLAN FOR INTERSECTIONS		
C48	JOINT PLAN FOR ROUNDABOUT		
C49	DRIVE ENTRANCE DETAILS		
C410	EROSION CONTROL MEASURES FOR STREET PROJECTS		
C411	EROSION CONTROL MEASURES FOR CURB INLETS		
C412	EROSION CONTROL MEASURES FOR AREA INLETS		
C51-59	CROSS SECTIONS		
C61	WATER LINE PLAN AND PROFILE PAGE 1		
C62	WATER LINE PLAN AND PROFILE PAGE 2		
C63	WATER LINE PLAN AND PROFILE PAGE 3		
C64	WATER LINE PLAN AND PROFILE PAGE 4		
C65	WATER LINE PLAN AND PROFILE PAGE 5		
C71	FIRE HYDRANT AND VALVE DETAILS		
C72	VAULT DETAILS		
SITE			
S11	STREET&SCAPE PLAN 1		
S12	STREET&SCAPE PLAN 2		
S13	STREET&SCAPE PLAN 3		
S14	STREET&SCAPE PLAN 4		
S15	STREET&SCAPE PLAN 5		
S21	LAYOUT PLAN 1		
S22	LAYOUT PLAN 2		
S23	LAYOUT PLAN 3		
S24	LAYOUT PLAN 4		
S25	LAYOUT PLAN 5		
S31	SITE DETAILS		
S32	SITE DETAILS		
S33	SITE DETAILS		
S41	IRRIGATION PLAN 1		
S42	IRRIGATION PLAN 2		
S43	IRRIGATION PLAN 3		
S44	IRRIGATION PLAN 4		
S45	IRRIGATION PLAN 5		
S46	IRRIGATION DETAILS		
S51	LAND&SCAPE PLAN 1		
S52	LAND&SCAPE PLAN 2		
S53	LAND&SCAPE PLAN 3		
S54	LAND&SCAPE PLAN 4		
S55	LAND&SCAPE PLAN 5		
S56	LAND&SCAPE DETAILS		

Did Not Build





**WEST DOUGLAS STREETSCAPE
ARKANSAS RIVER TO SENECA
WICHITA, KANSAS**

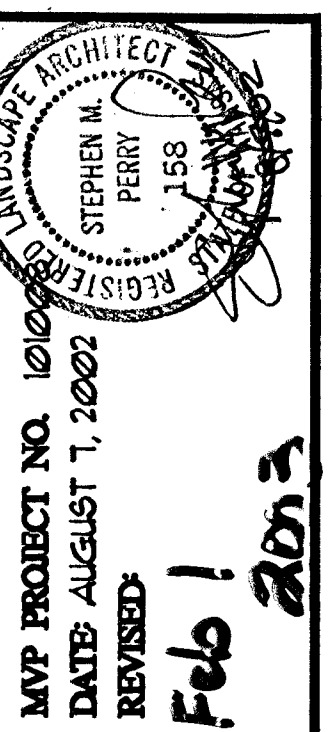

SHEET

C1.0



ARCHITECTS • PLANNERS • LANDSCAPE ARCHITECTS
125 S. WASHINGTON WICHITA, KANSAS 67202
P.O. BOX 3648 WICHITA, KANSAS 67201
PH. 316.262.0463 • FAX. 316.262.5465

MCCUUGAGE VAN SICKLE & PERRY