


**1 ARCH ELEVATION (ALT. #3)**  
 (2 REQUIRED) SCALE: 1/4" = 1'-0"  
 NOTE: ALTERNATE #3 INCLUDES ARCH, TOWERS, SIGNS, TRELLISES, LIGHTING OF ARCH, AND PLANTINGS AT TOWERS. SEE SPECS FOR DESCRIPTION.  
 NOTE: EXCAVATION FOR FOOTINGS SHALL BE SUBSIDIARY TO ENTRY ARCH.


PAINTING SPECS FOR EXTERIOR STEEL:  
 A. PREPARATION: CLEAN AND PREPARE SURFACES TO BE PAINTED ACCORDING TO MANUFACTURER'S WRITTEN INSTRUCTIONS AND RECOMMENDATIONS.  
 B. APPLICATION: SHOP FINISH APPLY PAINT BY SPRAY METHOD ACCORDING TO MANUFACTURER'S WRITTEN INSTRUCTIONS AND RECOMMENDATIONS.  
 C. PAINT SYSTEM: PROVIDE ONE OF THE FOLLOWING:  
 1. BENJAMIN MOORE ALPHATIC URETHANE SYSTEM.  
 a. 1ST COAT: UNIVERSAL METAL PRIMER #101.  
 b. TWO FINISH COATS: 2-PART URETHANE #114-75 GLOSS.  
 2. SHERWIN WILLIAMS ACRYLIC POLYURETHANE SYSTEM.  
 a. 1ST COAT: RECOATABLE EPOXY PRIMER.  
 b. TWO FINISH COATS: ACRYLON 218 H9 (HIGH SOLIDS) GLOSS.  
 D. COLOR: BLACK.

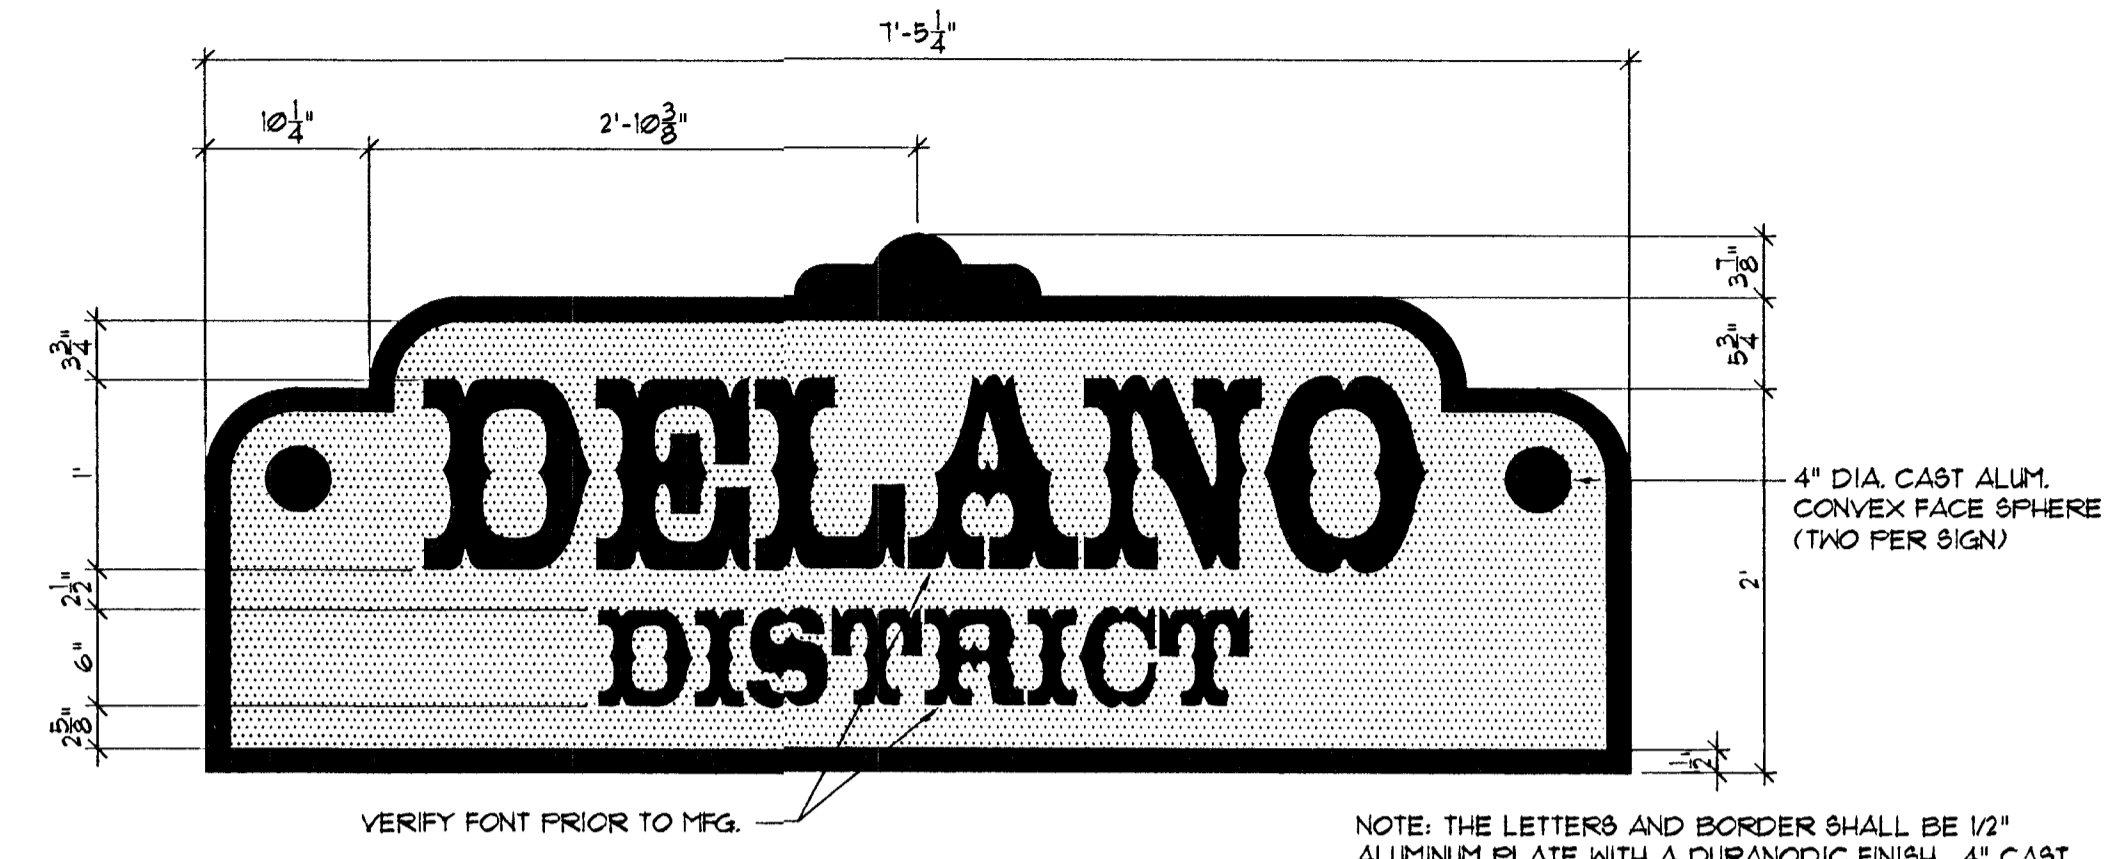


**5 ARCH SIGN**  
 (2 REQUIRED) SCALE: 1" = 1'-0"

NOTE: THE LETTERS AND BORDER SHALL BE 1/2" ALUMINUM PLATE WITH A DURANODIC FINISH. 4" CAST CONVEX SPHERES SHALL HAVE THE SAME FINISH. BACKGROUND SHALL BE 030 ALUMINUM PRIMED AND PAINTED WITH ACRYLIC POLYURETHANE PAINT, 1 PRIMER, 2 COATS FINAL. MOUNT GRAPHICS TO BACKGROUND FROM BACK WITH 3/16" PAINTED ALUM. RIVETS. MOUNT TO STEEL ARCH AS PER SIGN MANUFACTURER'S RECOMMENDATION WITH CONCEALED ATTACHMENT. DURANODIC FINISH AND PAINTING COLOR TO BE PROVIDED BY ARCHITECT.


*Did not Build*

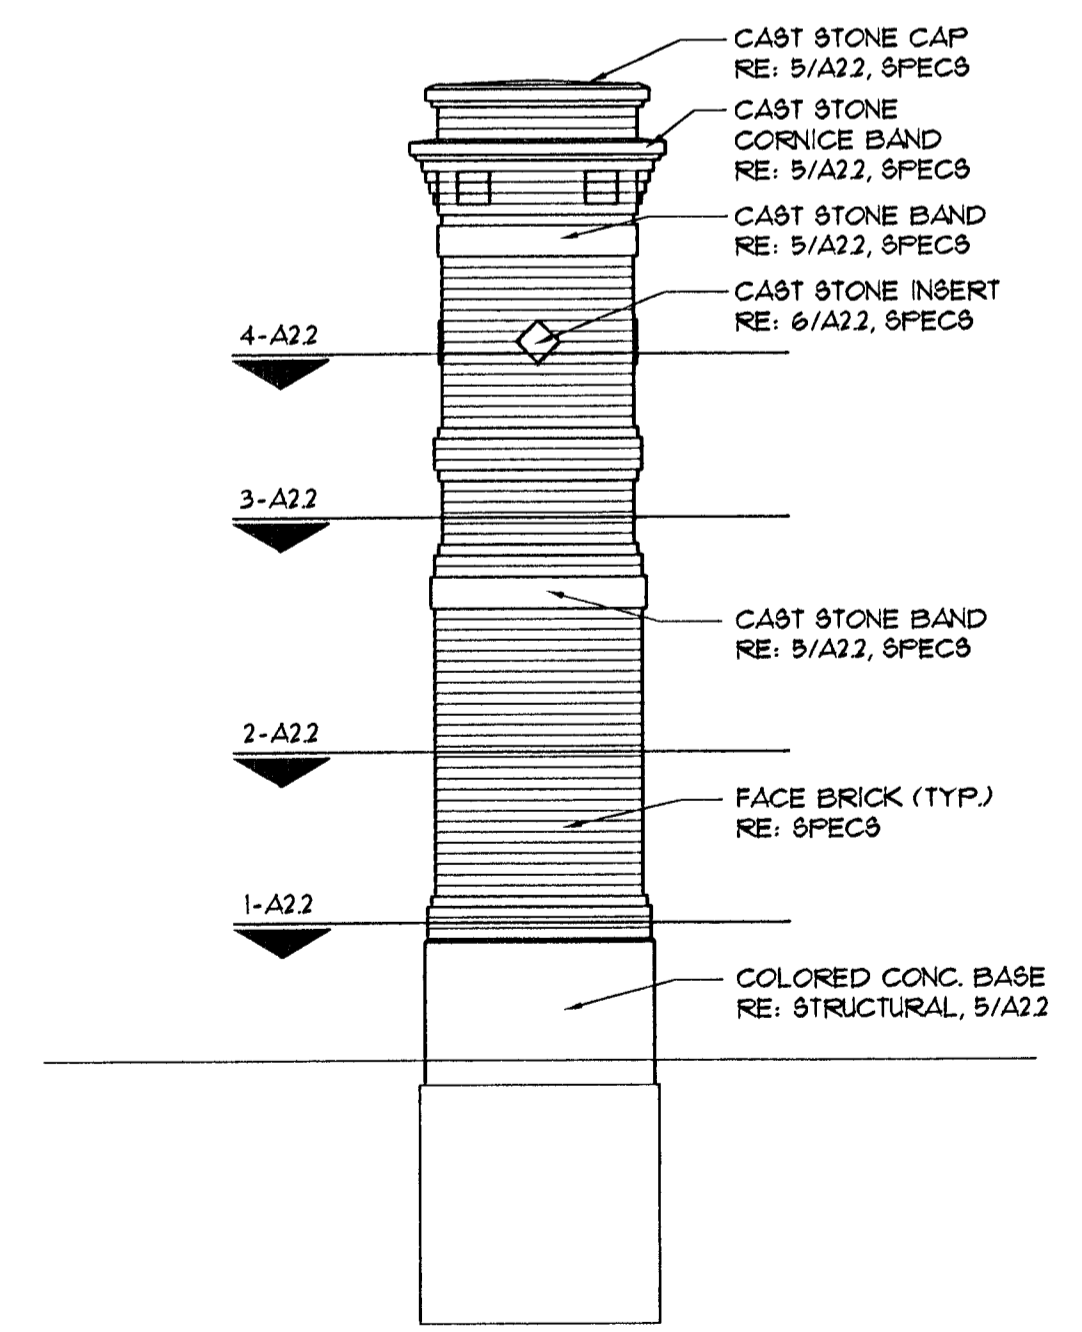

**2 ARCH BUILDINGSIDE ELEVATION**  
 SCALE: 1/4" = 1'-0"

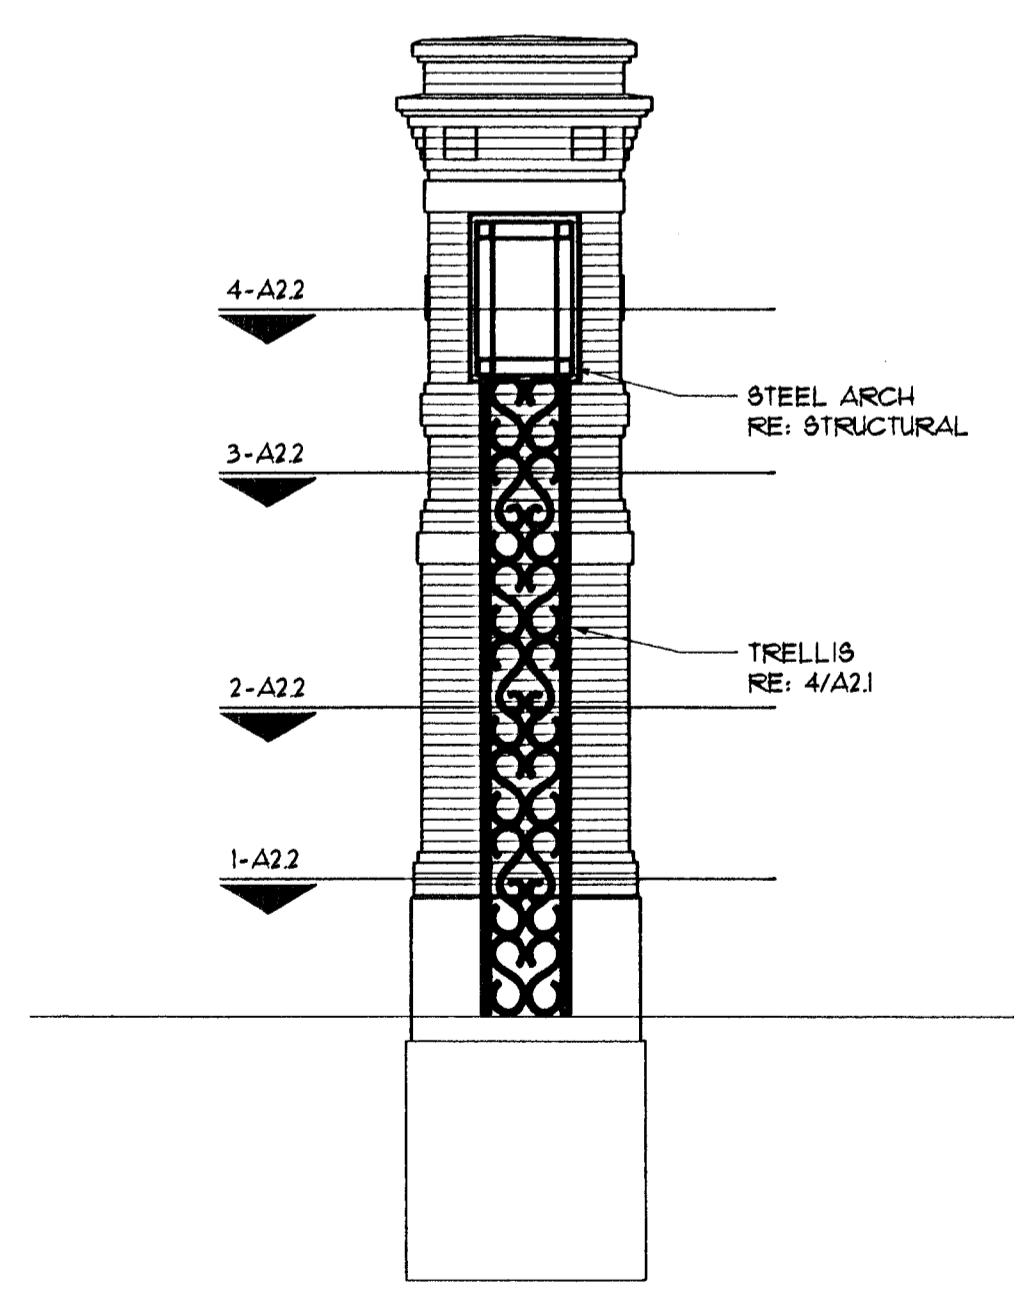

**3 ARCH STREETSIDE ELEVATION**  
 SCALE: 1/4" = 1'-0"

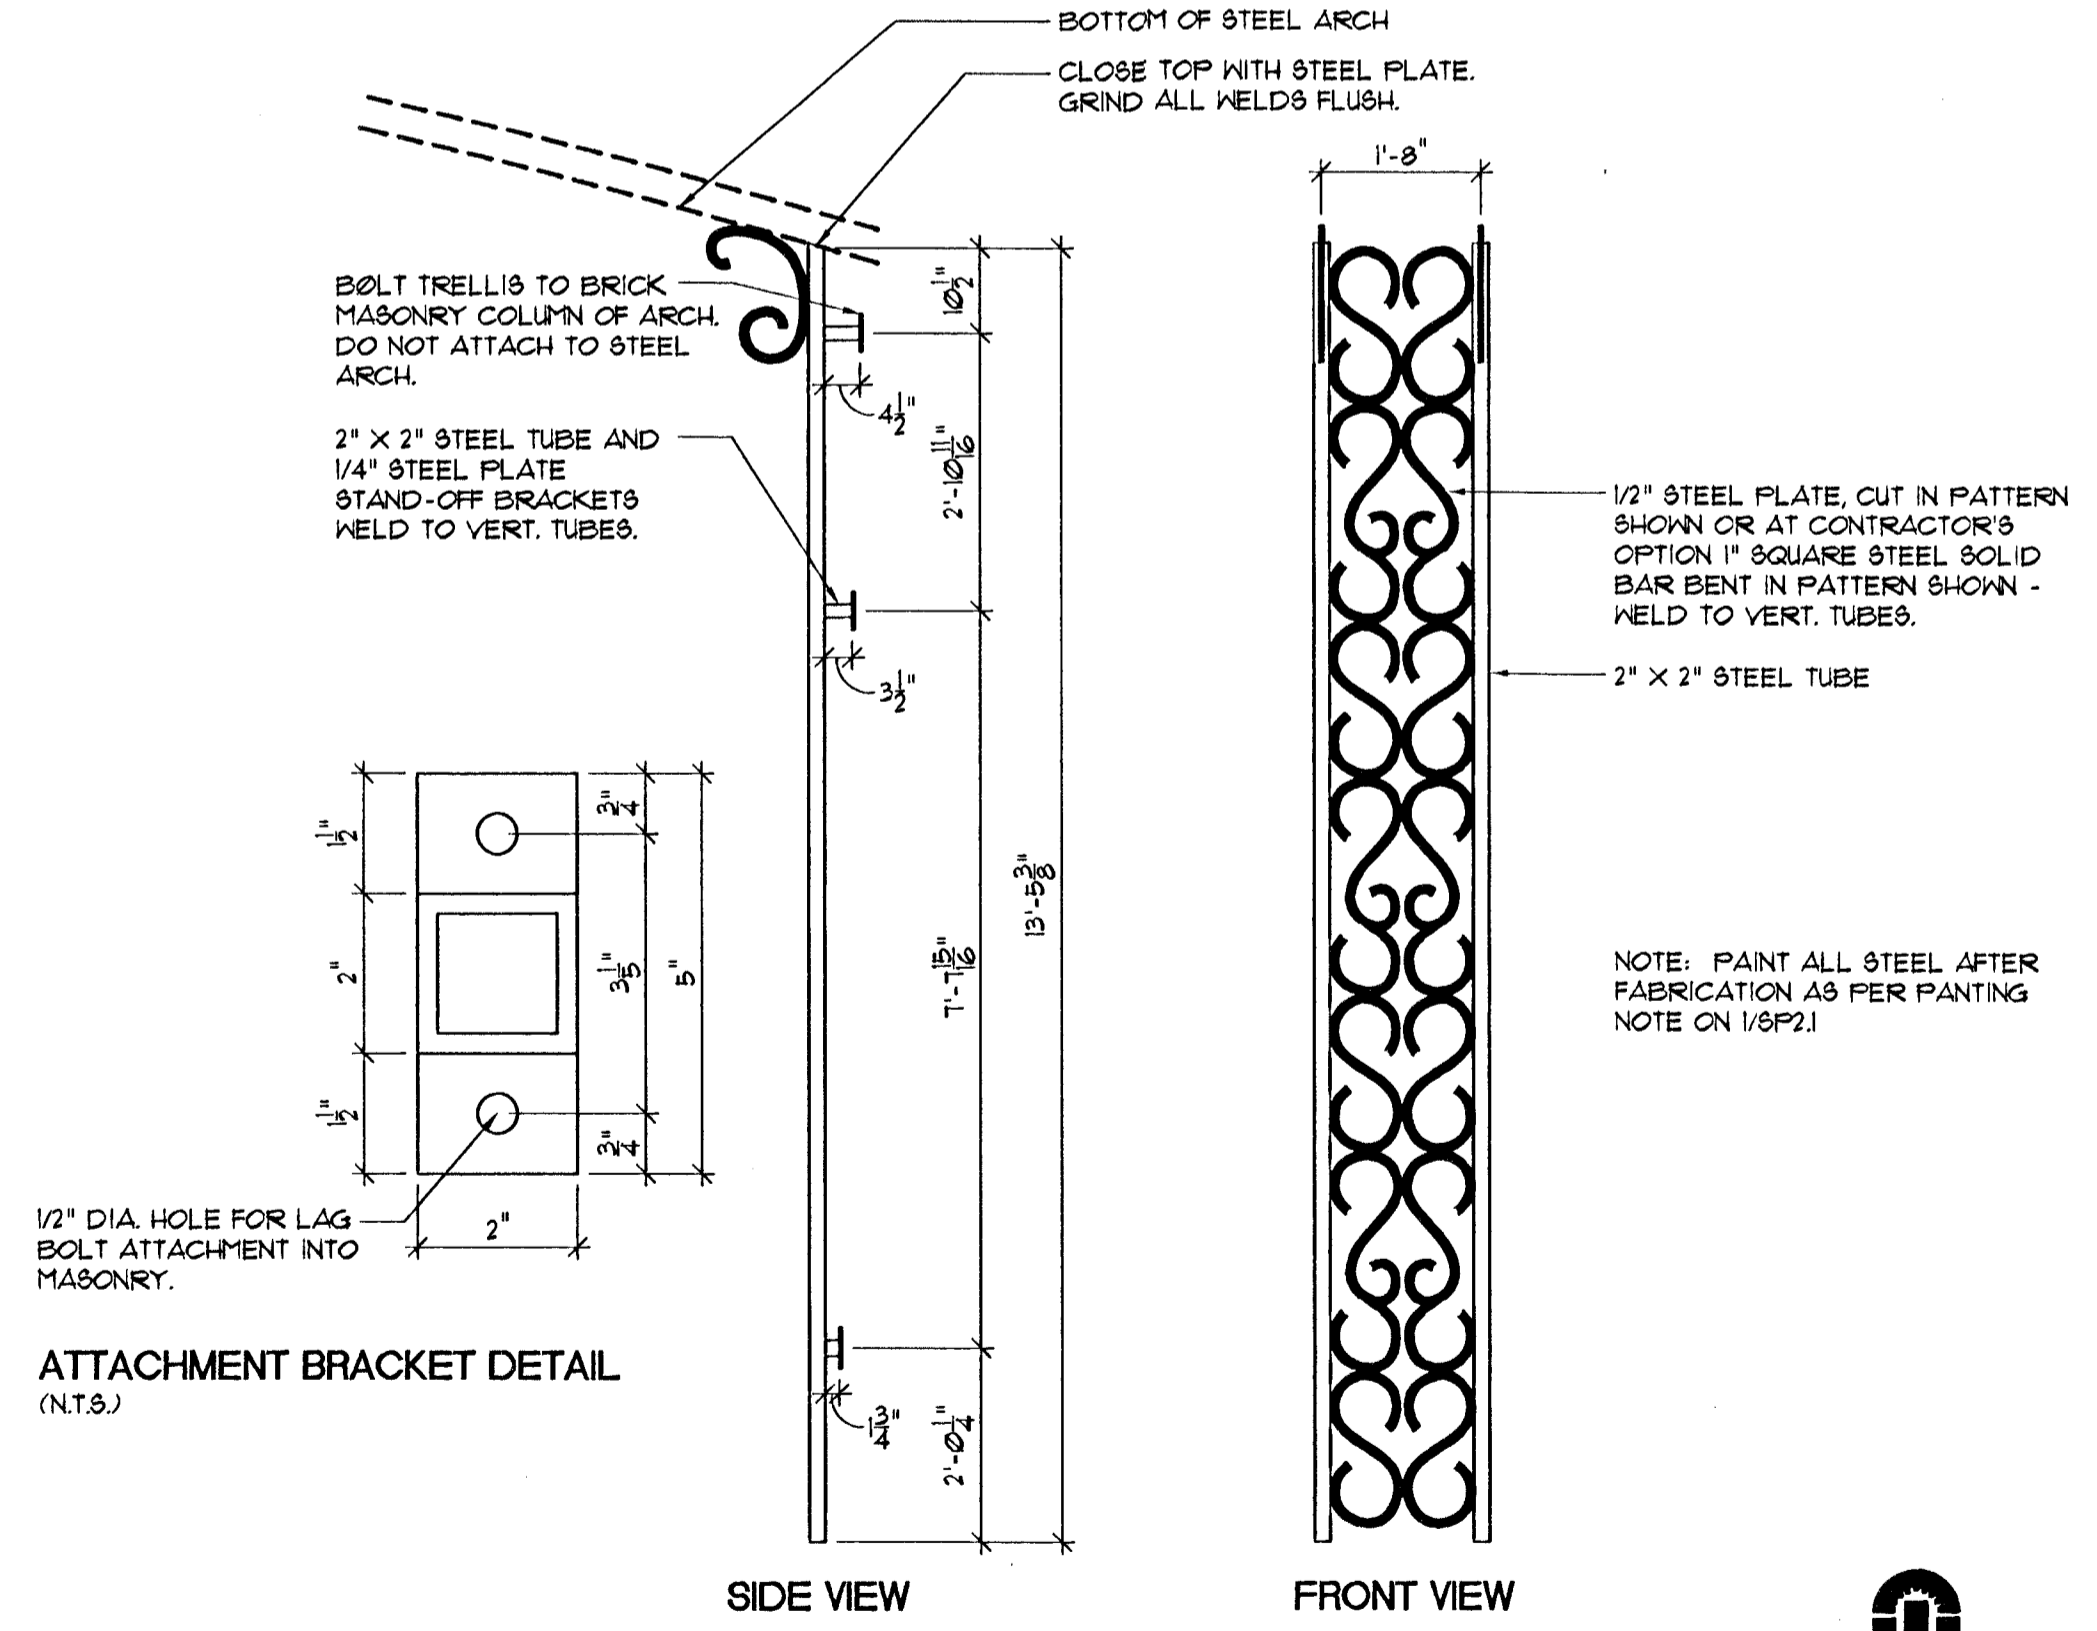

**4 TRELLIS AT ARCH COLUMN**  
 (4 REQUIRED) SCALE: 1/2" = 1'-0"

**MCCULLAGH VAN SICKLE & PERRY**  
 ARCHITECTS • PLANNERS • LANDSCAPE ARCHITECTS  
 12 S. WASHINGTON WICHITA, KANSAS 67202  
 P.O. BOX 348 WICHITA, KANSAS 67201  
 PH. 360.2648 • FAX 360.2646

**WEST DOUGLAS STREETSCAPE  
 ARKANSAS RIVER TO SENECA  
 WICHITA, KANSAS**

JEFFREY W. WEIFORD  
 LICENSED PROFESSIONAL ARCHITECT  
 PROJECT NO. 472 83608  
 MVP PROJECT NO. 1010008  
 DATE: AUGUST 1, 2002  
 REVISED

ARCH DETAILS  
 SHEET  
**A2.1**

