


Scale: 1" = 20' Horz.
1" = 5' Vert.

SOUTH HIGH ADDITION

PERCELL'S 6TH ADDITION

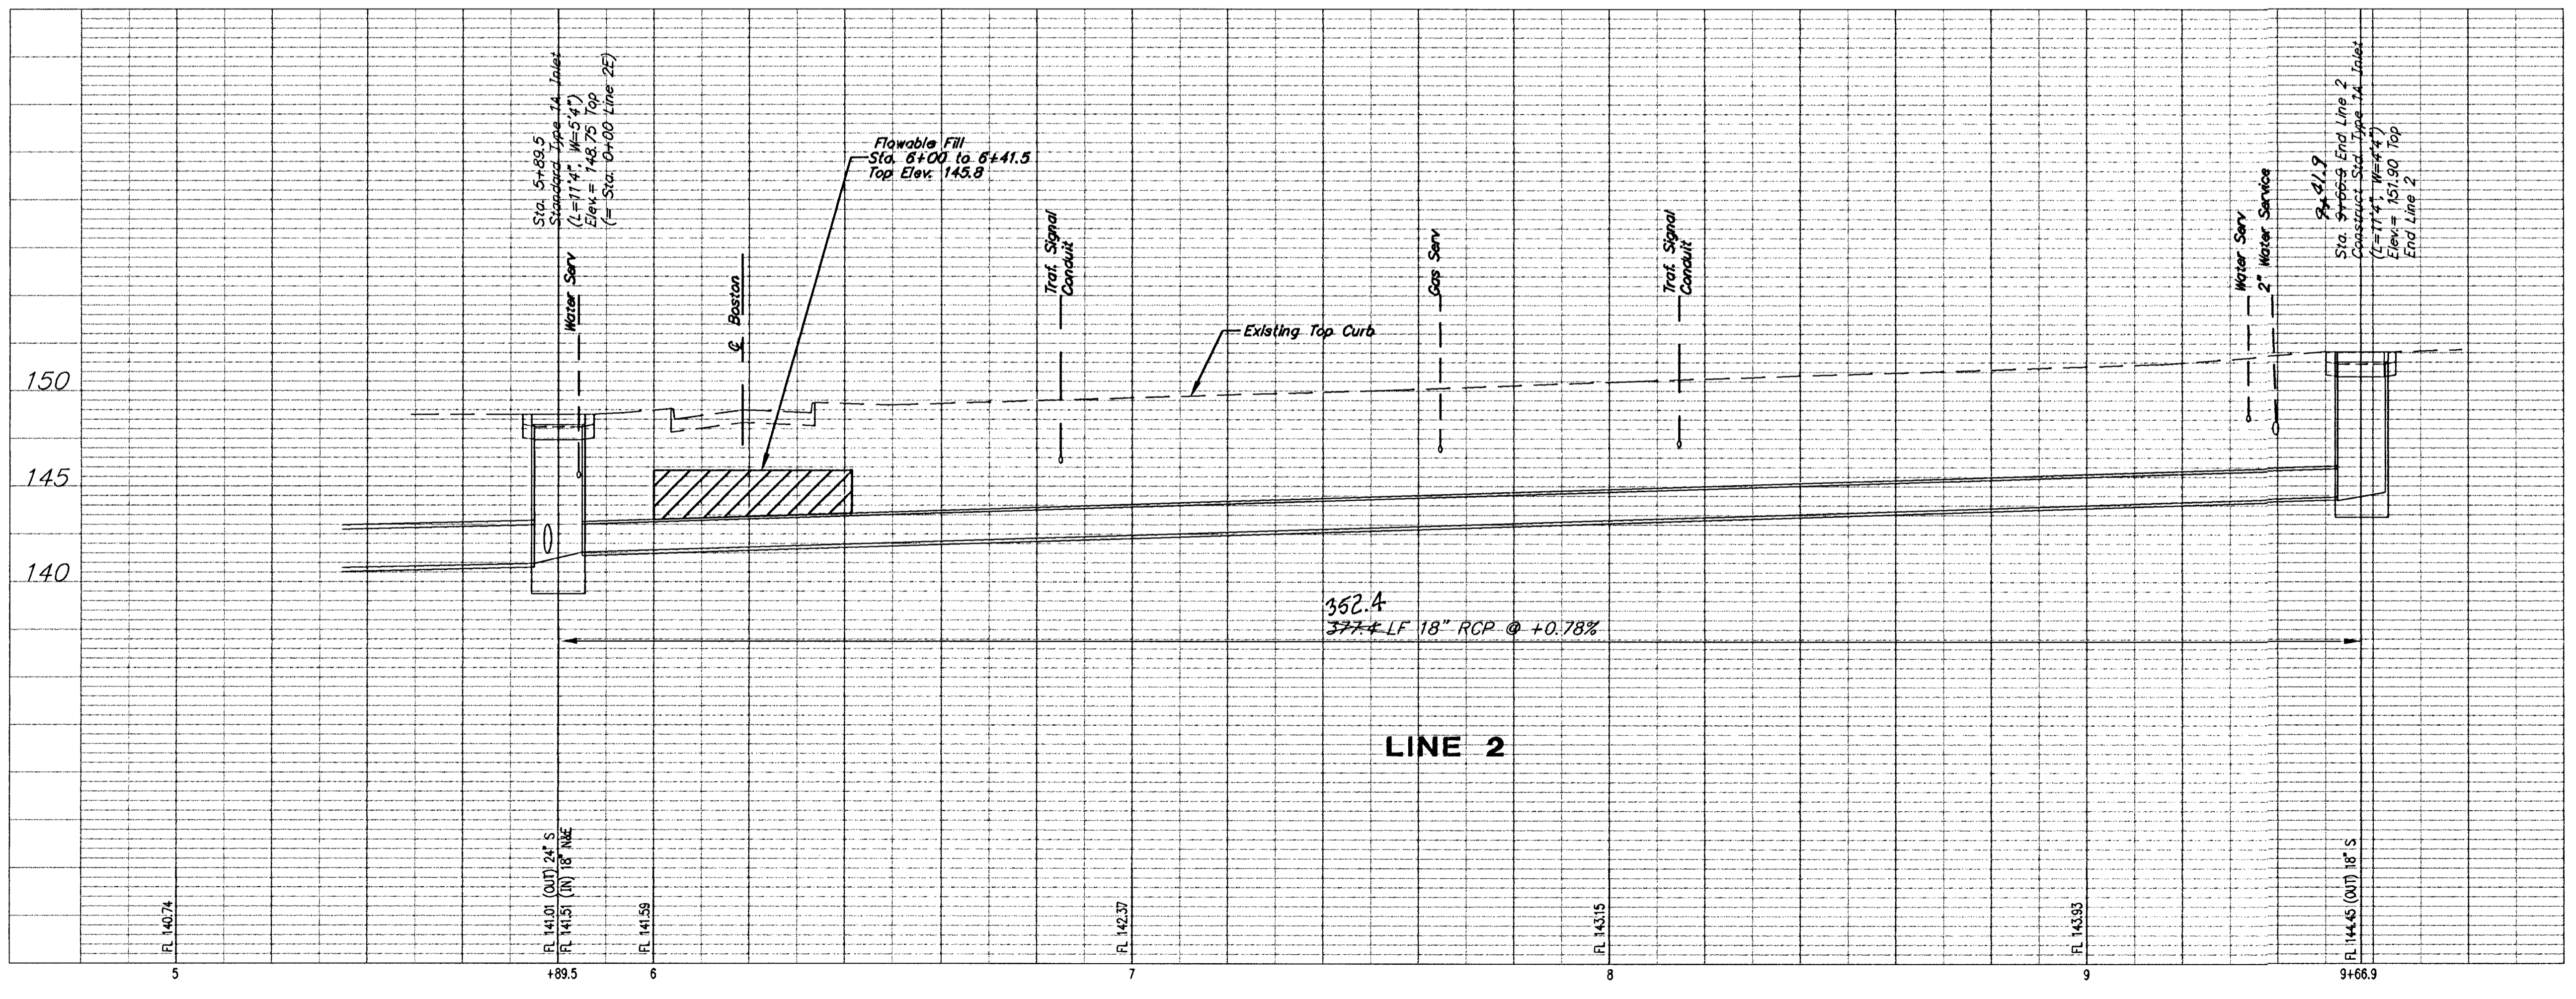

LINE 2

155
150
145

REVISED 8-23-95 JKB
Harry and Edgemoor Intersection Improvements
STORM SEWER LINE 2
Sta 5+89.14 to 9+66.54

BAUGHMAN COMPANY P.A.
ENGINEERING & SURVEYING
318/202-7271 • 318 ELLIS • WICHITA, KANSAS 67211

PROJECT NUMBER		SHEET	
468-82138 & 472-82668		13	
DESIGN	DRAWN	UTIL. CHECK	DATE
T.C.R.	Sonny	T.C.R.	10-26-92
SCALE		OF	
1" = 20'		38	