

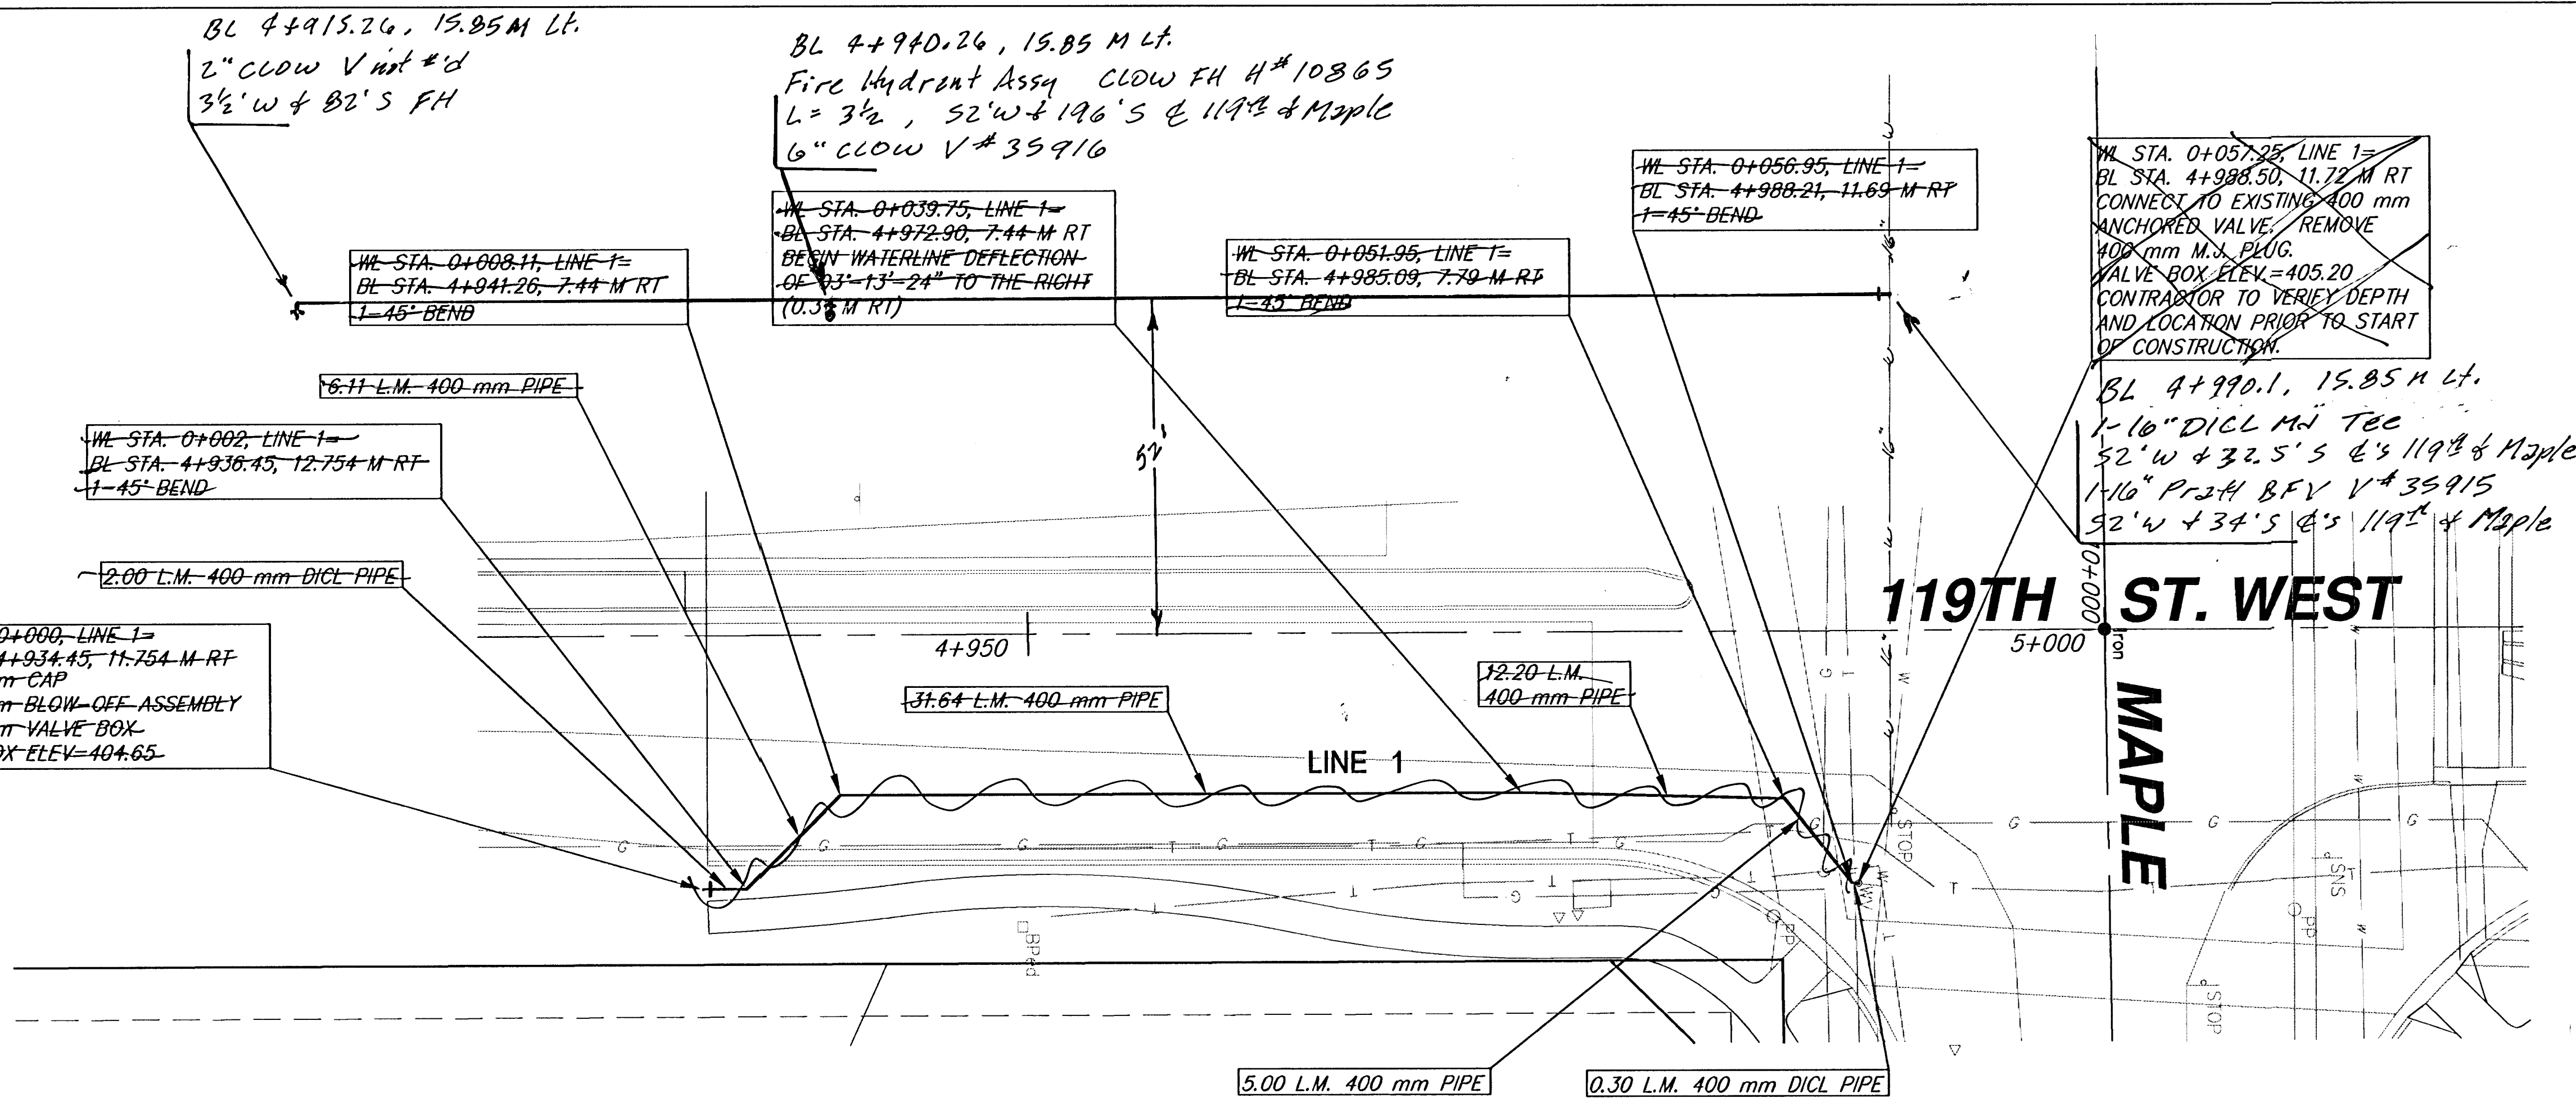
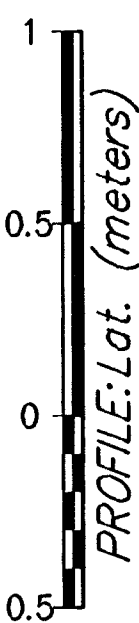


FHWA REGION NO.	STATE	PROJECT NUMBER	FISCAL YEAR	SHEET NUMBER	TOTAL SHEETS
7	KANSAS	87N-0127-01	1999	41	90

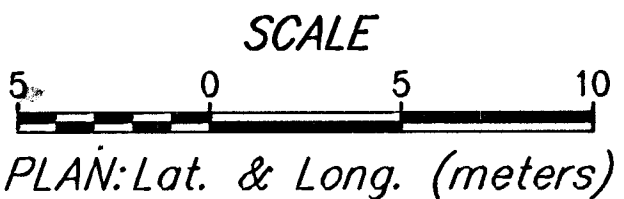

*** UNLESS OTHERWISE NOTED, ALL ELEVATIONS SHOWN ARE TO TOP OF PIPE ***

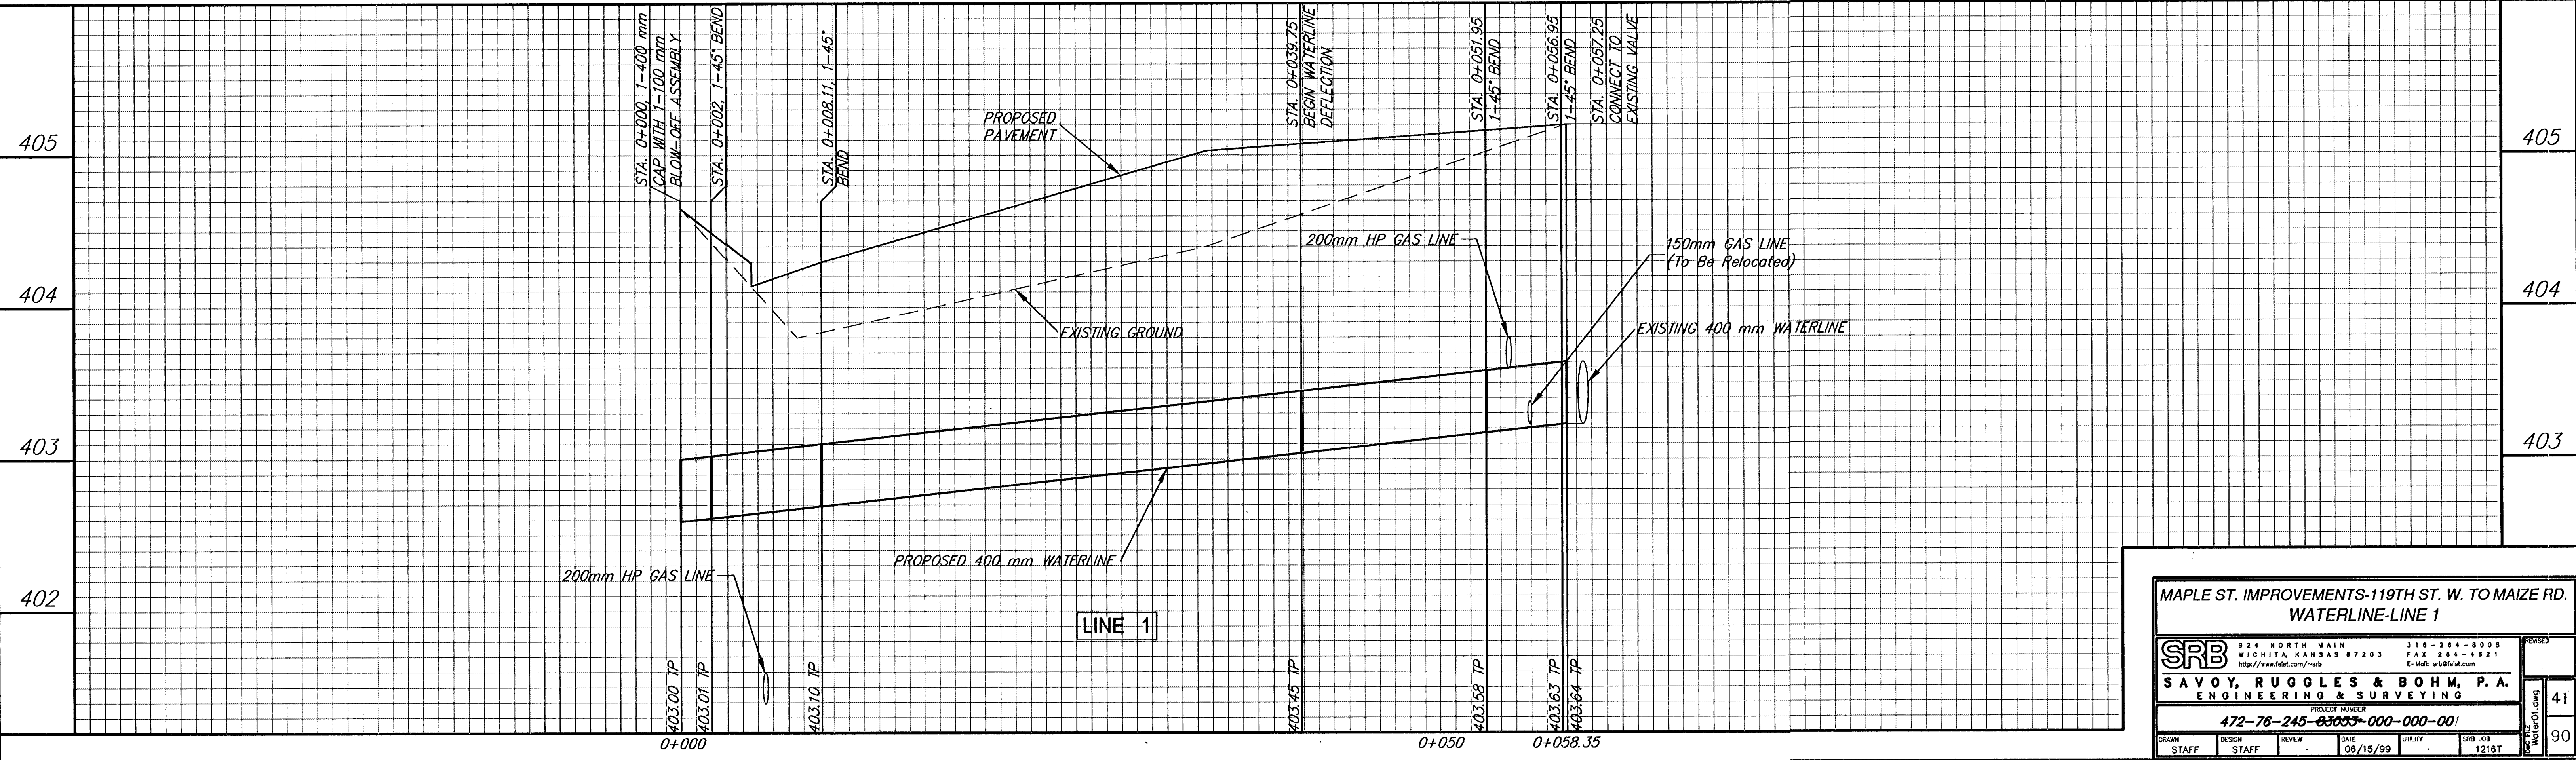

MAPLE ST. IMPROVEMENTS-119TH ST. W. TO MAIZE RD.
WATERLINE-LINE 1

SRB

924 NORTH MAIN
WICHITA, KANSAS 67203
http://www.fdot.com/~srb

316-264-8008
FAX 264-4821
E-Mail: srbs@fdot.com

SAVOY, RUGGLES & BOHM, P.A.
ENGINEERING & SURVEYING

PROJECT NUMBER
472-76-245-03053-000-000-001

DATE 06/15/99

UTILITY

SRB JOB 1218T

41

90