FHWA REGION NO.	STATE	PROJECT NUMBER	FISCAL YEAR	SHEET NUMBER	TOTAL SHEETS
7	KANSAS	STP-N012 (701)	1999	44	90

DATE	BY
REFERENCES NOTED	
REFERENCES CHECKED	

SCALE
5 0 5 10
PLAN: Lat. & Long. (meters)

SRB

8" A.F.C. V# 19602
3½' W & 114' S FH #5980

BL 10+325.07, 12.26 m Lt.

WL STA. 0+000, LINE 2=
BL STA. 10+300, 12.26 m LT
CONNECT TO EXISTING WATERLINE
~~1-22 1/2° BEND~~
CONTRACTOR TO VERIFY DEPTH
AND LOCATION PRIOR TO START
OF CONSTRUCTION.

~~WL STA 0+002.61, LINE 2=~~
~~BL STA. 10+302.41, 12.26 m LT~~
~~1-22 1/2° BEND~~

WL STA. 0+027.54, LINE 2=
BL STA. ~~10+327.34,~~ 12.26 m LT
1-400 mm X 200 mm TEE
1-200 mm GATE VALVE (N)
VALVE BOX ELEV.=405.90

REMOVE 67.0 m 400 mm
A.C. PIPE

~~WL STA 0+064.25, LINE 2=~~
~~BL STA. 10+364.05, 12.26 m LT~~
~~1-22 1/2° BEND~~

WL STA. 0+067.39, LINE 2=
BL STA. 10+366.95, 12.26 m LT
CONNECT TO EXISTING WATERLINE
~~1-22 1/2° BEND~~
CONTRACTOR TO VERIFY DEPTH
AND LOCATION PRIOR TO START
OF CONSTRUCTION.

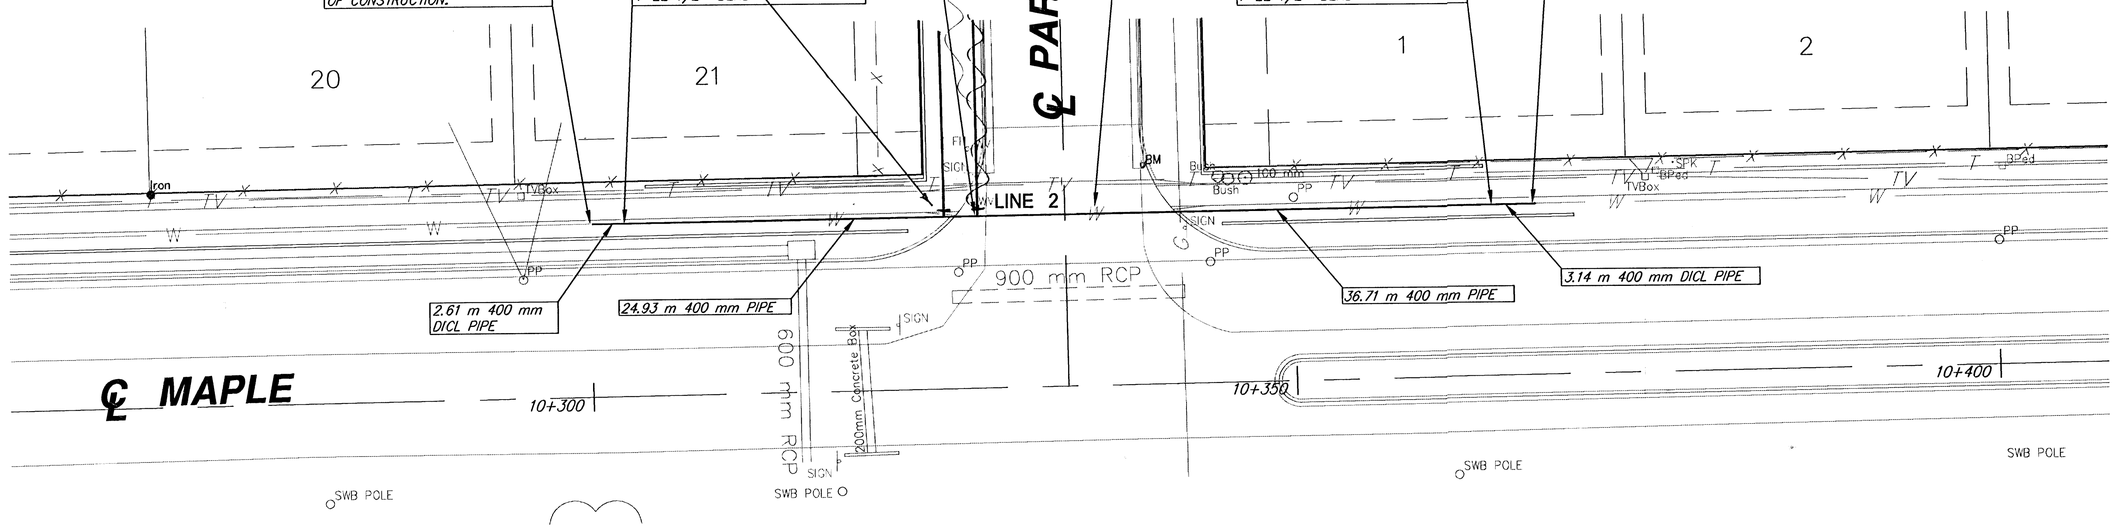

PROFILE: Lat. (meters)
1
0.5
0
0.5

*** UNLESS OTHERWISE NOTED, ALL ELEVATIONS SHOWN ARE TO TOP OF PIPE ***

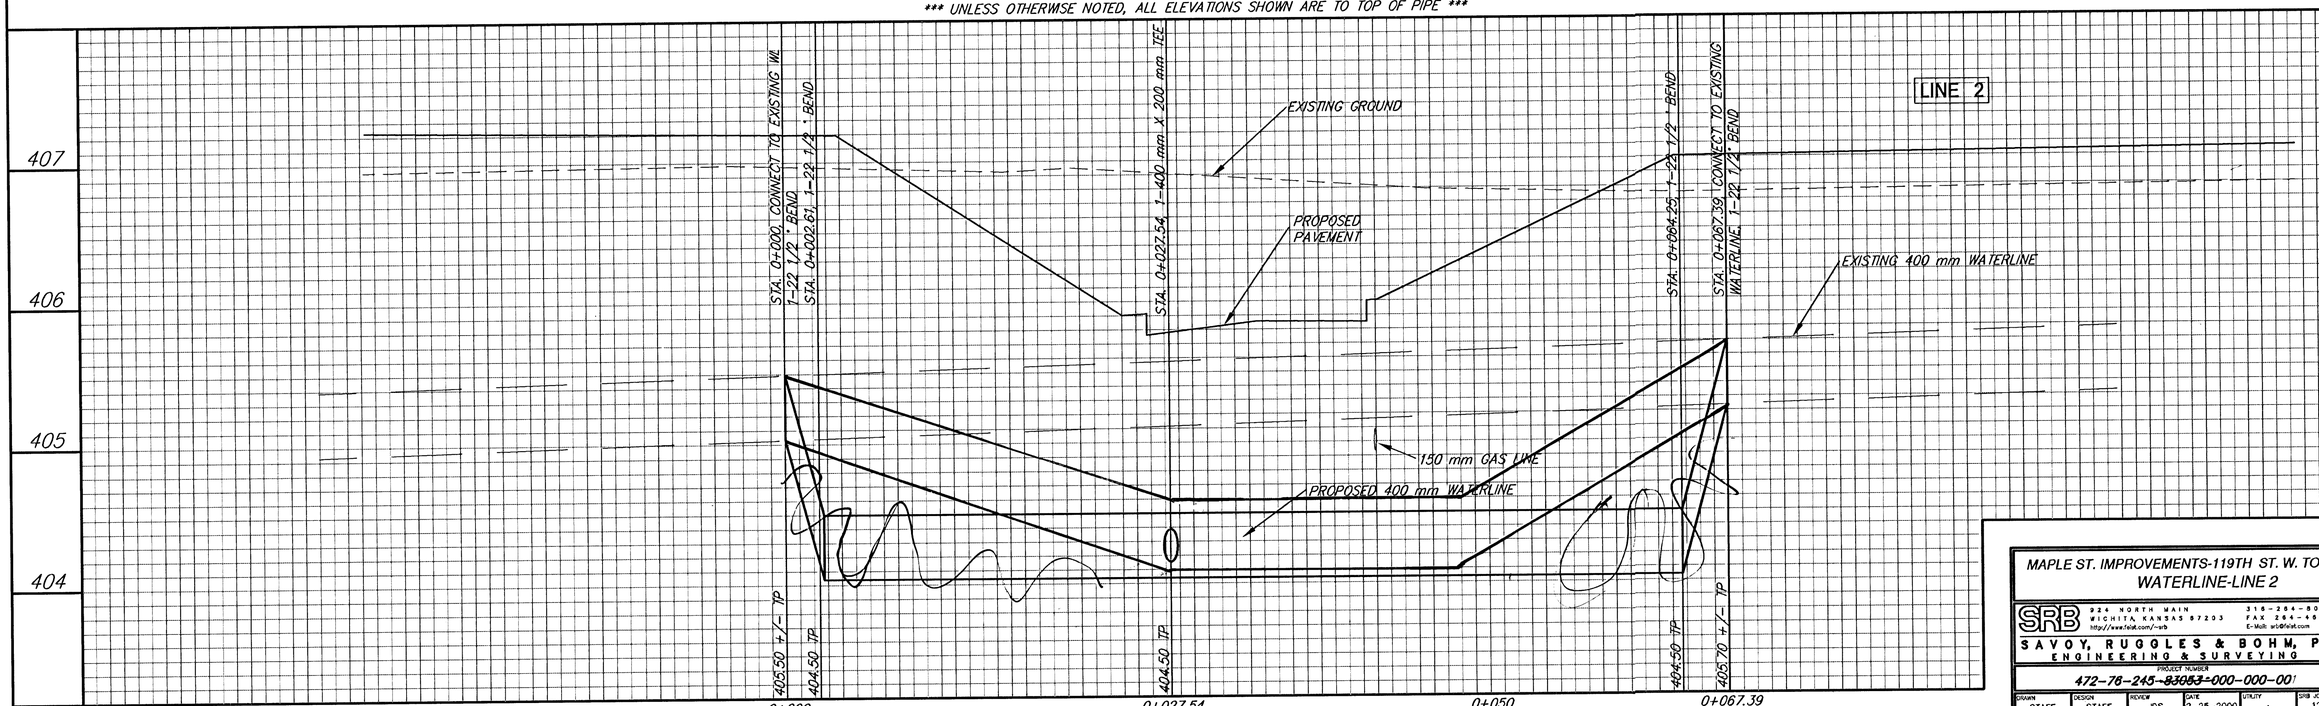

MAPLE ST. IMPROVEMENTS-119TH ST. W. TO MAIZE RD.
WATERLINE-LINE 2

SRB
924 NORTH MAIN
WICHITA KANSAS 67203
http://www.feik.com/~srb
316-264-8008
FAX 264-4821
E-Mail: srb@feik.com
SAVOY, RUGGLES & BOHM, P. A.
ENGINEERING & SURVEYING

PROJECT NUMBER
472-76-245-~~83083~~-000-000-001

DRAWN	DESIGN	REVIEW	DATE	UTILITY	SRB JOB
STAFF	STAFF	JOS	2-25-2000	-	1216T

REVISED

DWG. NO. Water02.dwg

44
90