
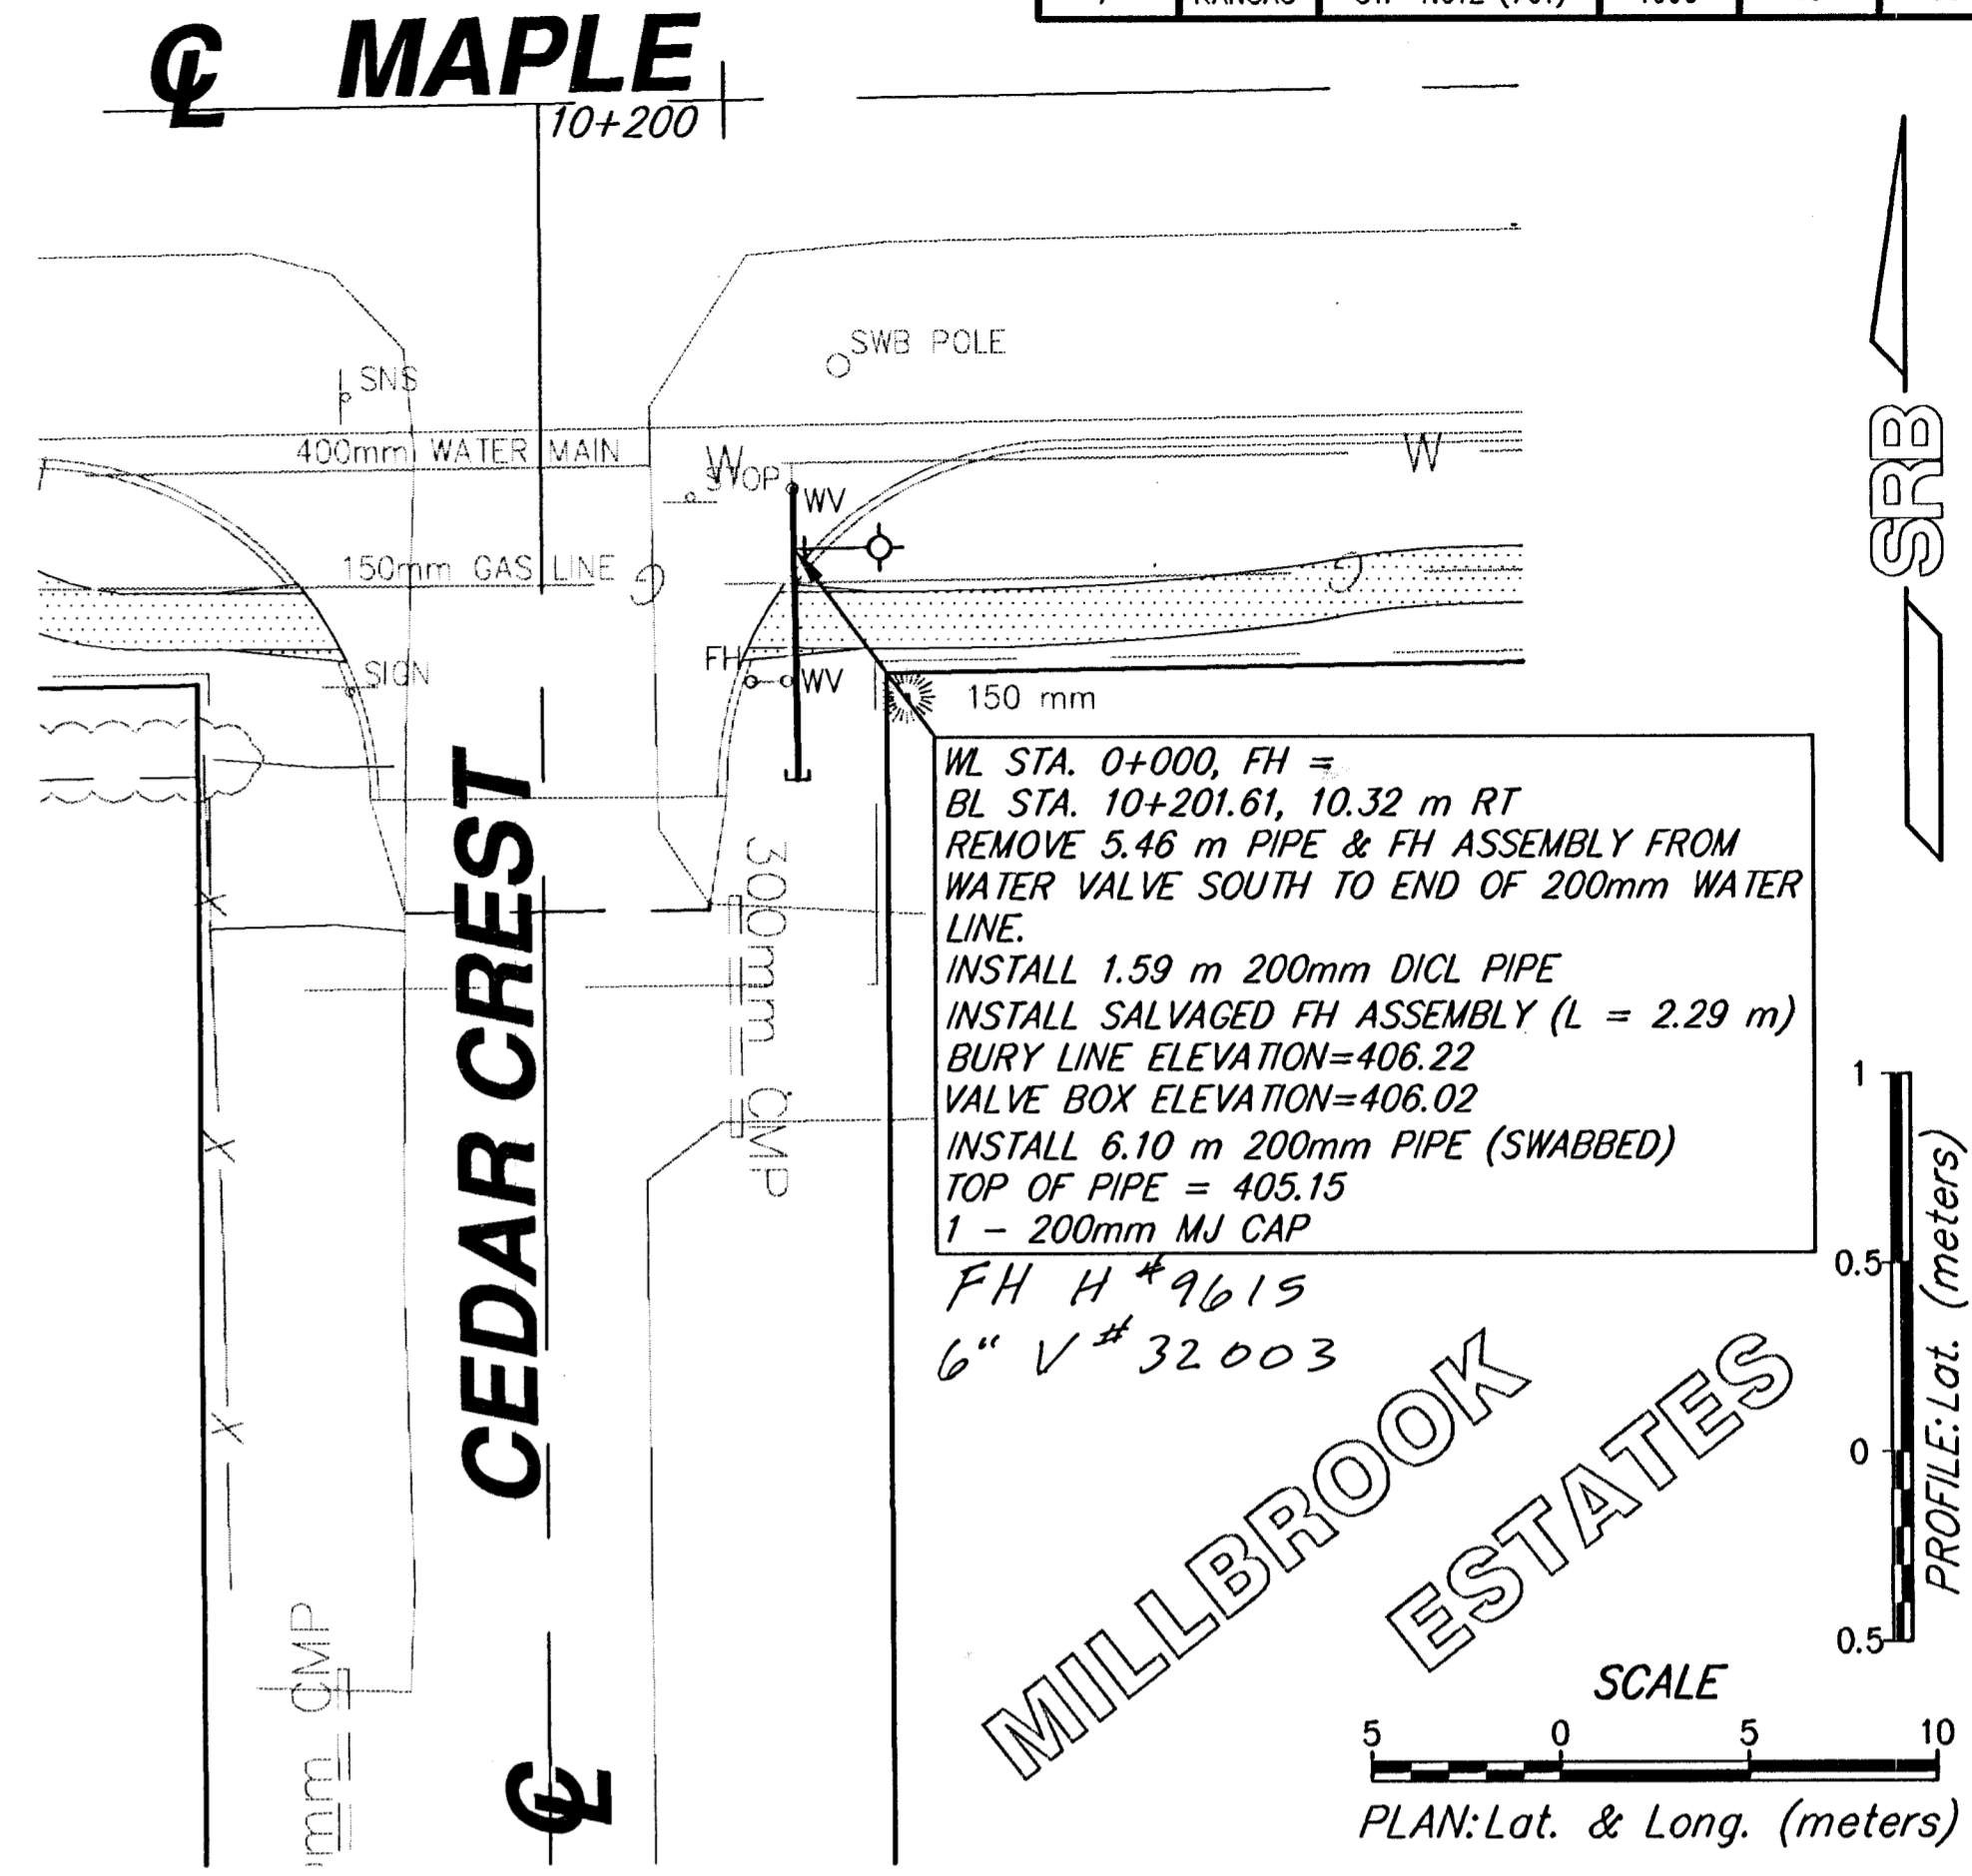
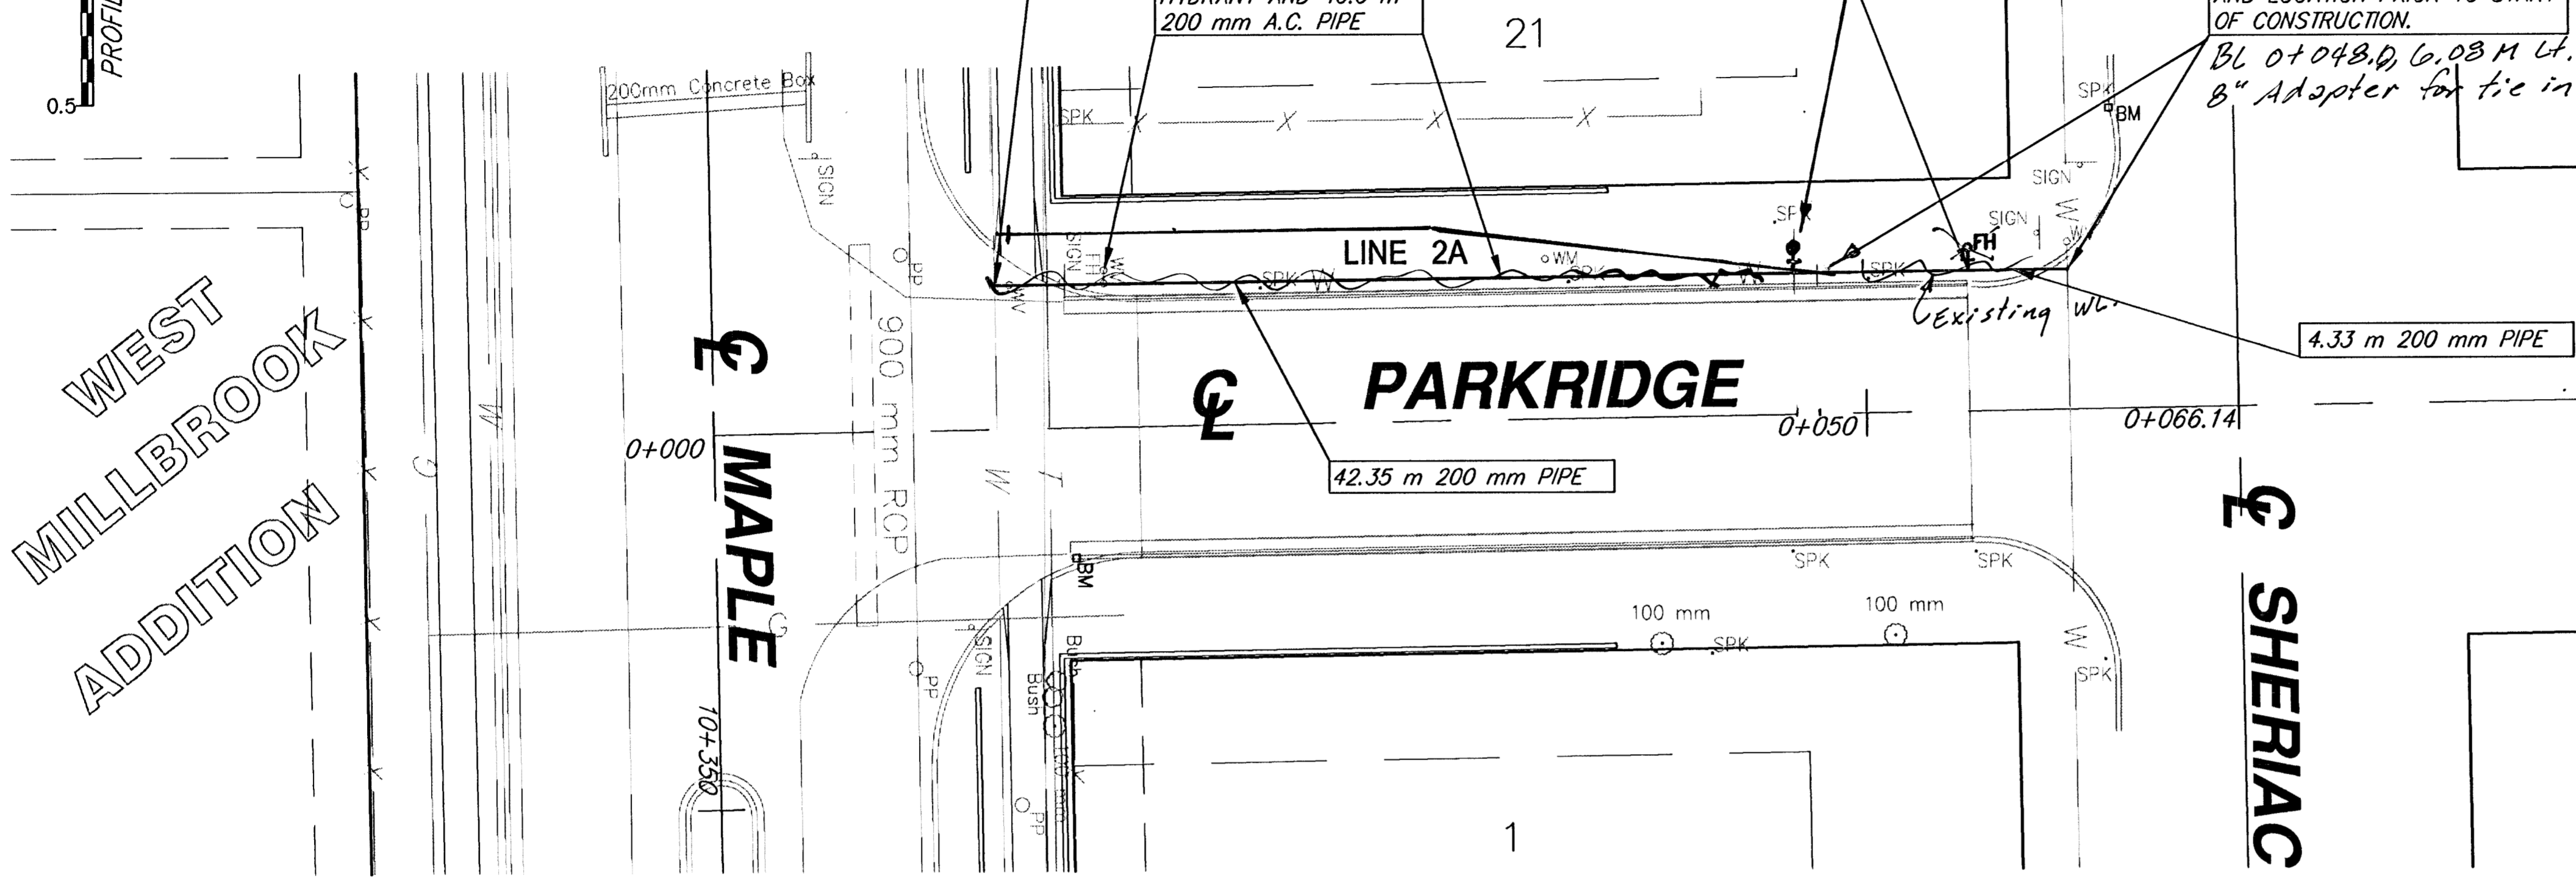



FHWA REGION NO.	STATE	PROJECT NUMBER	FISCAL YEAR	SHEET NUMBER	TOTAL SHEETS
7	KANSAS	STP-NO12 (701)	1999	45	90

DATE	BY

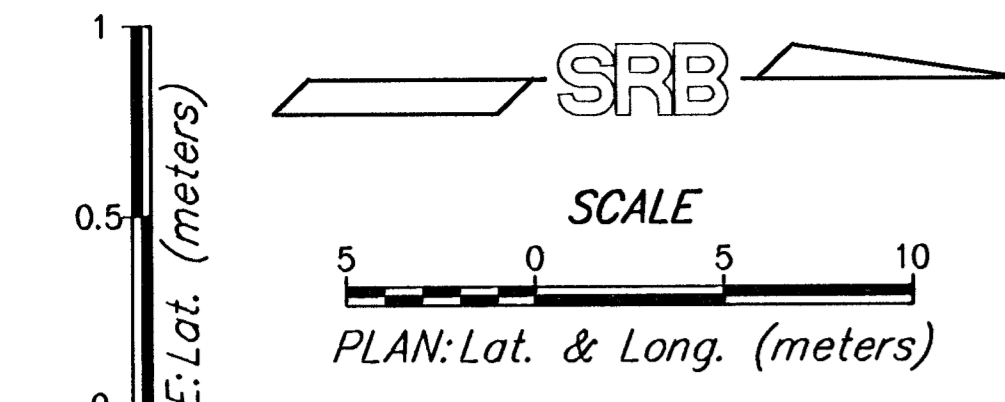

*** UNLESS OTHERWISE NOTED, ALL ELEVATIONS SHOWN ARE TO TOP OF PIPE ***

*** UNLESS OTHERWISE NOTED, ALL ELEVATIONS SHOWN ARE TO TOP OF PIPE ***

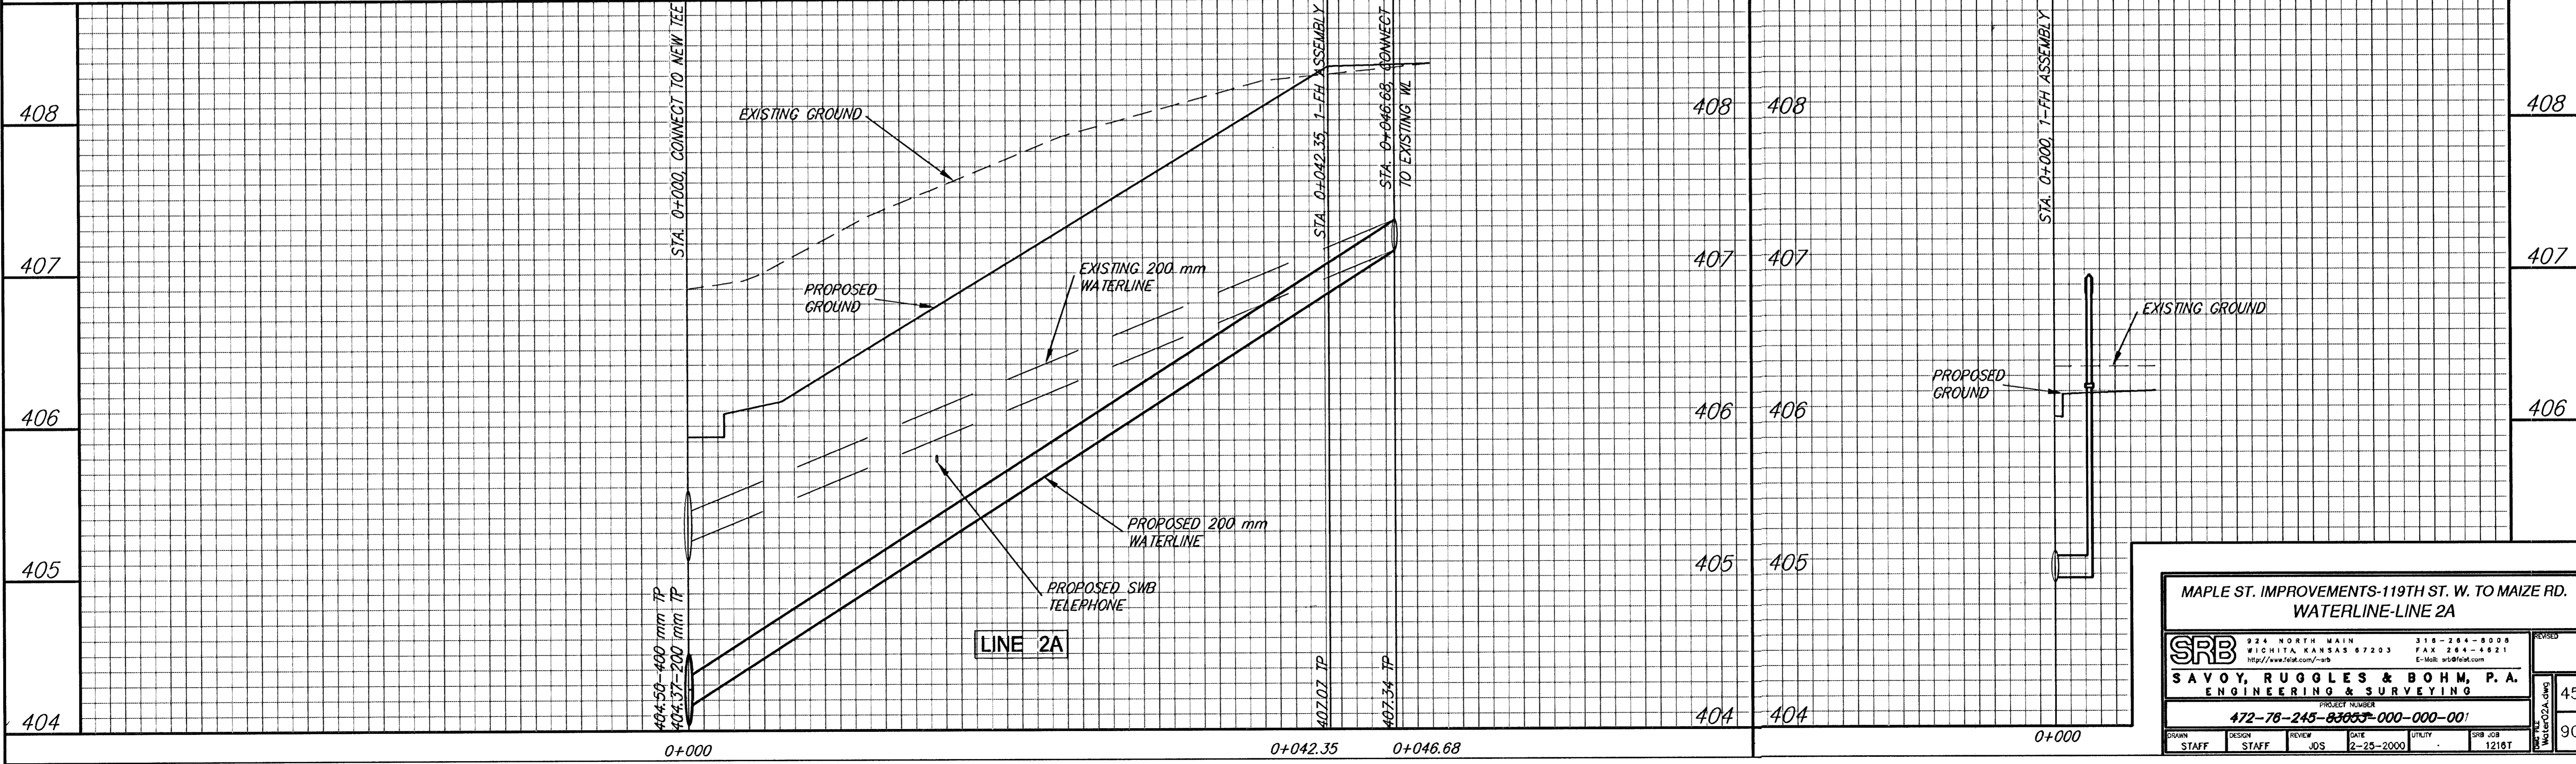

MAPLE ST. IMPROVEMENTS-119TH ST. W. TO MAIZE RD. WATERLINE-LINE 2A

SRB 324 NORTH MAIN WICHITA, KANSAS 67203
313-264-8008 FAX 264-4821
http://www.srb.com/~srb E-Mail: ars@srb.com

SAVOY, RUGGLES & BOHM, P.A.
ENGINEERING & SURVEYING

PROJECT NUMBER: 472-76-245-83053-000-000-001

DATE: 2-25-2000

DESIGN STAFF: JDS

REVISION: 1219T

45
90