
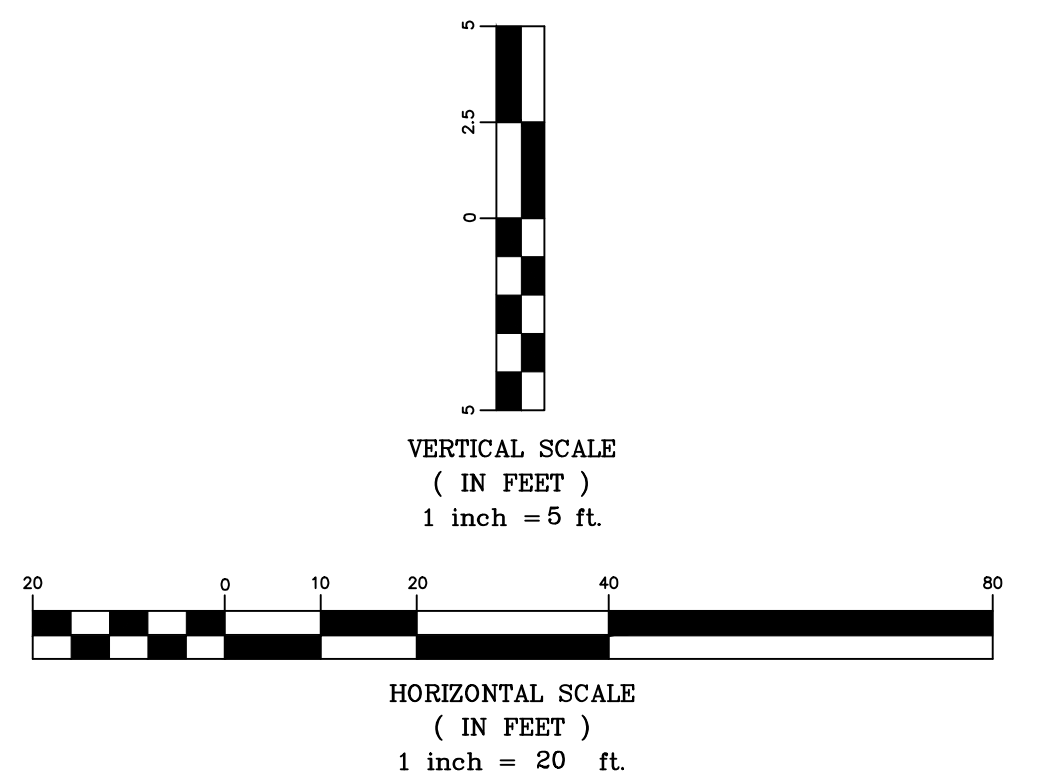


THIS SHEET HAS BEEN SIGNED, SEALED AND DATED DIGITALLY

Line 1

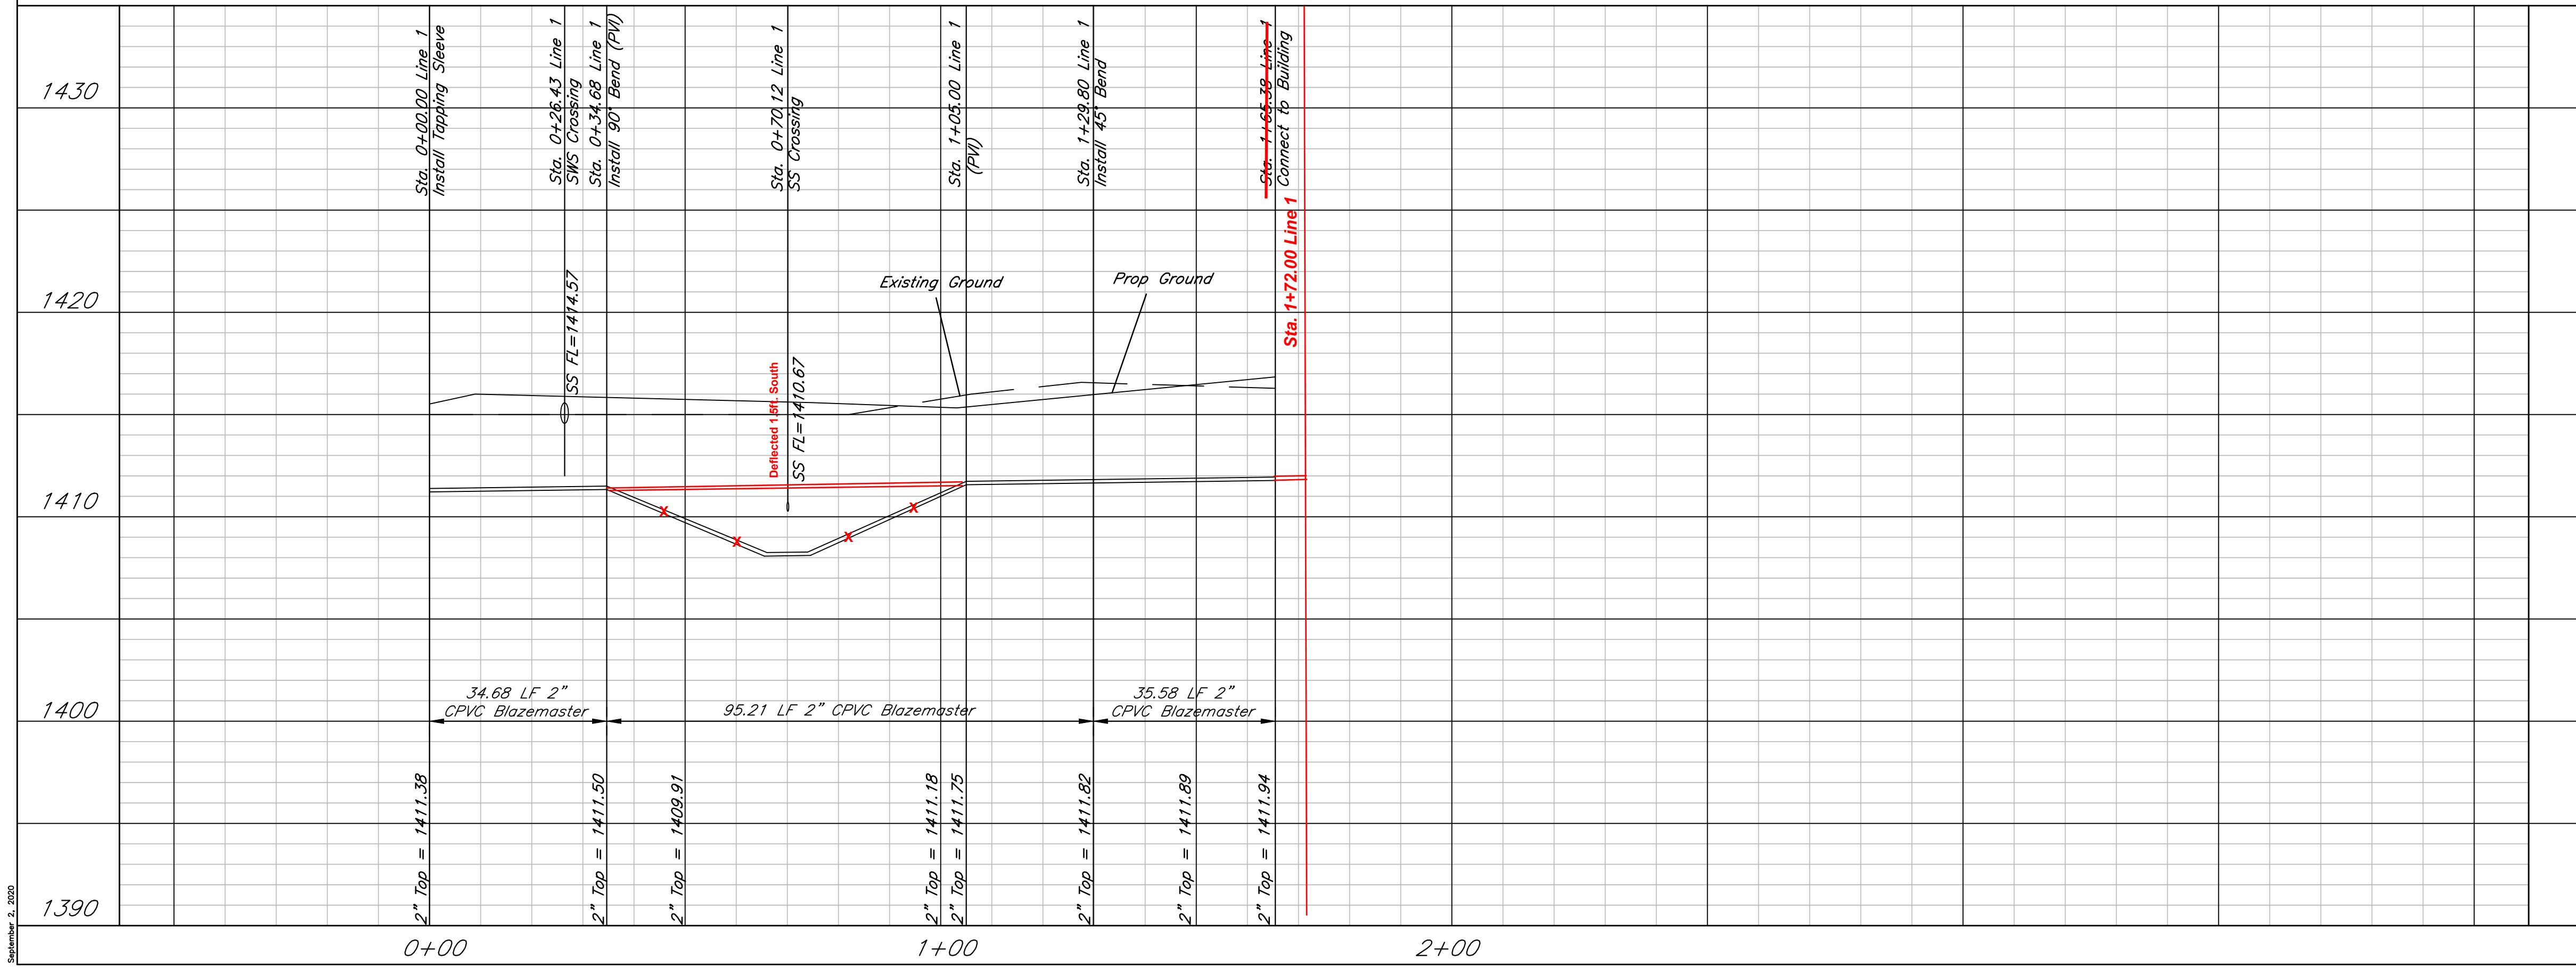

Cerebral Palsy Research Foundation
Plan & Profile Line 1
Wichita, Kansas

	PROJECT NUMBER PPW-2020-017740 (183021)			SHEET 3.0
	KEM NO. 20042 DESIGN KM	FILE DRAWN ZS	DATE 07/2020 REVISED	

September 2, 2020