



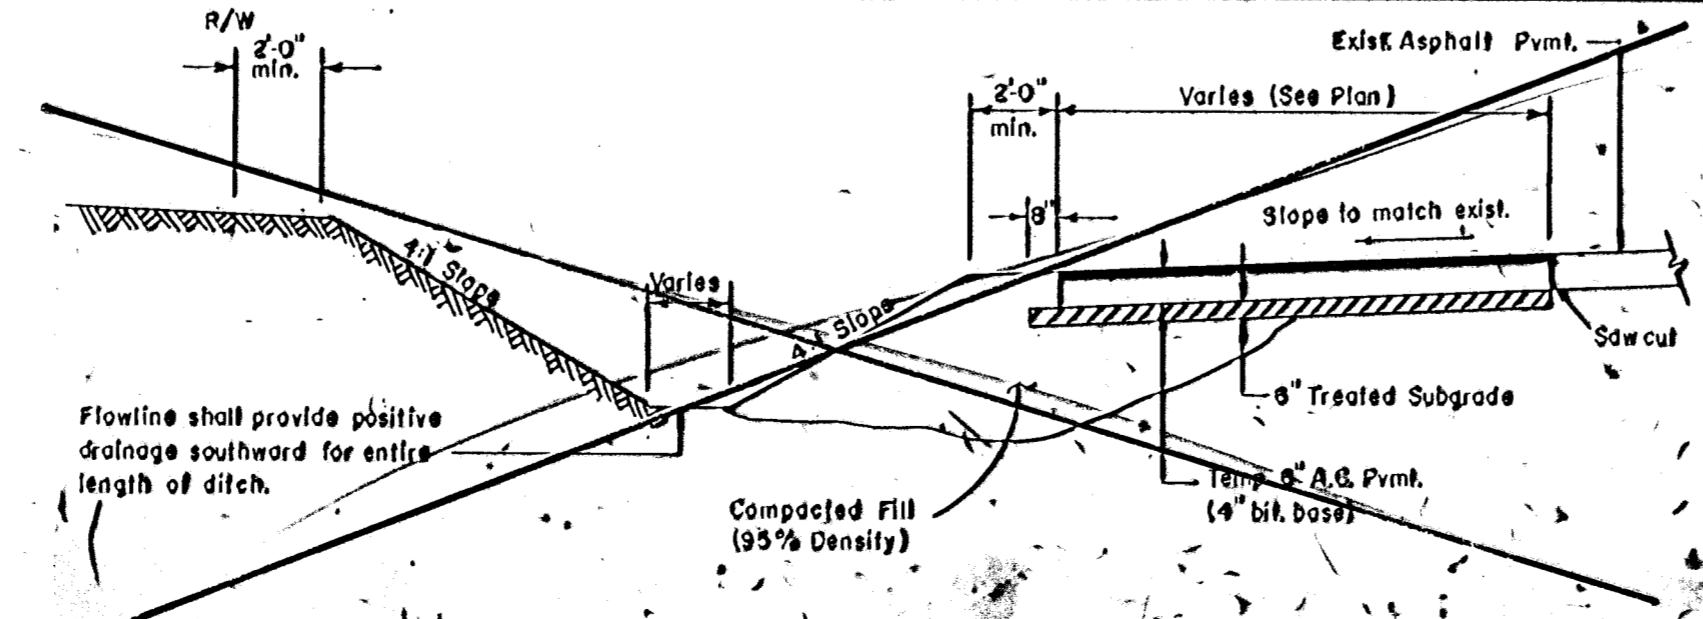

Scale: 1" = 20'

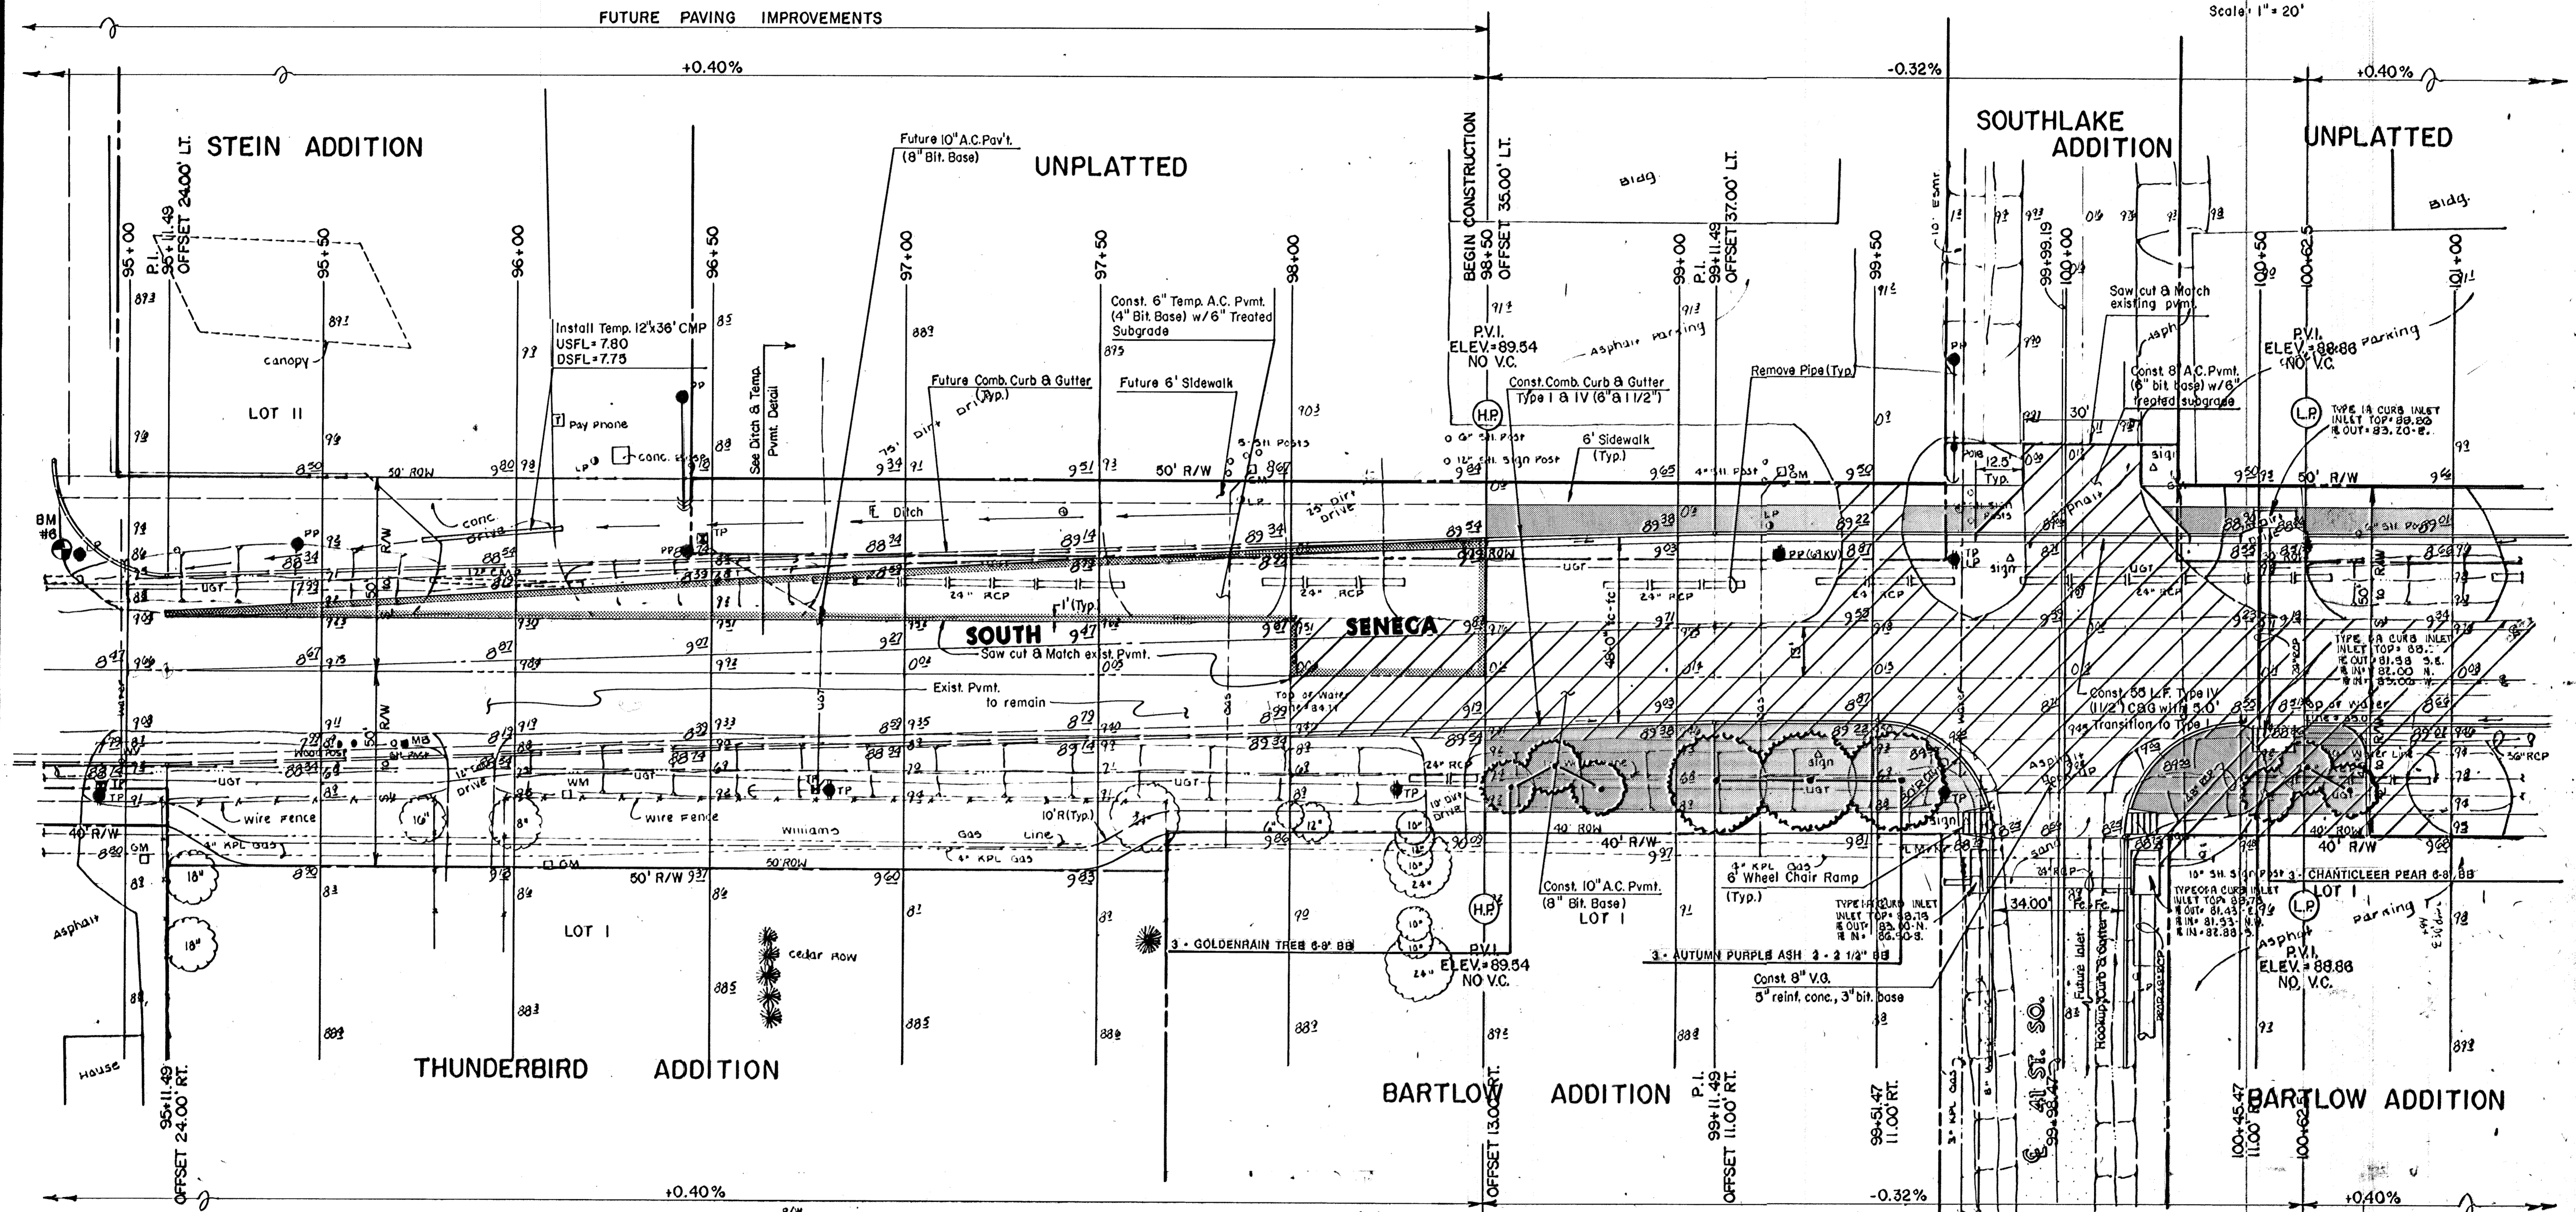

* For 2" depression, Subtract
0.31' from H.E. (0.17' from gutter E.)

	SOUTH SENECA IMPROVEMENTS	Design Drawn by Checked by Date Job No.
	LANDSCAPE PLAN 48TH ST. SO. TO MACARTHUR RD.	Sheet 27 of 28

MID-KANSAS ENGINEERING CONSULTANTS PA
 3500 NORTH ROCK ROAD
 BUILDING #800
 WICHITA, KANSAS 67220
 616-6666