




Scale: 1" = 20'

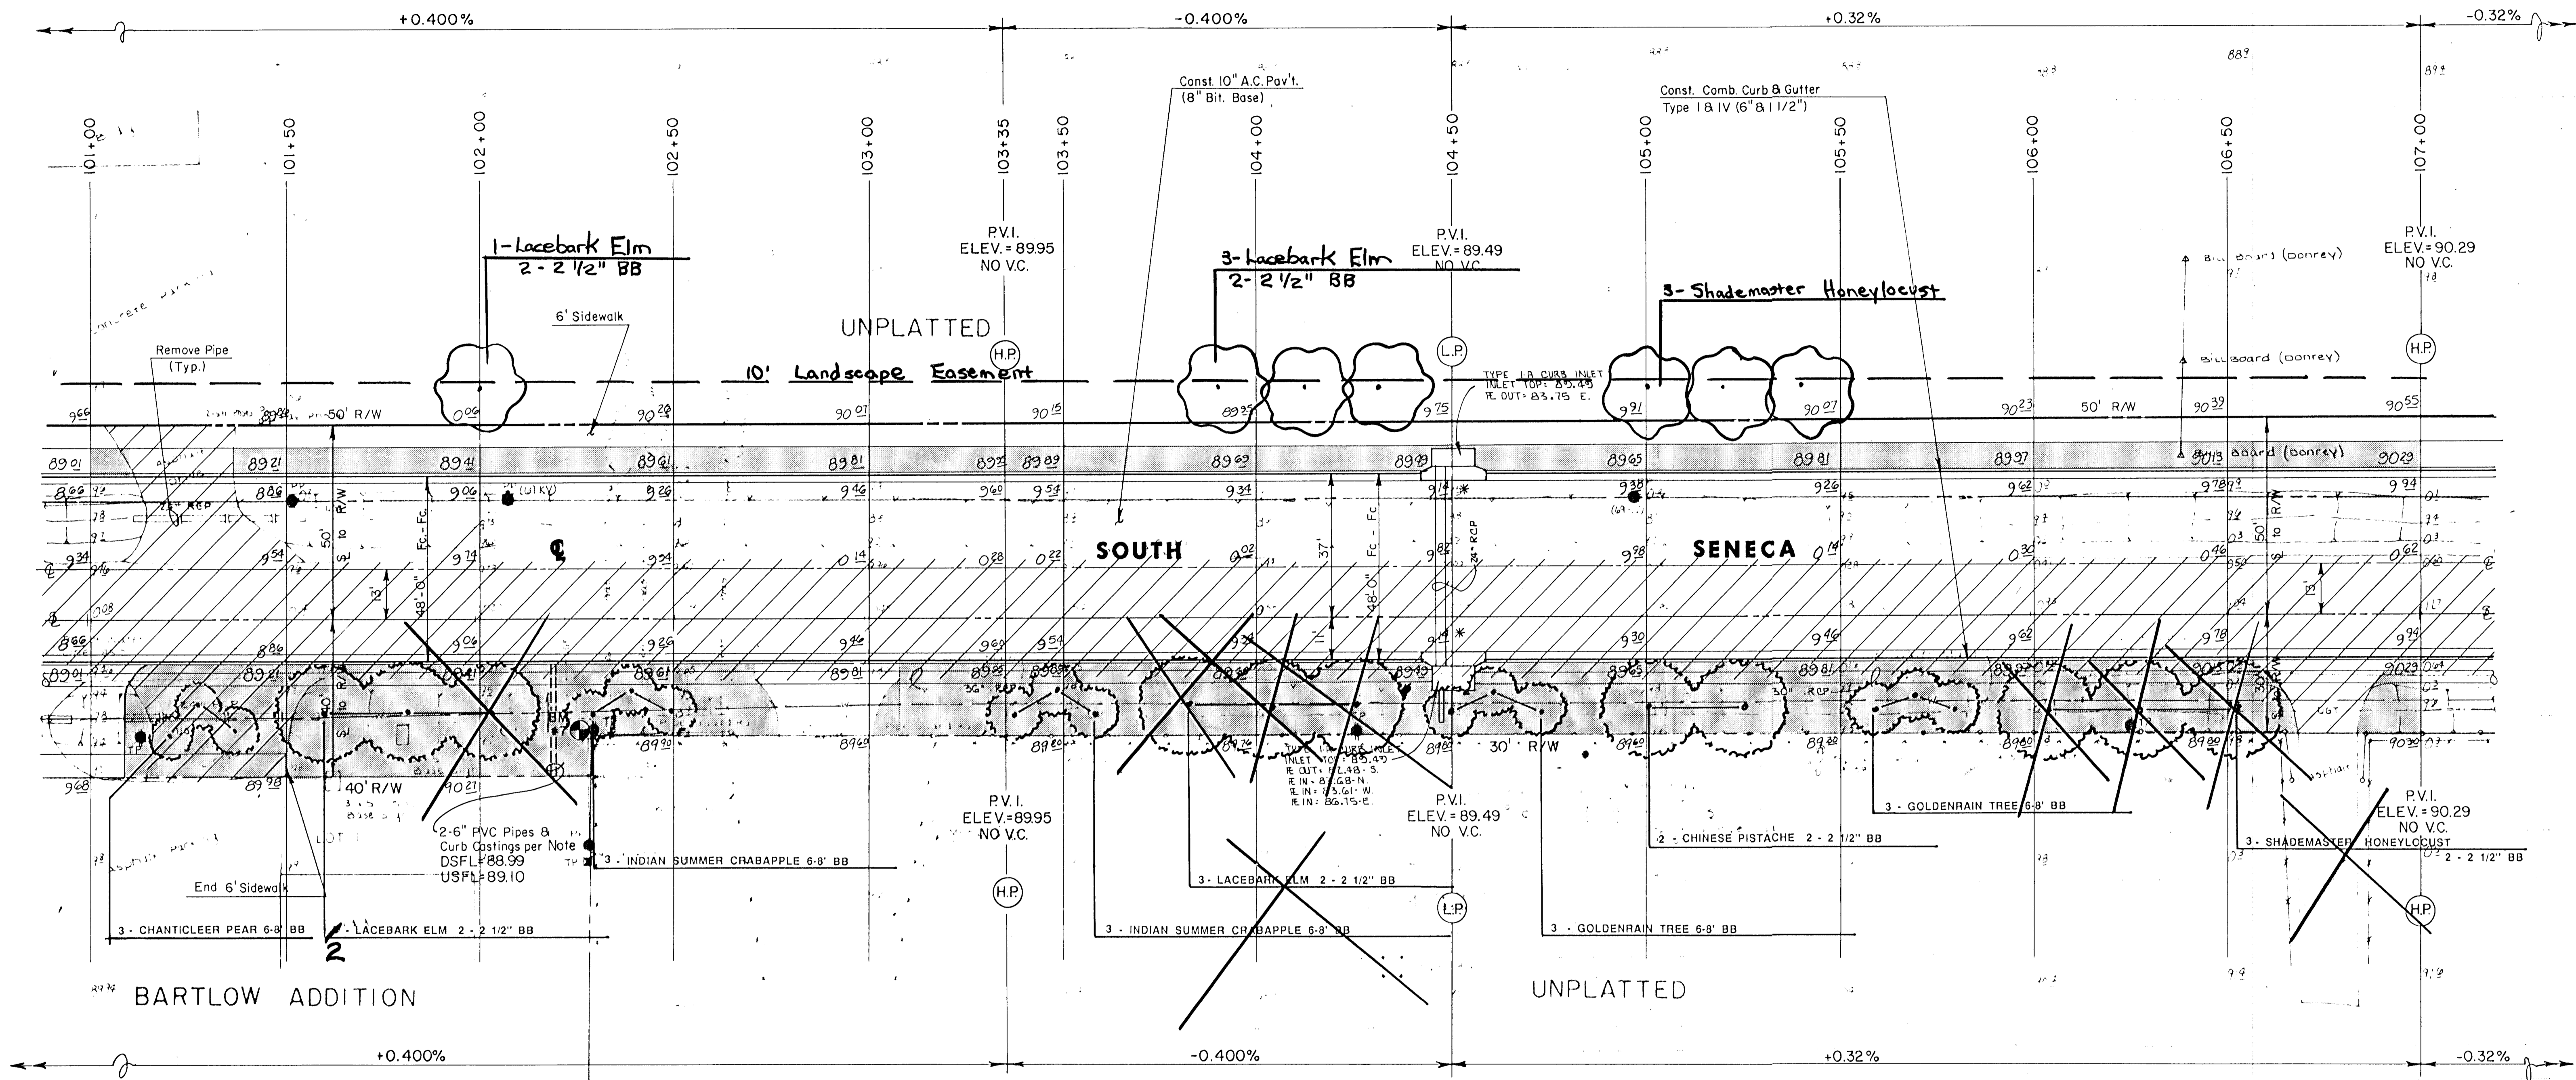

Note: Install 2 Curb Castings, Deeter #2449-B or approved equal, at curb & gutter. Casting units shall be bolted & anchored with galvanized 3/8" x 1 3/4" #2-1/2 bolts, respectively. Castings shall be painted two coats of grey paint, applied in accordance with manufacturer's recommendation.

Note: 17 trees originally to be planted on the east side of Seneca are now to be placed on the west side of Seneca.

* For 2" Depression, subtract 0.31' from H.E. (0.17' from gutter IL)

	SOUTH SENECA IMPROVEMENTS	Design	
	LANDSCAPE PLAN	Drawn by	
	48TH ST. SO. TO MACARTHUR RD.	Checked by	
		Date	
		Job no	
MID-KANSAS ENGINEERING CONSULTANTS PA 3500 NORTH ROCK ROAD BUILDING #800 WICHITA, KANSAS 67226	636-5566	Sheet	3
		of	8