


J:\PROJECTS\2019\1901010483_COW_BOTANICA PARKING EXPANSION.L 190483 CAD\SHS\190483-05-2021.DWG
 PLOTTED: Friday, July 23, 2021 @ 10:32AM


PAVING & DRAINAGE FOR
BOTANICA GARDENS PARKING LOT
 WICHITA, KANSAS

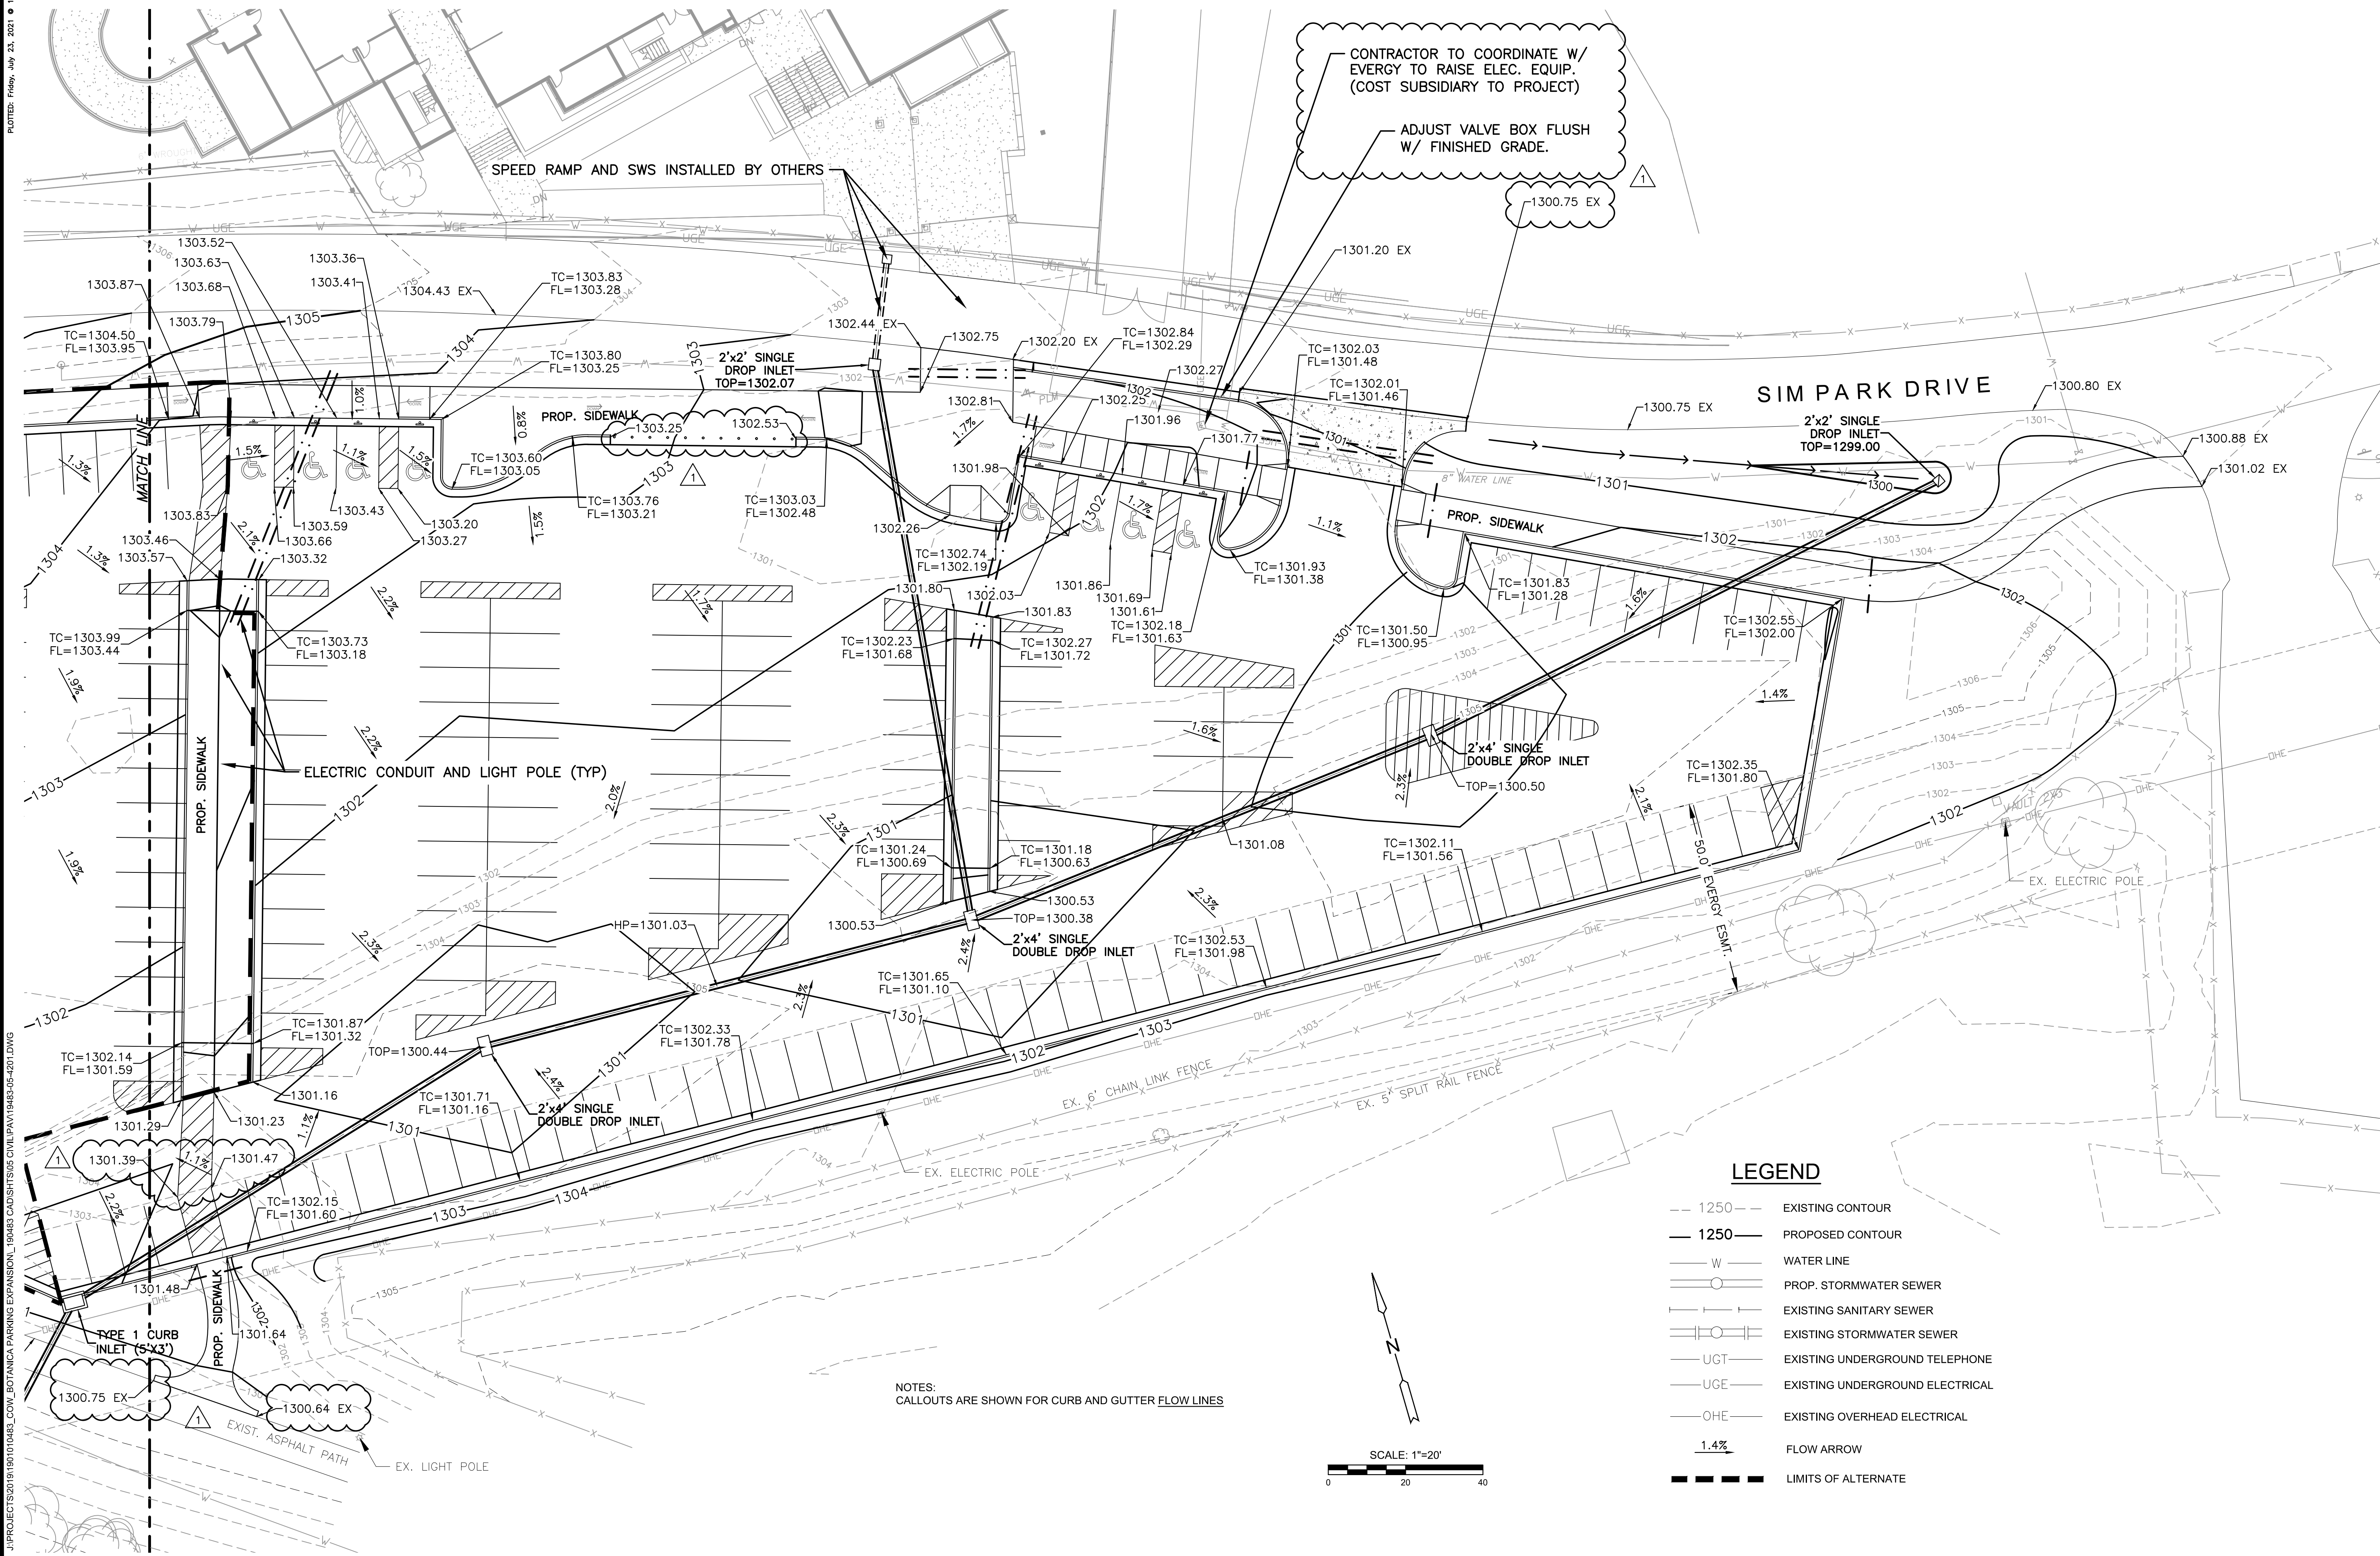

LEGEND

- 1250 --- EXISTING CONTOUR
- 1250 — PROPOSED CONTOUR
- W — WATER LINE
- ○ — PROP. STORMWATER SEWER
- — — EXISTING SANITARY SEWER
- ○ — EXISTING STORMWATER SEWER
- UGT — EXISTING UNDERGROUND TELEPHONE
- UGE — EXISTING UNDERGROUND ELECTRICAL
- OHE — EXISTING OVERHEAD ELECTRICAL
- 1.4% FLOW ARROW
- — — LIMITS OF ALTERNATE

NOTES:
 CALLOUTS ARE SHOWN FOR CURB AND GUTTER FLOW LINES

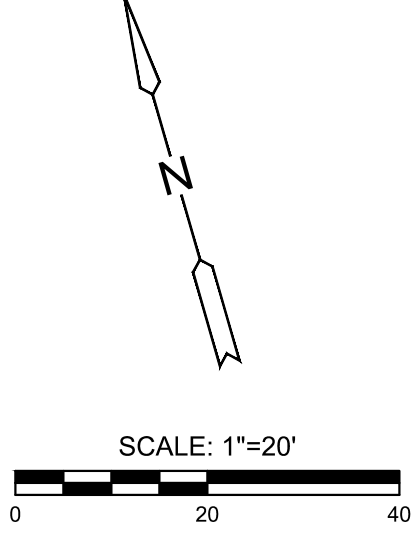

©2021 MKEC Engineering
 All Rights Reserved
 www.mkec.com
 These drawings and their contents, including, but not limited to, all concepts, designs, & ideas are the exclusive property of MKEC Engineering (MKEC), and may not be used or reproduced in any way without the express consent of MKEC.

GRADING PLAN 2		
PROJECT NO.	482-11034	
DATE	JULY 2021	
SCALE	1"=20'	
DESIGNED	DRAWN	CHECKED
JAG	CRM	GJA
NO.	REVISION	DATE
1	REVISED CALLOUTS	07.23.21
SHEET NO.		
08 OF 31		