



PLOTTED: Friday, July 23, 2021 @ 11:13AM

J:\PROJECTS\2019\1901010483\_COW\_BOTANICA PARKING EXPANSION\190483 CAD\SHOTS\05 CIVIL\SWIS\190483-05-2020.DWG

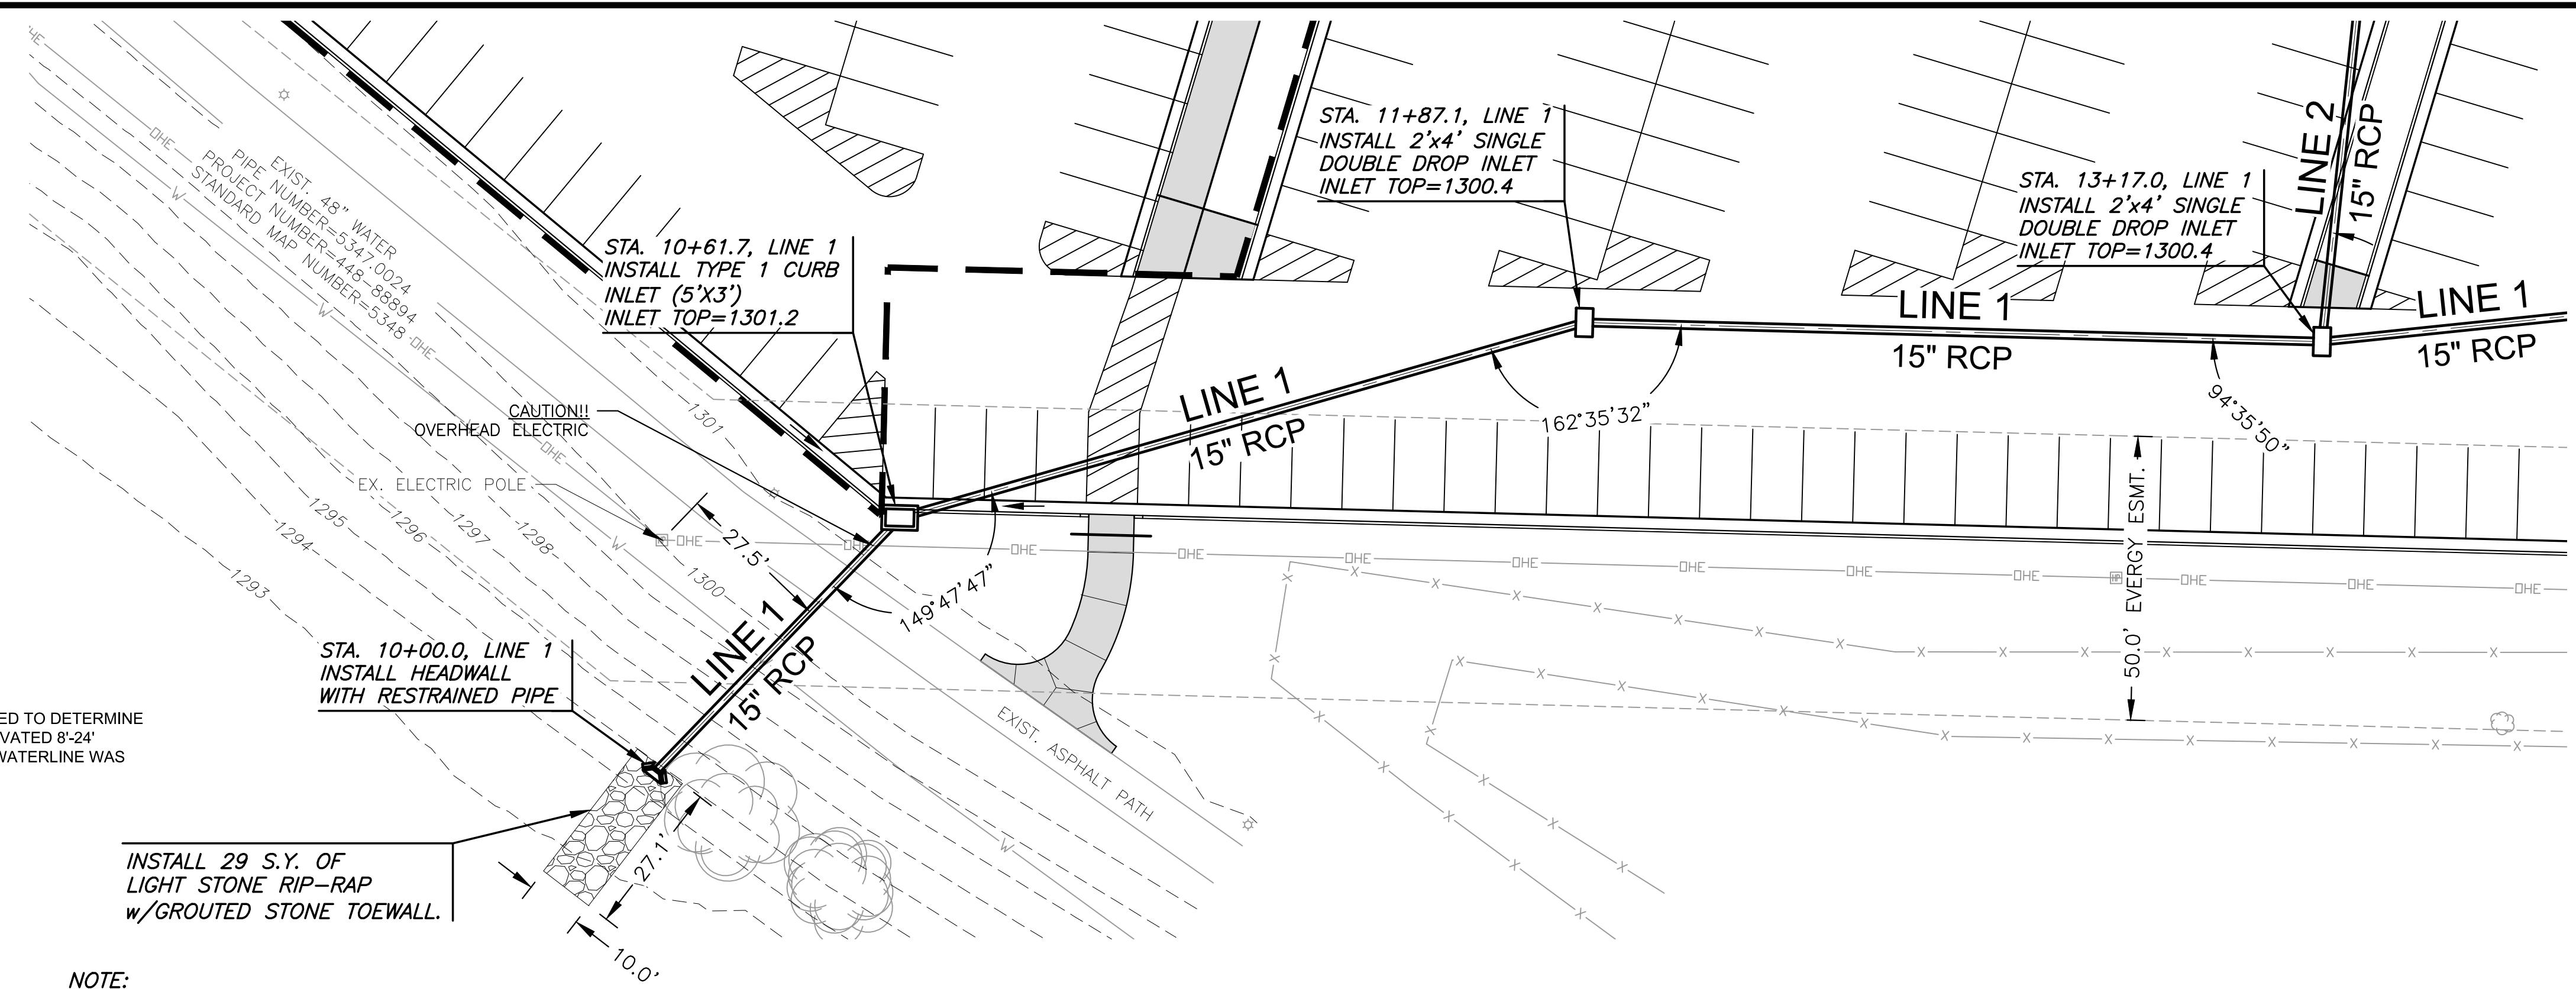


NOTE:  
EXIST. 48" WATER WAS POTHOLED/TRENCHED TO DETERMINE  
LOCATION AND DEPTH. TRENCH WAS EXCAVATED 8'-24"  
SOUTH OF WALKWAY TO A DEPTH OF -8'. WATERLINE WAS  
NOT FOUND.

NOTE:  
CONTRACTOR TO VERIFY THE  
DEPTH AND LOCATION OF EXISTING  
UTILITIES PRIOR TO CONSTRUCTION.

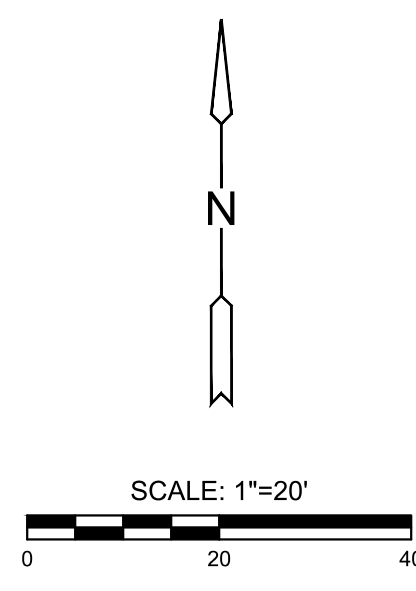

PLAN LINE 1  
PROFILE LINE 1

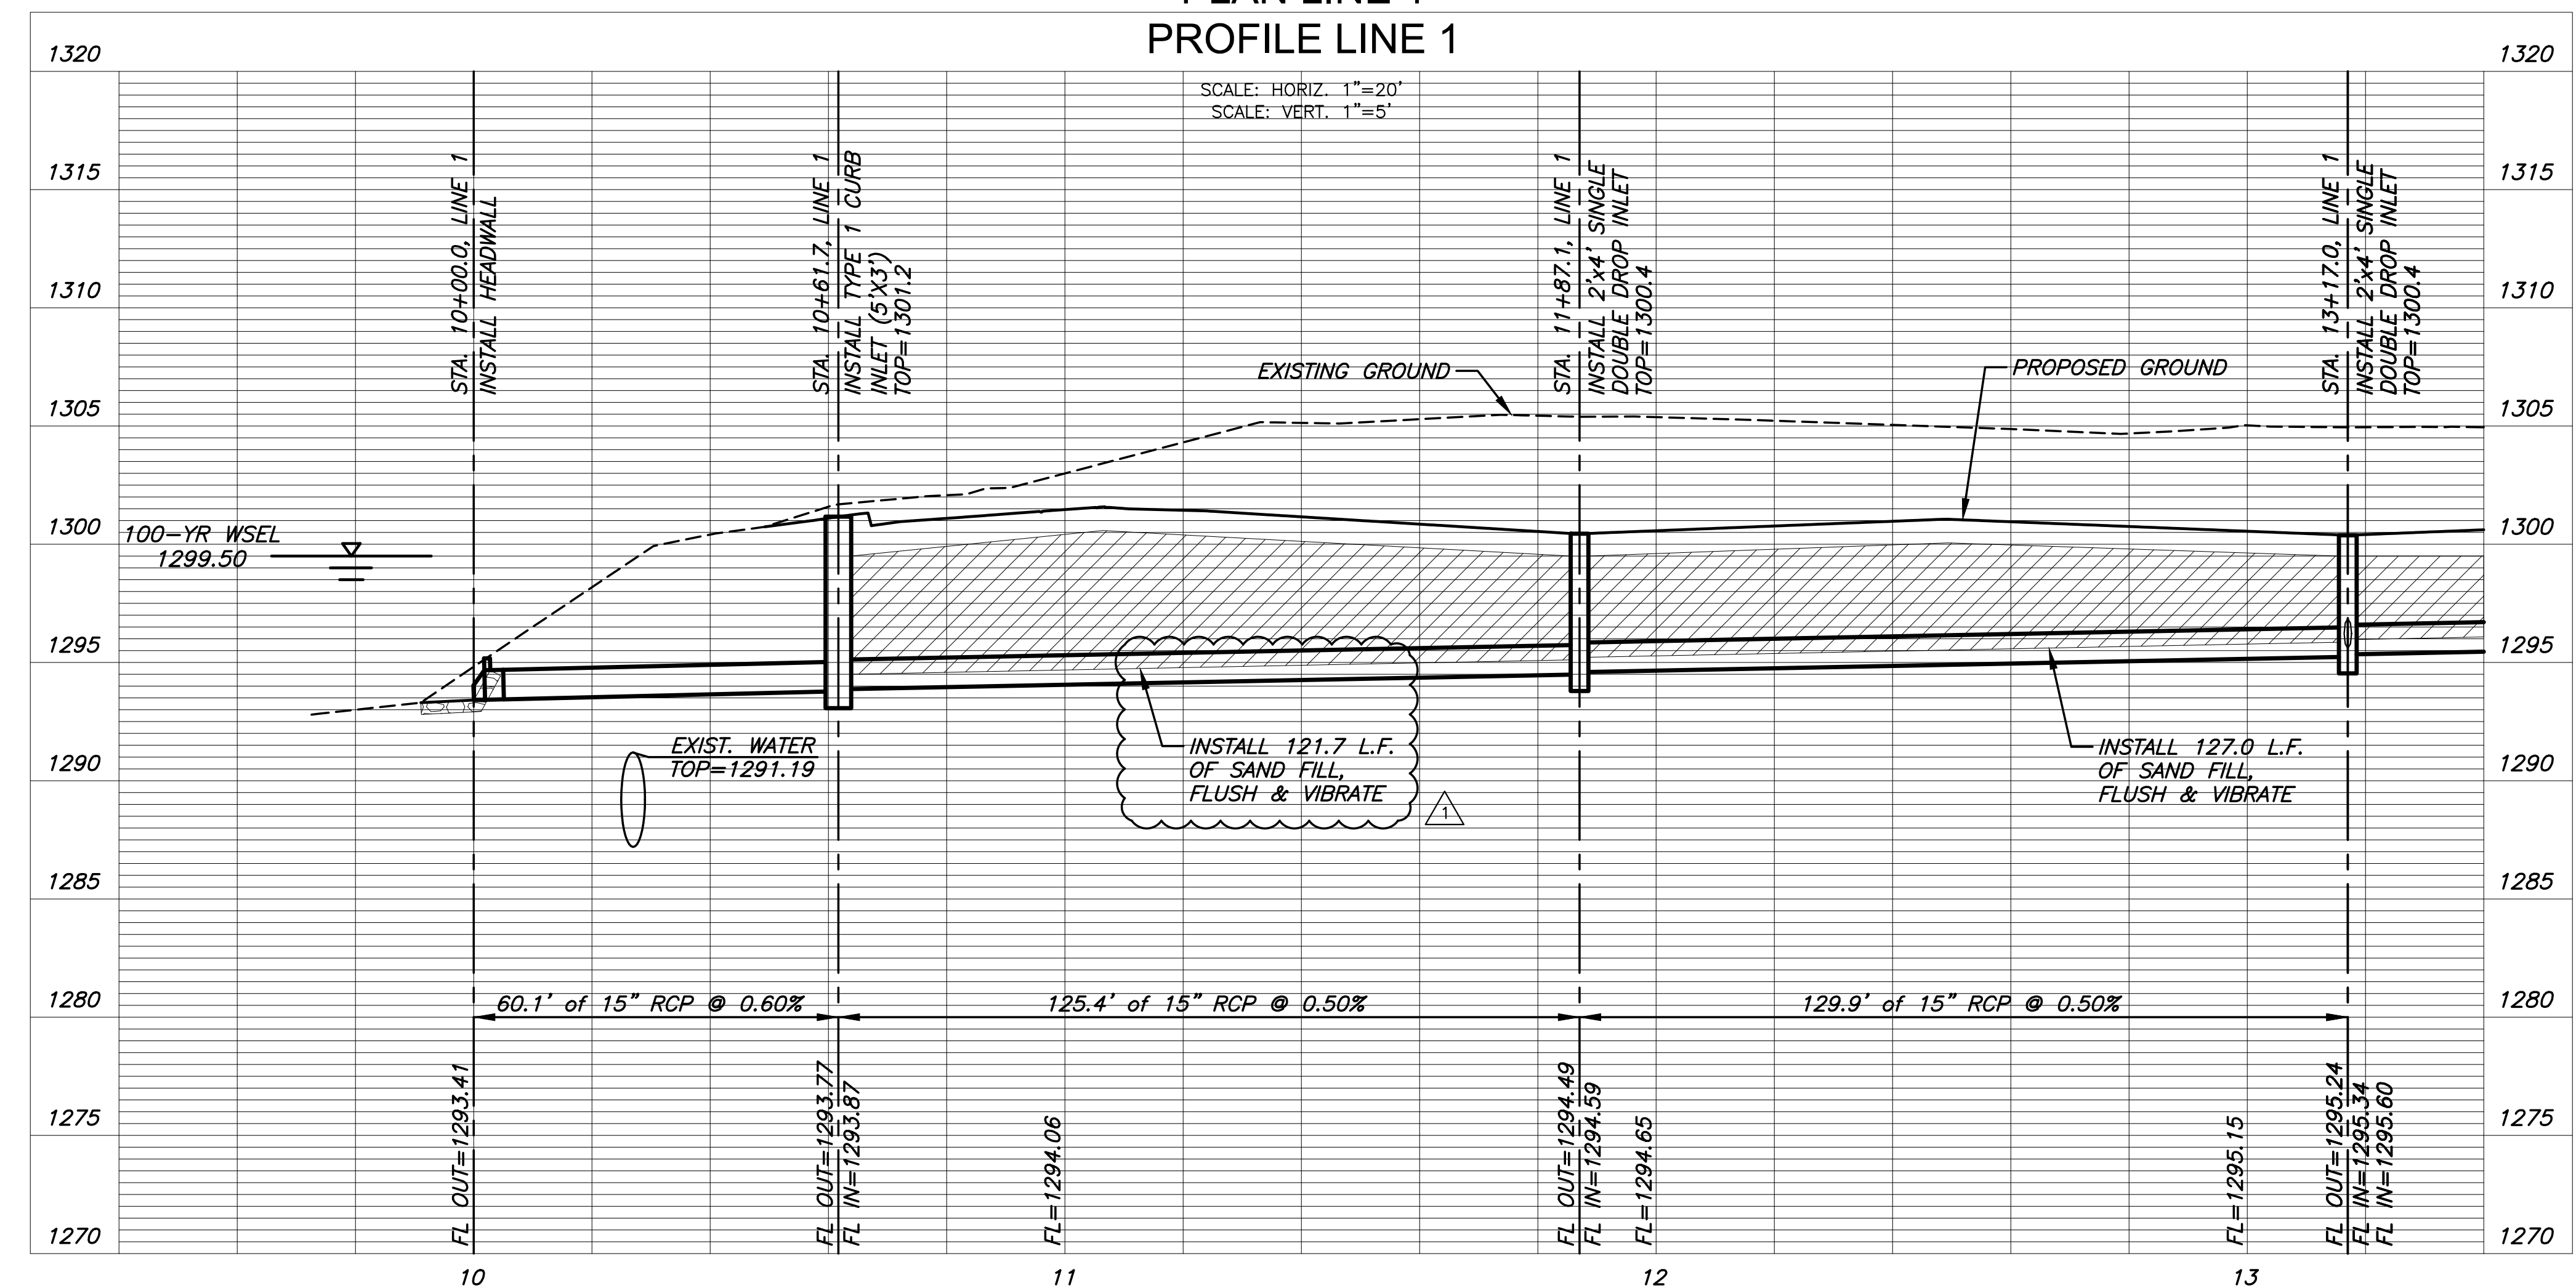

PAVING & DRAINAGE FOR  
**BOTANICA GARDENS PARKING LOT**  
WICHITA, KANSAS

©2021  
MKEC Engineering  
All Rights Reserved  
www.mkec.com  
These drawings and their contents,  
including, but not limited to, all concepts,  
designs, & ideas are the exclusive  
property of MKEC Engineering (MKEC),  
and may not be used or reproduced in any  
way without the express consent of MKEC.

LINE 1	
PROJECT NO.	482-11034
DATE	JULY 2021
SCALE	1"=20'
DESIGNED	DRAWN
JAG	CRM
CHECKED	GJA
NO.	REVISION
1	REVISED CALLOUTS
	DATE
	07.23.21
SHEET NO.	
16 OF 31	