


WHEATLAND ADDITION
SEDGWICK COUNTY, KANSAS

N.W. Cor., E. 1/2,
N.E. 1/4, Sec. 15

N.E. Cor., Sec. 15,
T.28S., R.1W.

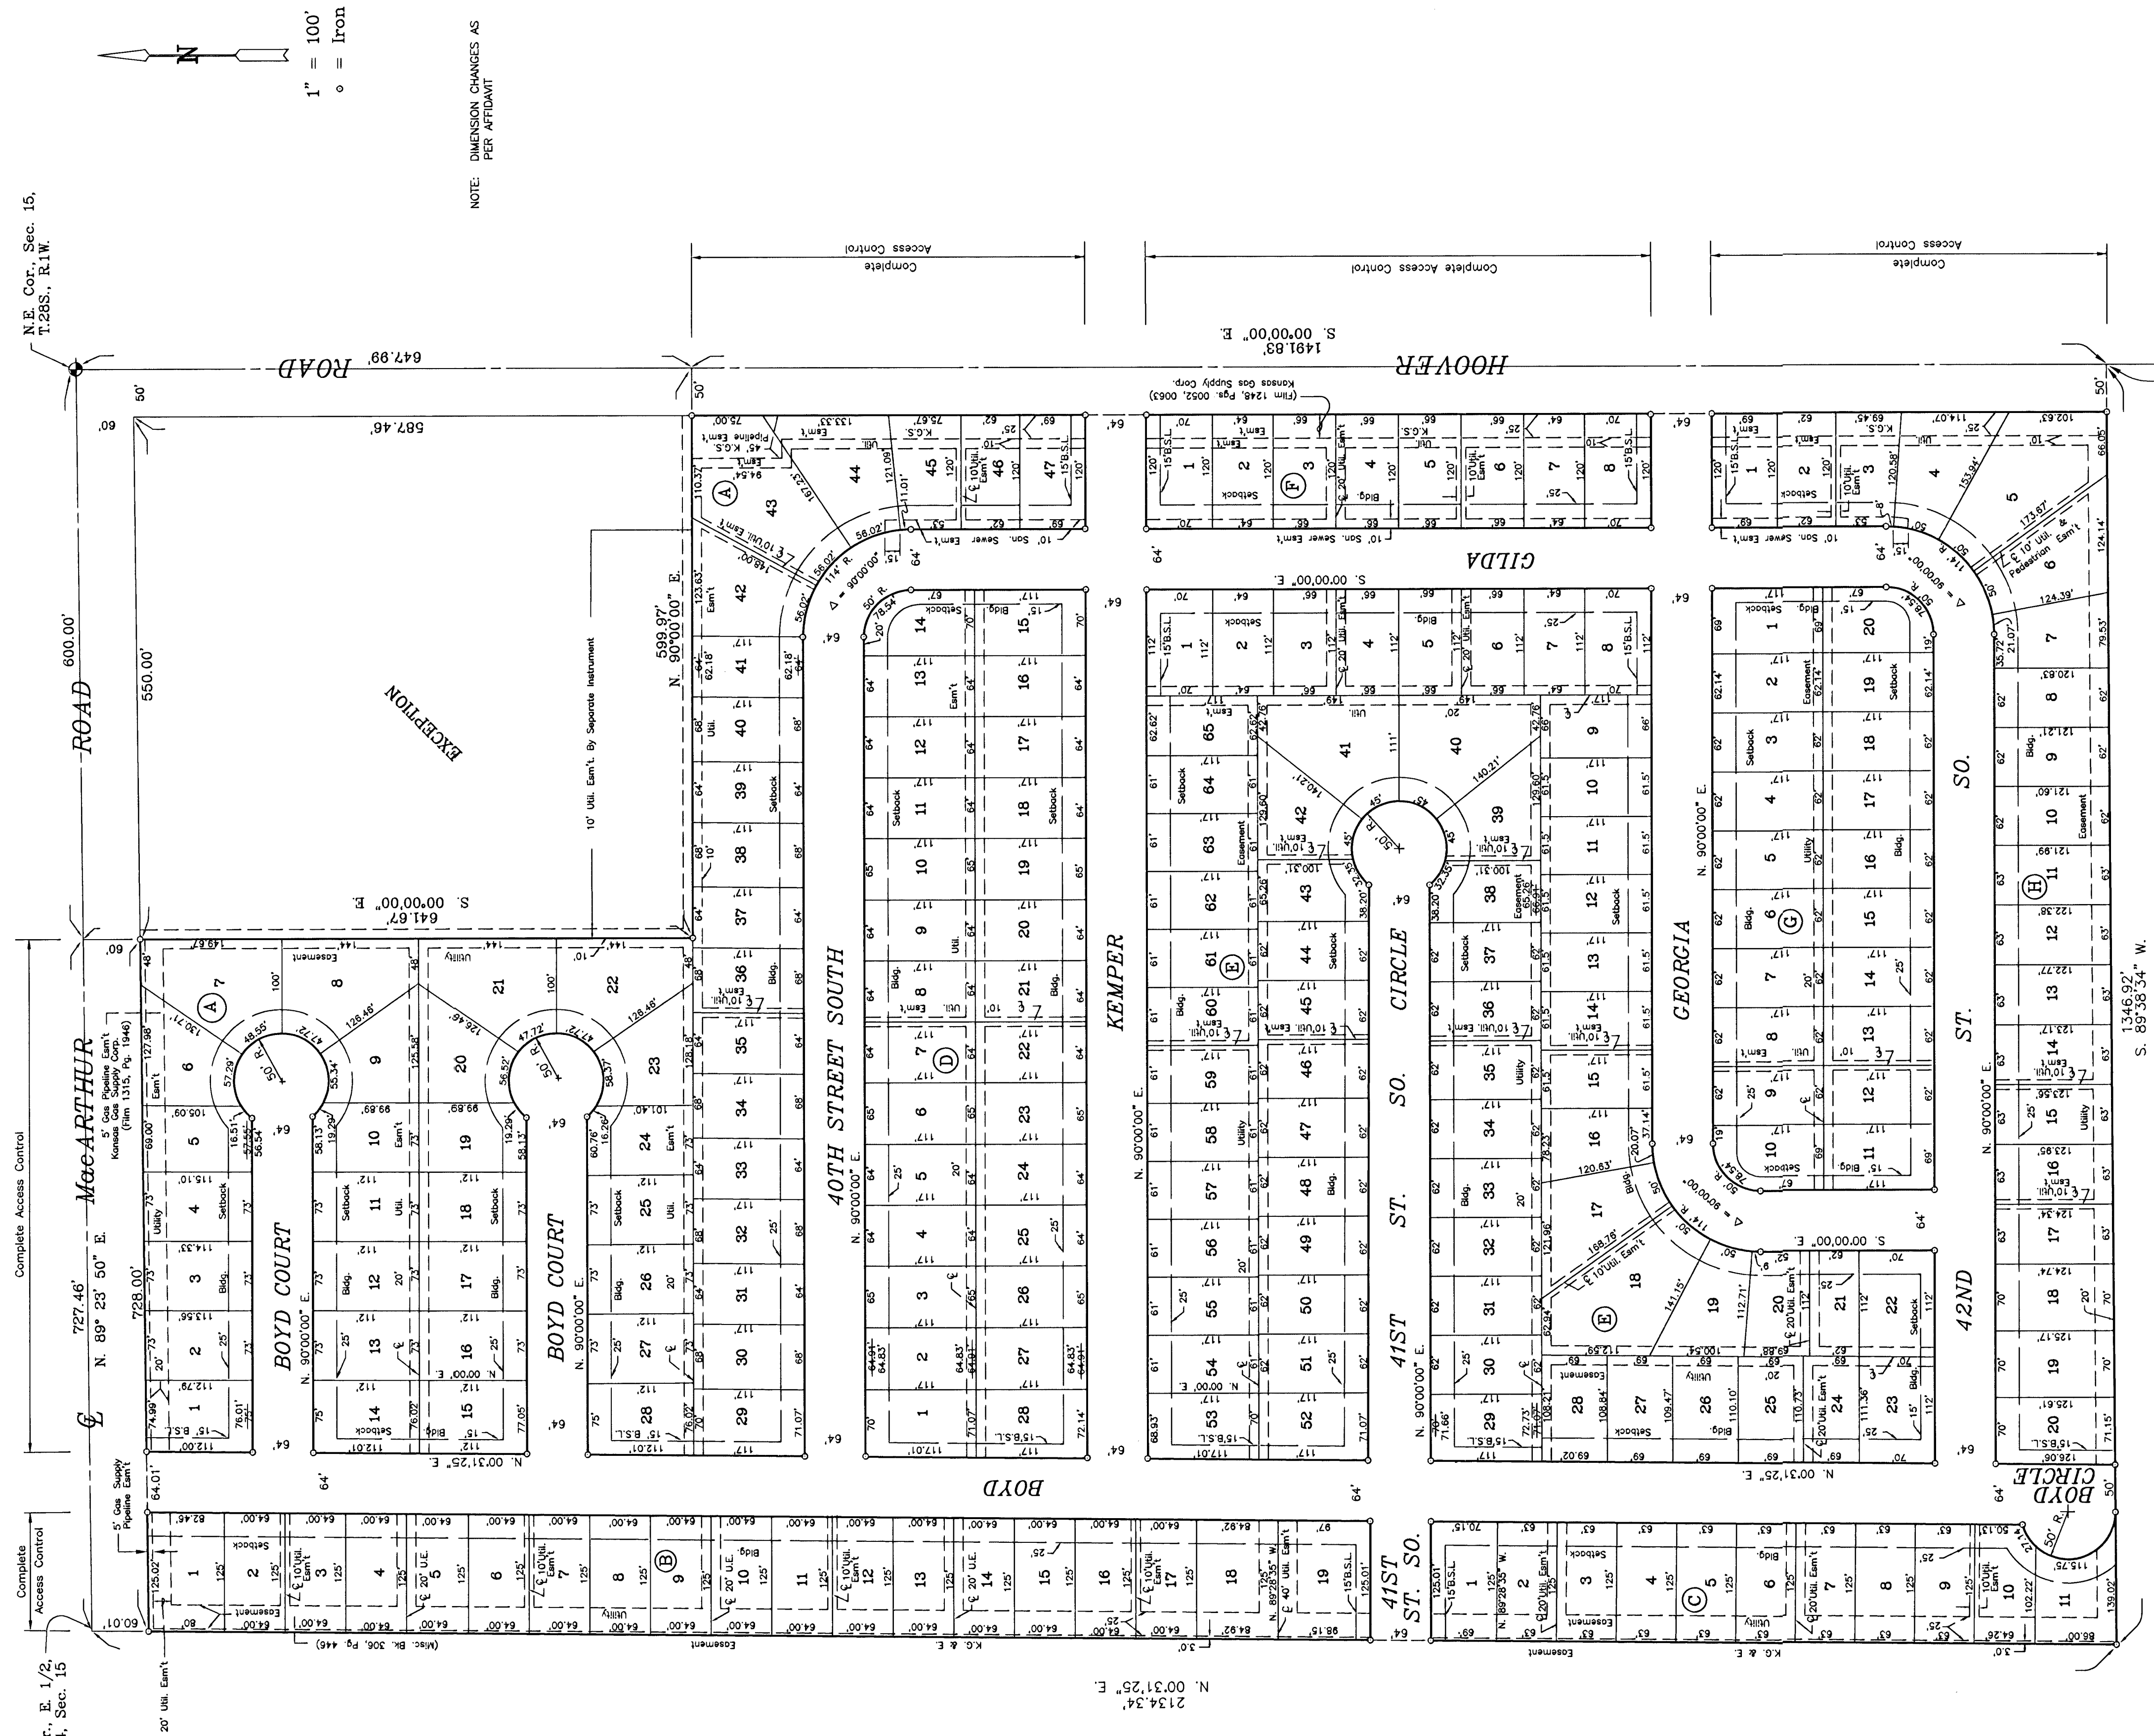

- S.E. Cor.
N.E. 1/4, Sec. 15