


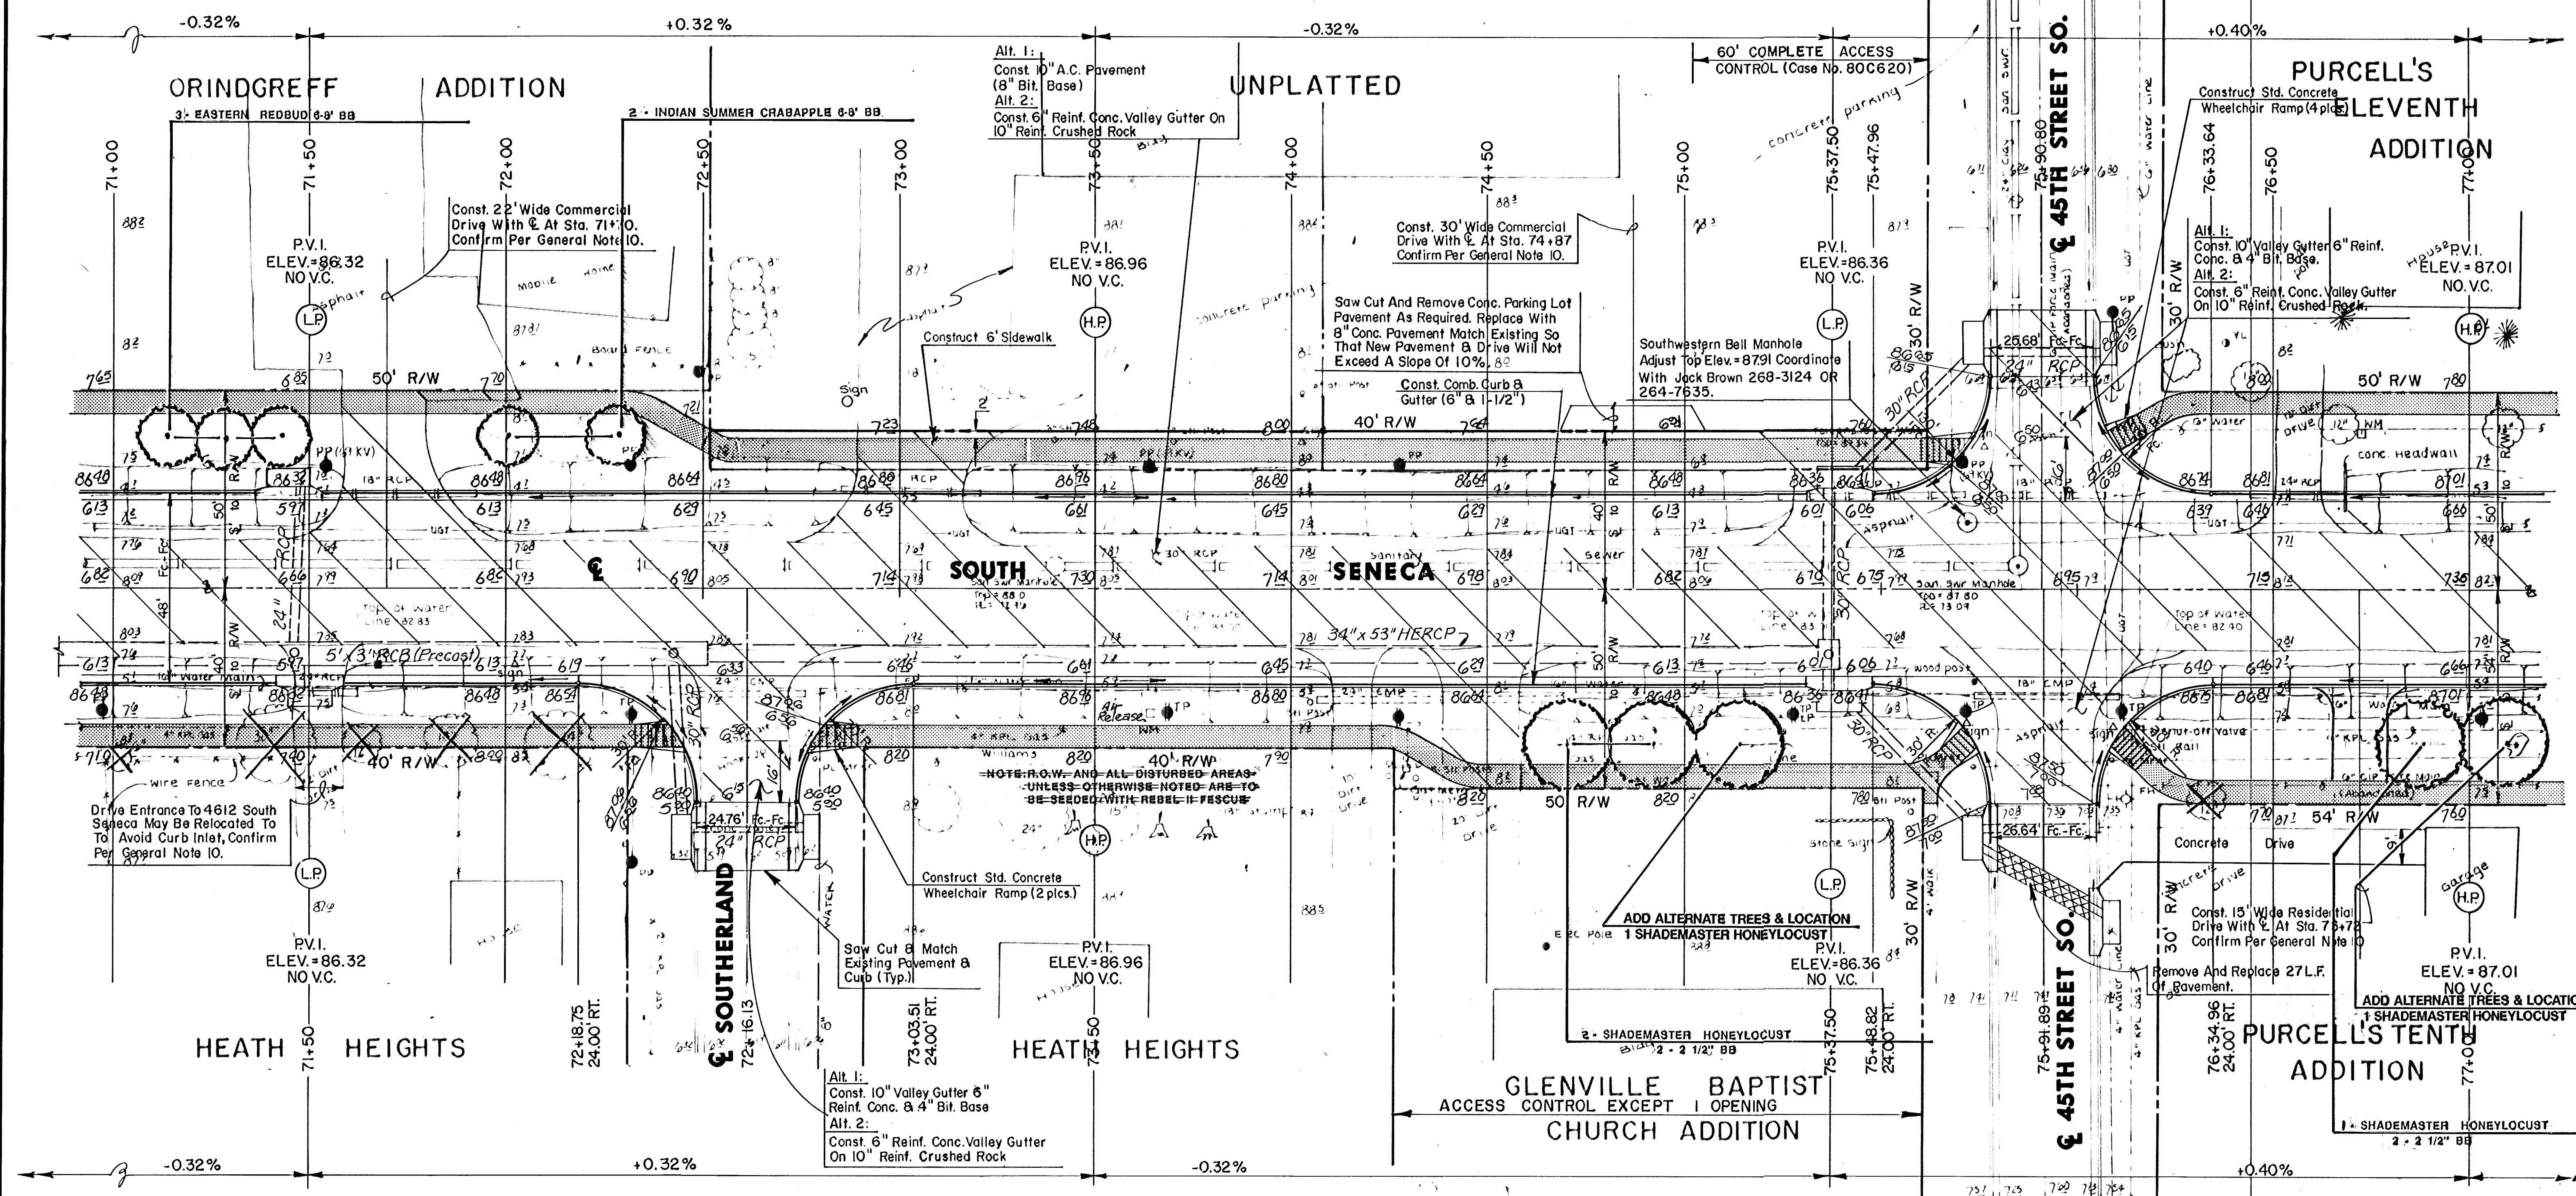

Scale: 1" = 20'



SEWER MANHOLE ADJUSTMENT				WATER VALVE BOX ADJUSTMENT				NOTES
STA.	OFFSET	EXIST. ELEV.	PROP. ELEV.	STA.	OFFSET	EXIST. ELEV.	PROP. ELEV.	
73+40	6' Lt.	88.00	87.06	72+80±	27' Rt.	N.A.		Field Verify
73+85	6' Lt.	87.80	86.88	72+72	40' Rt.	Relocated By Others		FH / WV
				73+84	32' Rt.	87.70		Air Release
				76+08±	25' Rt.			Field Verify
				76+08±	40' Lt.			Field Verify

**SOUTH SENeca
IMPROVEMENTS**

LANDSCAPE PLAN

48TH ST. SO. TO MACARTHUR RD.

Design
Downby
Checked by
Date
DEC., 1992

Sheet
5
of
12

MID-KANSAS ENGINEERING CONSULTANTS PA
3500 NORTH ROCK ROAD
BUILDING #800
WICHITA, KANSAS 67226

636-6666