


STORM WATER SEWER IMPROVEMENTS

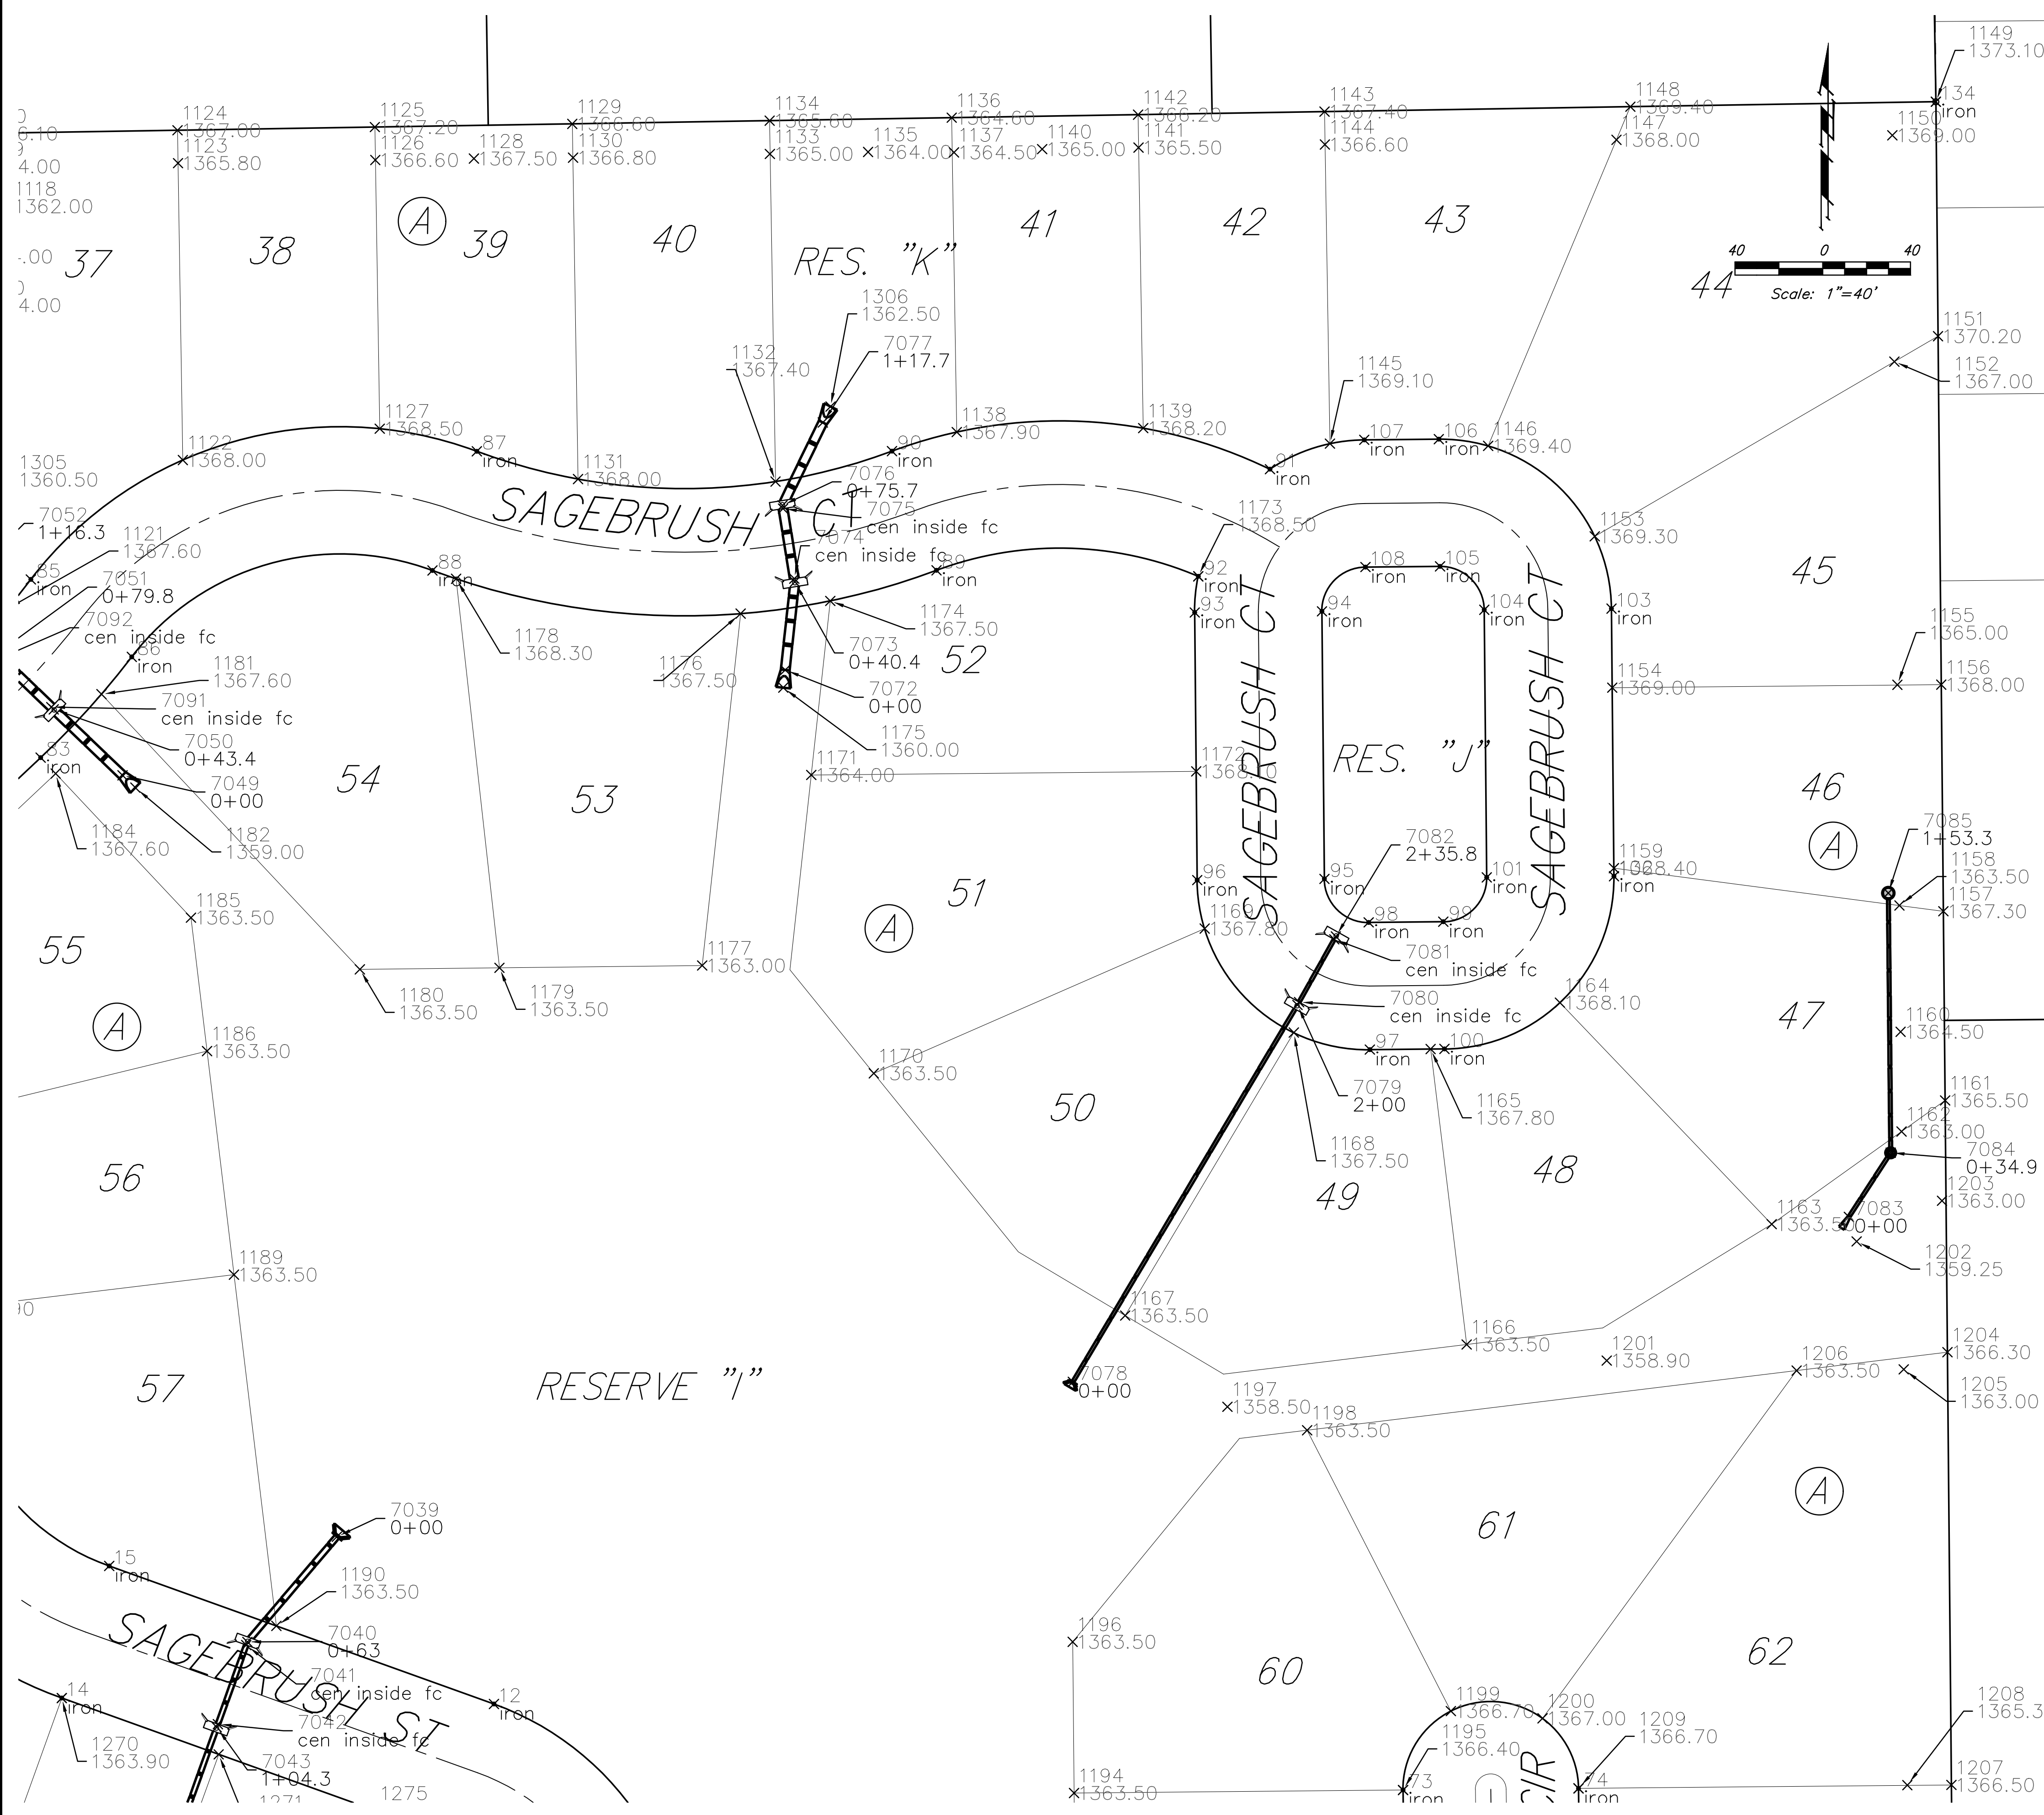

Point Table			
Point #	Northing	Easting	Raw Description
7000	1699926.71	1699067.11	0+00
7001	1699902.12	1699178.28	1+13.9
7002	1699996.40	1699246.48	2+30.2
7003	1700316.75	1699243.52	5+50.6
7004	1700023.89	1698830.09	0+00
7005	1700138.08	1698862.92	1+18.8
7006	1700139.66	1698860.99	cen inside fc
7007	1700160.48	1698835.47	cen inside fc
7008	1700161.43	1698834.30	1+55.8
7009	1700185.72	1698807.73	1+91.8
7010	1700031.36	1698797.13	0+00
7011	1700169.02	1698771.52	1+40
7012	1700029.89	1698786.84	0+00
7013	1700016.38	1698767.29	0+00
7014	1700042.69	1698737.16	0+40
7015	1700033.67	1698630.36	1+47.2
7016	1700076.29	1698626.07	1+90
7017	1700124.93	1698568.73	2+65.2
7018	1700249.94	1698220.49	6+35.2
7019	1699900.24	1698633.41	1+33.5
7020	1699897.79	1698483.43	2+83.5
7021	1699894.33	1698271.46	4+95.5
7022	1700283.58	1697849.44	0+00
7023	1700254.31	1697842.86	0+30
7024	1700100.05	1697844.29	1+84.3
7025	1700098.55	1697844.31	cen inside fc
7026	1700060.34	1697878.74	cen inside fc
7027	1700058.84	1697878.71	2+38
7028	1699890.95	1697880.26	4+05.9
7029	1699888.18	1697710.28	5+75.9
7030	1699885.65	1697555.26	7+30.9
7031	1699927.54	1697714.92	0+39.6
7032	1700355.81	1697797.31	0+00
7033	1700378.12	1697738.39	0+63
7034	1700378.28	1697736.90	cen inside fc
7035	1700382.45	1697698.79	cen inside fc
7036	1700382.62	1697697.30	1+04.3
7037	1700381.26	1697550.67	2+51
7039	1700510.07	1698521.76	0+00
7040	1700462.09	1698480.94	0+63
7041	1700460.67	1698480.43	cen inside fc
7042	1700424.59	1698467.48	cen inside fc
7043	1700423.18	1698466.97	1+04.3
7044	1700294.87	1698420.91	2+40.7
7045	1700411.76	1698095.26	5+86.7
7046	1700437.44	1698023.73	6+62.7
7047	1700551.85	1698070.03	7+86.1
7048	1700585.11	1698081.97	8+21.4
7049	1700857.17	1698424.00	0+00
7050	1700887.24	1698392.65	0+43.4
7051	1700912.39	1698366.42	0+79.8
7052	1700946.67	1698353.73	1+16.3
7053	1700821.24	1698256.54	1+42.8
7054	1700830.04	1698227.24	1+73.4
7055	1700800.38	1698195.65	2+16.7
7056	1700817.51	1698159.47	2+56.7
7057	1700813.83	1697932.49	4+83.7
7058	1700810.37	1697719.41	6+96.8
7059	1700810.36	1697717.91	cen inside fc
7060	1700810.00	1697679.58	cen inside fc
7061	1700809.99	1697678.08	7+38.2
7062	1700807.03	1697549.73	8+66.6
7064	1700960.14	1697930.11	1+46.3
7065	1700961.64	1697930.09	cen inside fc
7066	1700999.97	1697929.47	cen inside fc

Point Table			
Point #	Northing	Easting	Raw Description
7067	1701001.47	1697929.44	1+87.7
7068	1701129.77	1697926.06	3+16
7069	1701131.23	1698016.05	4+06
7070	1701132.43	1698090.04	4+80
7072	1700905.21	1698726.11	0+00
7073	1700945.35	1698730.50	0+40.4
7074	1700946.83	1698730.26	cen inside fc
7075	1700978.77	1698725.13	cen inside fc
7076	1700980.25	1698724.89	0+75.7
7077	1701018.02	1698743.27	1+17.7
7078	1700580.67	1698857.26	0+00
7079	1700752.47	1698959.65	2+00
7080	1700753.78	1698960.38	cen inside fc
7081	1700782.40	1698976.41	cen inside fc
7082	1700783.71	1698977.15	2+35.8
7083	1700655.84	1699211.05	0+00
7084	1700685.12	1699230.11	0+34.9
7085	1700803.53	1699229.02	1+53.3
7086	1699929.04	1697714.90	cen inside fc
7087	1700036.16	1698630.11	cen inside fc
7088	1700074.80	1698626.22	cen inside fc
7089	1700553.27	1698070.54	cen inside fc
7090	1700583.70	1698081.46	cen inside fc
7091	1700888.27	1698391.57	cen inside fc
7092	1700910.66	1698368.23	cen inside fc
7093	1700828.33	1698225.42	cen inside fc
7094	1700802.09	1698197.47	cen inside fc



BAUGHMAN COMPANY

315 Ellis St.
Wichita, KS 67211
316-262-7271
BaughmanCo.com

NRD ADDITION

MASS GRADING PLAN

STORM WATER DRAIN IMPROVEMENTS

PROJECT NUMBER:
21-03-E867

DESIGN: NBW DRAWN: TMS

DATE: August 5, 2021

SHEET **43** OF **46**

File: E:\Projects\NRD Addition_19-04-P448\Engineering\Phase 1\SWD 21-03-E867\SWD.dwg