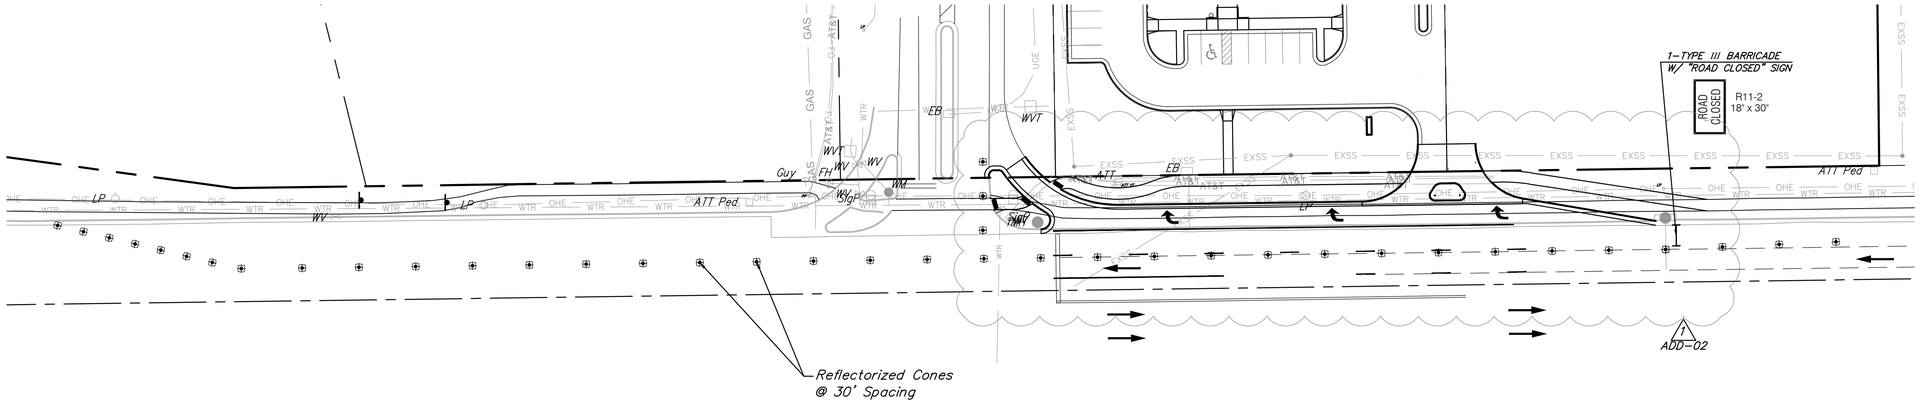

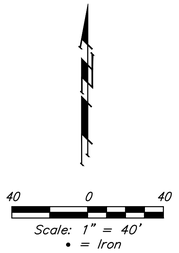

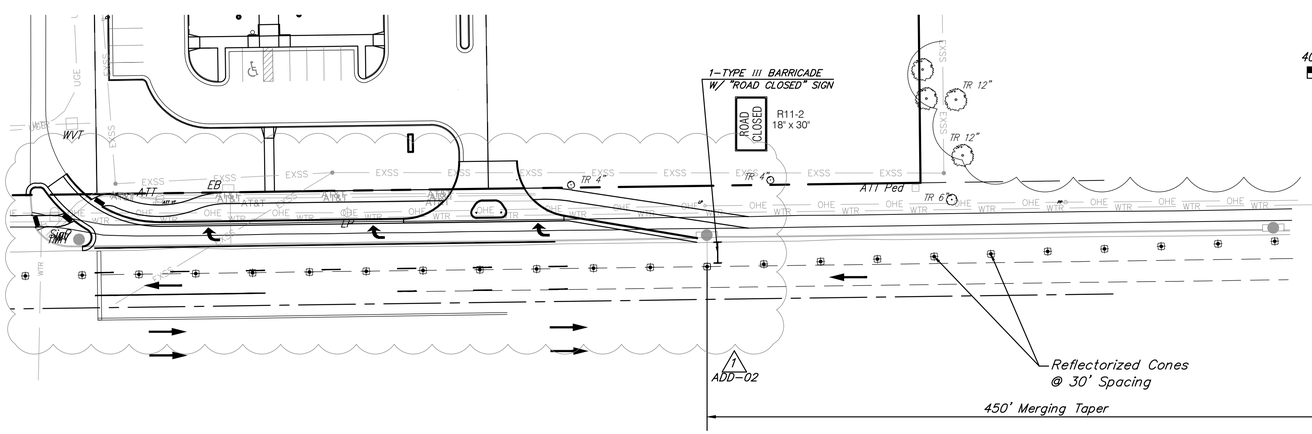

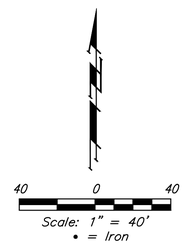

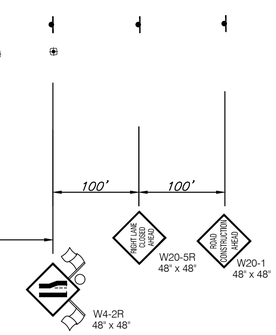

Phase 1

Construct the Street Improvements on the North Side of 21st St N.

Maintain Two-Way Traffic in at least One Lane Each Way on 21st St N.

- DENOTES WORK ZONE
- DENOTES TRAFFIC FLOW
- DENOTES REFLECTORIZED CONES
- DENOTES TUBULAR MARKERS
- DENOTES TYPE III BARRACADE
- DENOTES TRAFFIC SIGN

NO SCALE

SCOTT R. SCHEER
17874
8/20/21
KANSAS
PROFESSIONAL ENGINEER

BAUGHMAN COMPANY
315 Ellis St.
Wichita, KS 67211
316-262-7271
BaughmanCo.com

NEWSPRING COMMERCIAL ADDITION

MARKING & SIGNING PLAN

SIDEWALK & TURN LANE IMPROVEMENTS

PROJECT NUMBER: 20-10-E760

DESIGN: SRS DRAWN: SRS

DATE: August 20, 2021

SHEET 8 OF 21

File: E:\Projects\NewSpring Commercial Addition\Engineering\Phase 1\Str\NSA STR Rev1.dwg