

RECEIVED FOR INFORMATION ONLY


This document has not been reviewed for content or compliance with the Contract Documents. Contractor at all times remains solely responsible for compliance with the Contract Documents, including dimensions and safety analyses. Deviations are not approved unless Contractor has in writing called Engineer's attention to such deviation at the time of submission and Engineer has in writing approved the specific deviation. No review by Engineer relieves Contractor from responsibility for errors or omissions in Compliance Submittals.
510




Linder & Associates - Contractor
G. Baalman - City of Wichita, Field Project Engineer
R. Skilling - City of Wichita, Inspector
Final Acceptance Date: 7/16/2021
Completion Date: 9/15/2021



PLANT TWO - UV LIGHTNING PROTECTION
CITY OF WICHITA, KANSAS

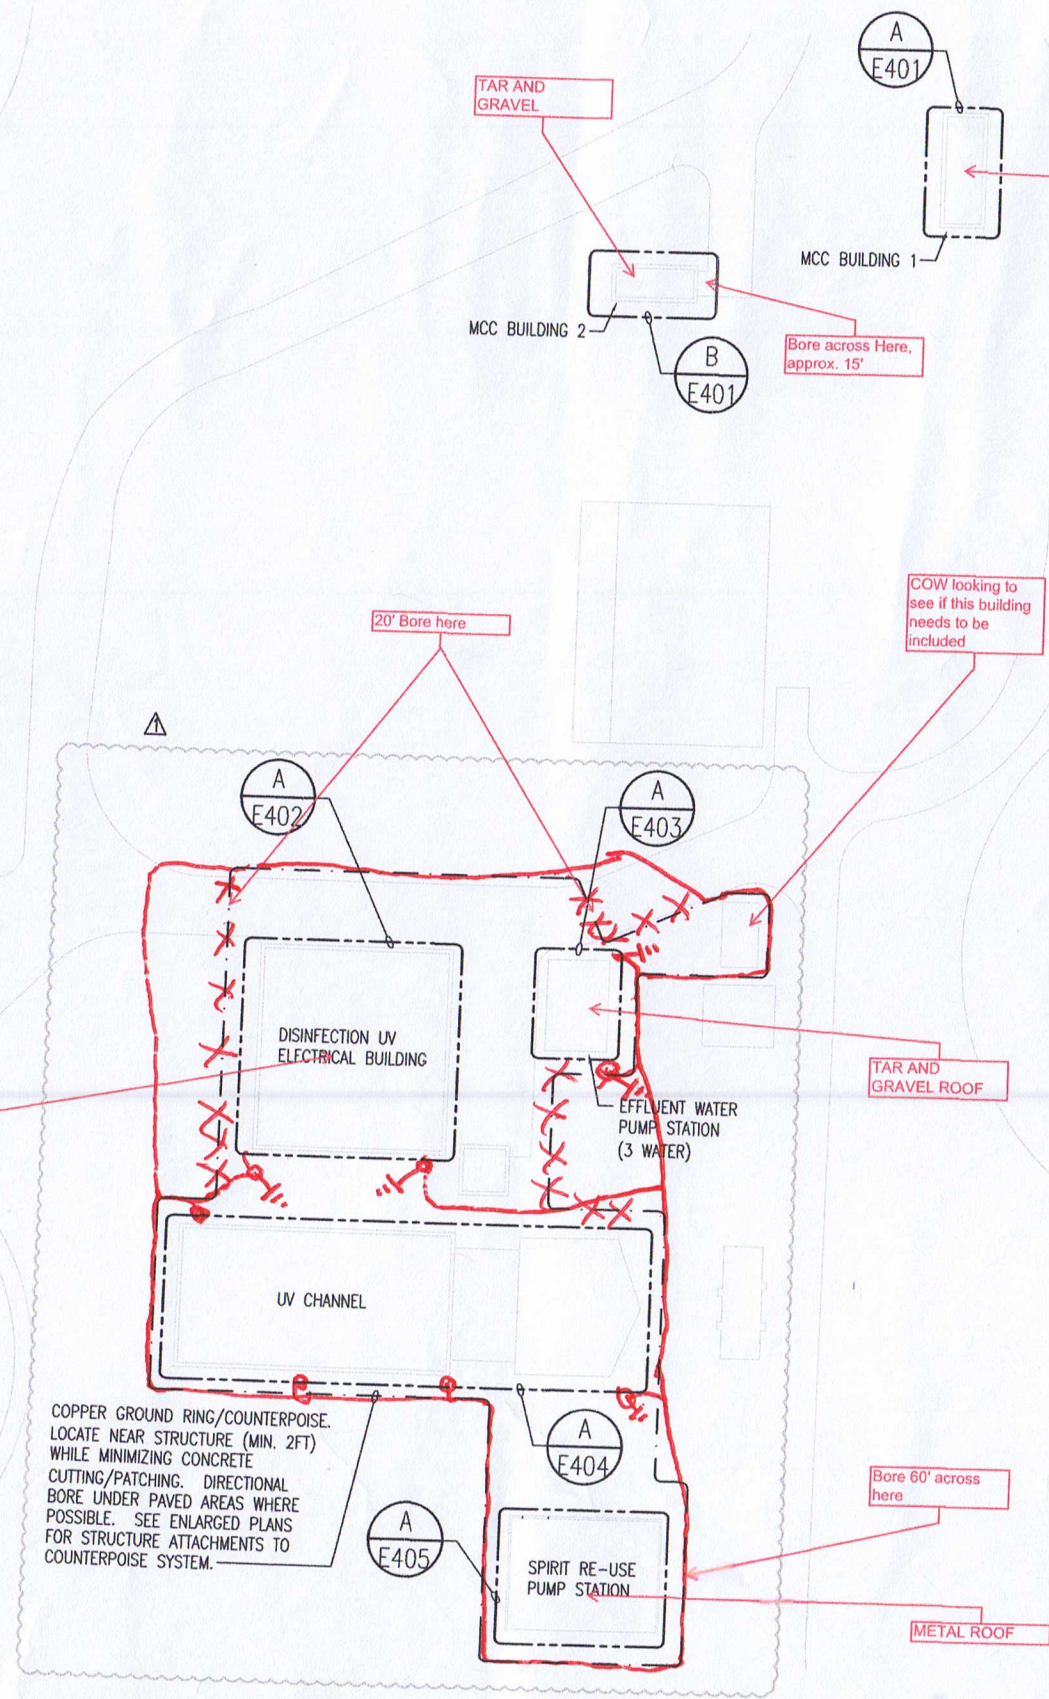

A SITE PLAN

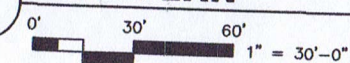

ELECTRICAL SITE PLAN NOTES:

- CONTRACTOR SHALL REFERENCE ALL RELATED CONTRACT DOCUMENTS, SITE SURVEY, AND OTHER RESOURCES FOR POSSIBLE CONFLICTS WITH OTHER UNDERGROUND UTILITIES. AT UTILITY CROSSINGS, CONTRACTOR SHALL VERIFY UTILITY DEPTHS AND COORDINATE GROUND CONDUCTOR ROUTING AS NECESSARY. AREAS CONGESTED WITH UTILITIES MAY REQUIRE HAND DIGGING OR HYDRO-EXCAVATION AT THE COST OF THE CONTRACTOR.
- CONTRACTOR SHALL VERIFY AND COORDINATE EXISTING CONDITIONS OF PROJECT SITE PRIOR TO BID.
- COPPER GROUND RING TO BE BURIED MINIMUM 24" BELOW GRADE.
- CONTRACTOR SHALL BE RESPONSIBLE FOR CUTTING AND PATCHING CONCRETE/ASPHALT AS REQUIRED FOR A COMPLETE INSTALLATION.

Issue:	REVISION #1	11/3/20
JOB NO.	197043-009	
DATE	JANUARY 2021	
PM	RWW	
DESIGNED BY	CJV	
DRAWN BY	ABP	
CHECKED BY	SMS	

SITE PLAN

E301

Sheet 11-02-2020, 10:21:51 AM by CHRIS.VAIL
 Rick Whitehill - Civil
 U:\Wichita - Civil\2019\197043-009\Elec\Drawings\197043-009 - E301 SITE PLAN

