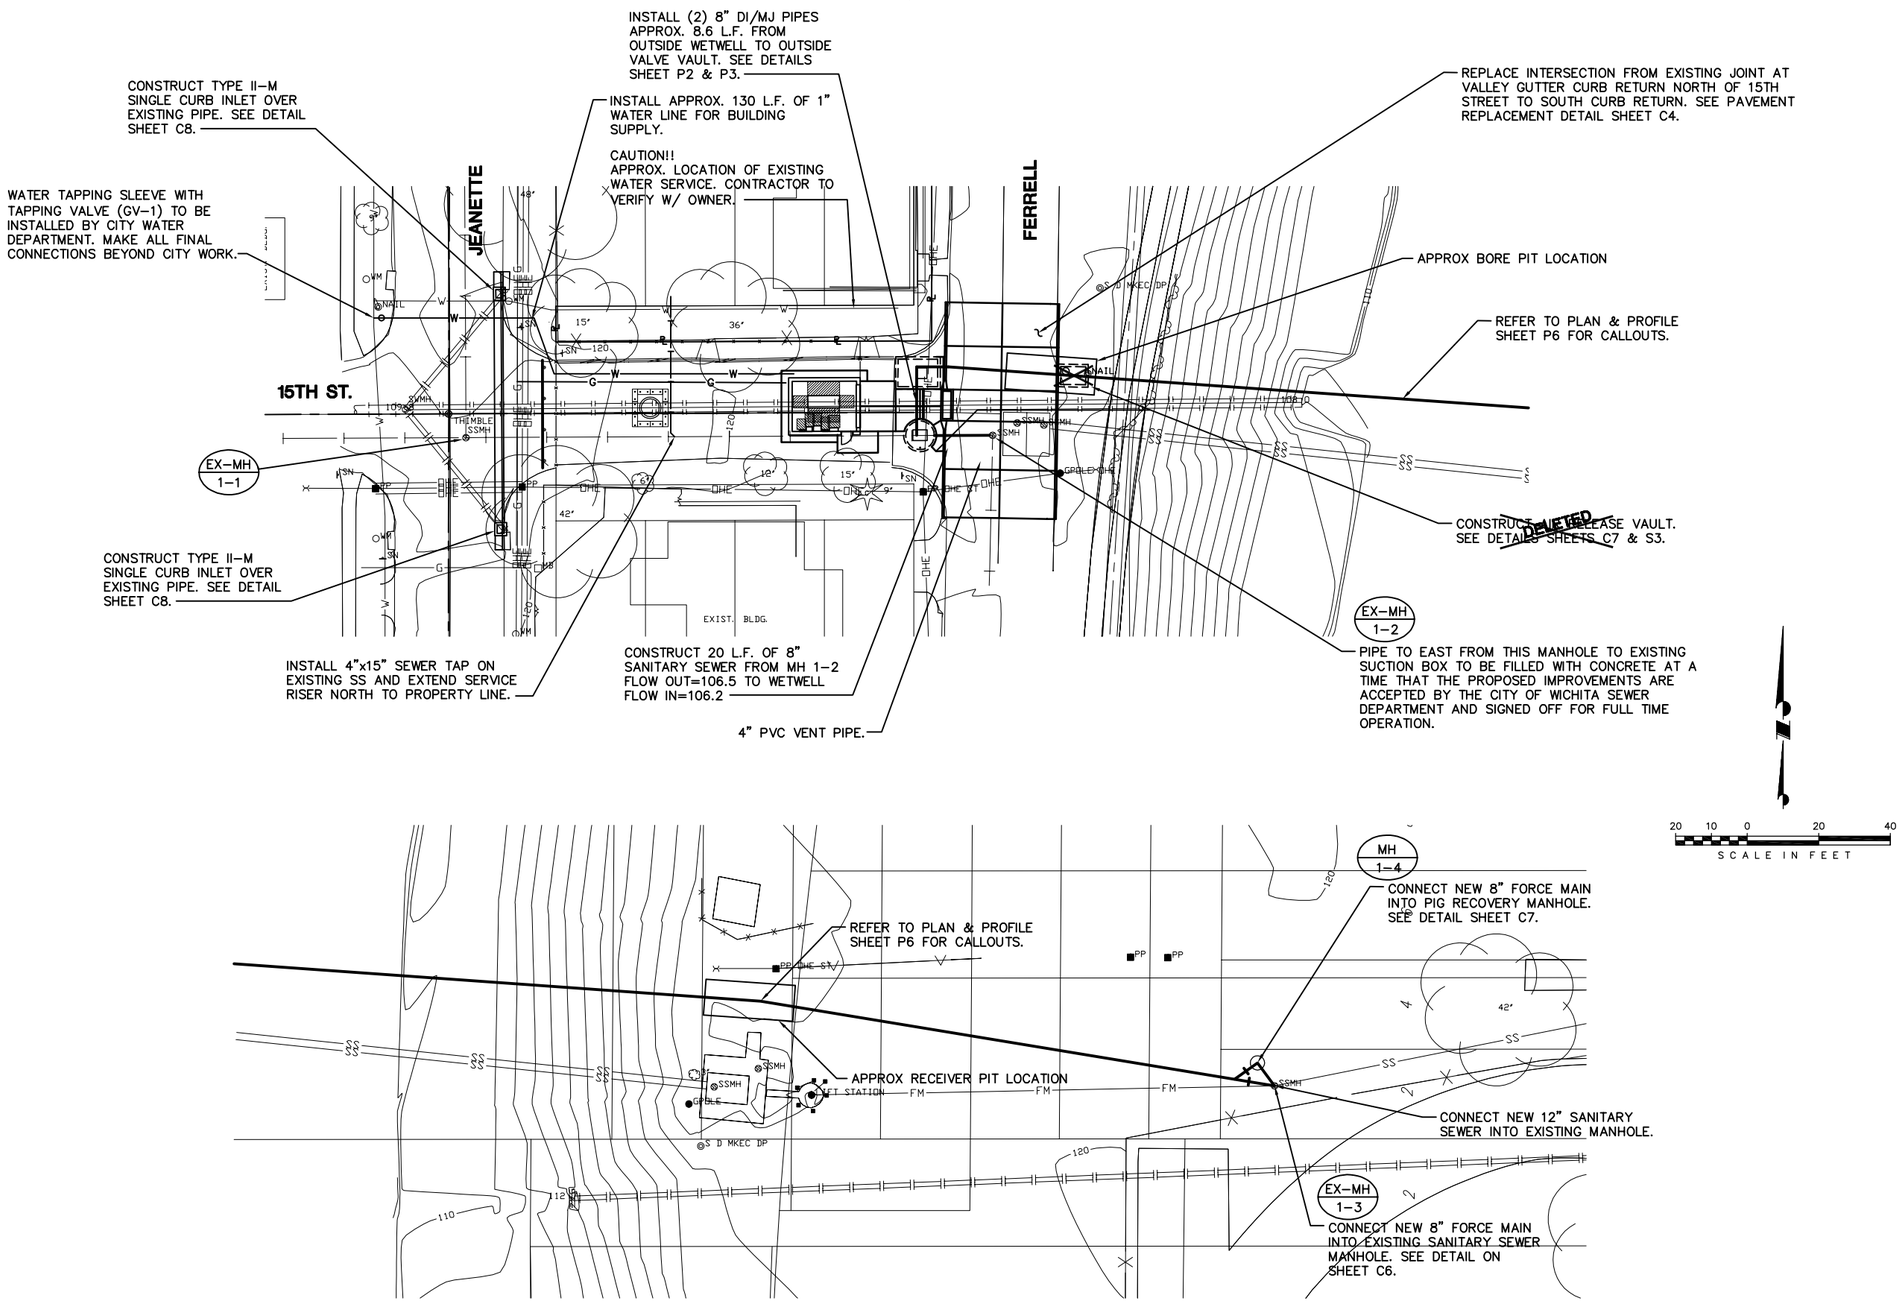

CONFORMING TO CONSTRUCTION RECORDS 4/20/07

THE CITY OF WICHITA
CITY ENGINEER'S OFFICE
CITY HALL - SEVENTH FLOOR
455 NORTH MAIN STREET
WICHITA, KANSAS 67202
(316) 268-4351
(316) 268-4174 FAX

NO.	BY	DATE	DESCRIPTION
0	DLM	10/17/05	ISSUE FOR CONSTRUCTION
	MJV	4/26/07	CONFORMING TO CONSTRUCTION RECORDS DELETED AIR RELEASE VAULT, CHANGED ROUTING OF WET WELL VENT.

MKEC ENGINEERING CONSULTANTS

CITY OF WICHITA

CITY OF WICHITA, KANSAS
15th STREET PUMP STATION AND FORCE MAIN

SITE PIPING PLAN

DESIGNED BY	DLM	CHECKED BY	DLM
DRAWN BY	BDM	DATE	JUNE, 2005
PROJECT	0301030310	CONTRACT	–
DRAWING	P1	REVISION	- 0

FILE I:\ENVR\03310\DWG\Piping\03310_P1_SITE_PIPE-1.dwg 10/31/2005 01:57:17 PM CST