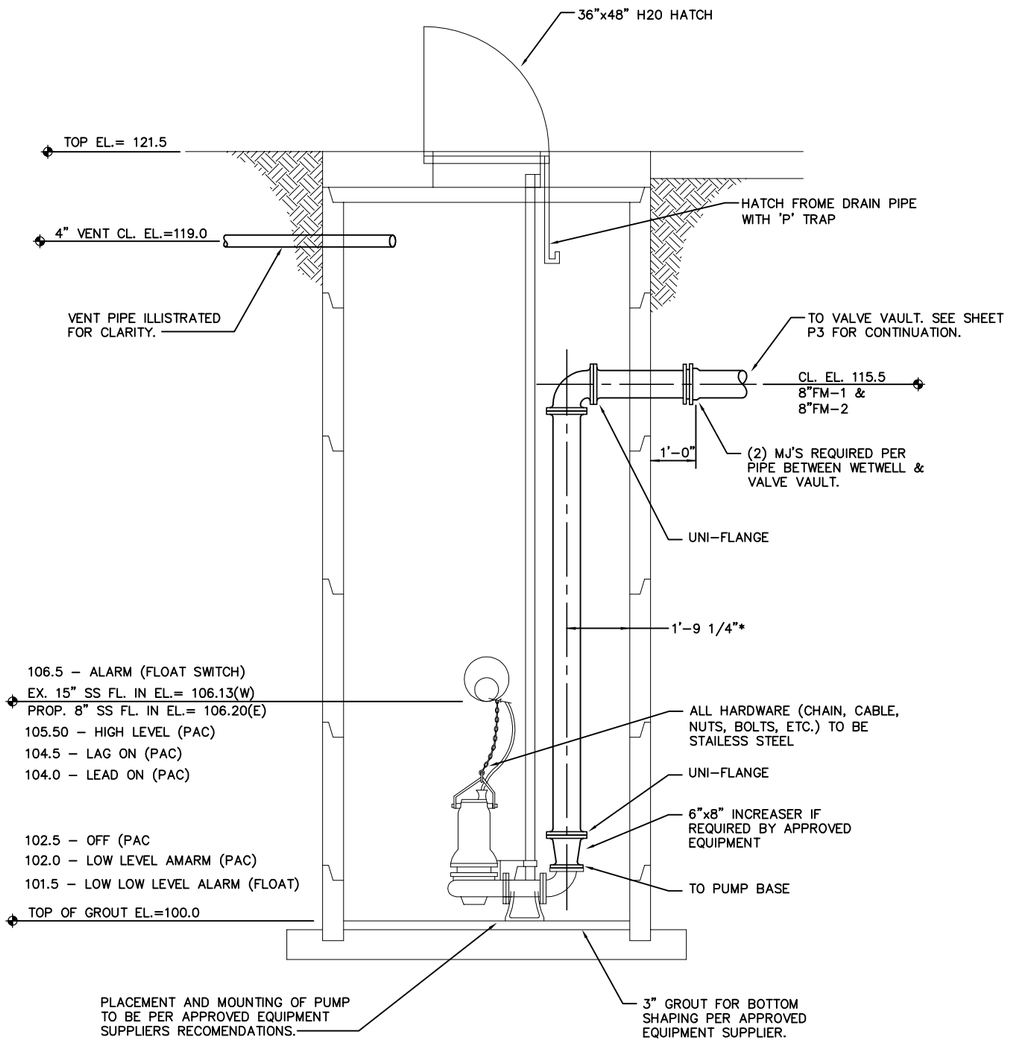

A **SECTION**

2 0 2 4 6
SCALE IN FEET

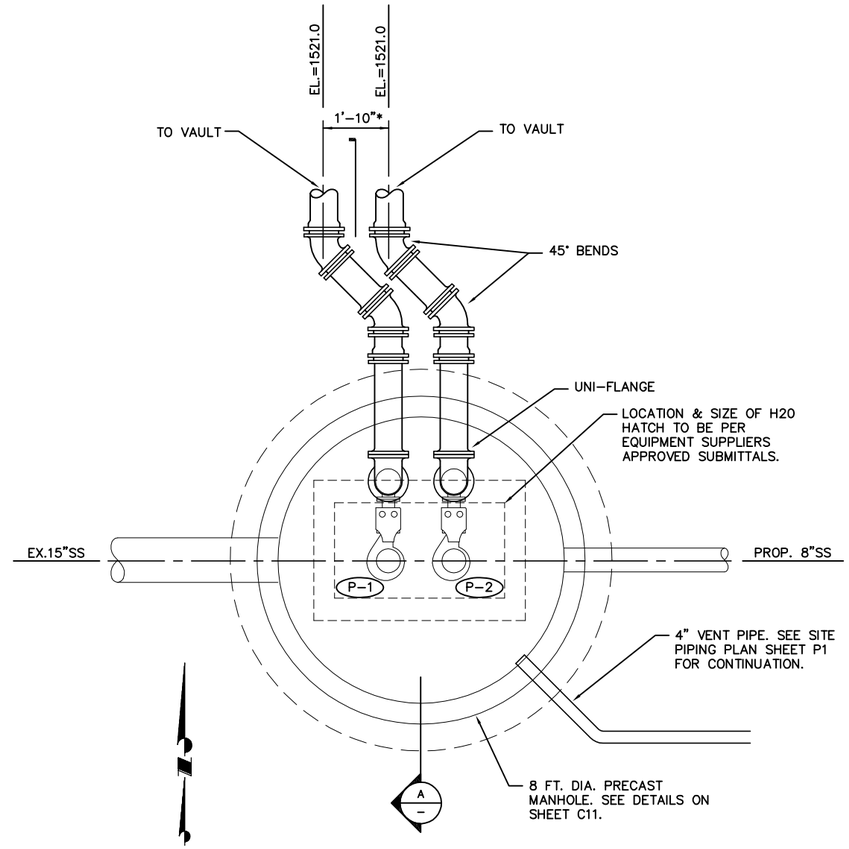

B **PLAN VIEW**

2 0 2 4 6
SCALE IN FEET

NOTES:

* VARIES PER EQUIPMENT MANUFACTURER.

CONFORMING TO CONSTRUCTION RECORDS 4/20/07

THE CITY OF WICHITA
CITY ENGINEER'S OFFICE
CITY HALL, SEVENTH FLOOR
455 NORTH MAIN STREET
WICHITA, KANSAS 67202
(316) 268-4422
(316) 268-4414 FAX

NO.	BY	DATE	DESCRIPTION
0	DLM	10/17/05	ISSUE FOR CONSTRUCTION
	MJV	4/26/07	CONFORMING TO CONSTRUCTION RECORDS CHANGED PIPING, & ADDED ACCESS HATCH DRAIN & TRAP.

MKEC ENGINEERING CONSULTANTS

CITY OF WICHITA

CITY OF WICHITA, KANSAS
15th STREET PUMP STATION AND FORCE MAIN

WETWELL PIPING PLAN & SECTION

DESIGNED BY	DLM	CHECKED BY	DLM
DRAWN BY	BDM	DATE	JUNE, 2005
PROJECT	0301030310	CONTRACT	-
DRAWING	P2	REVISION	- 0

FILE I:\ENVR\03310\DWG\Piping\03310_P2_WW_PIPING.dwg 10/31/2005 02:19:32 PM CST