
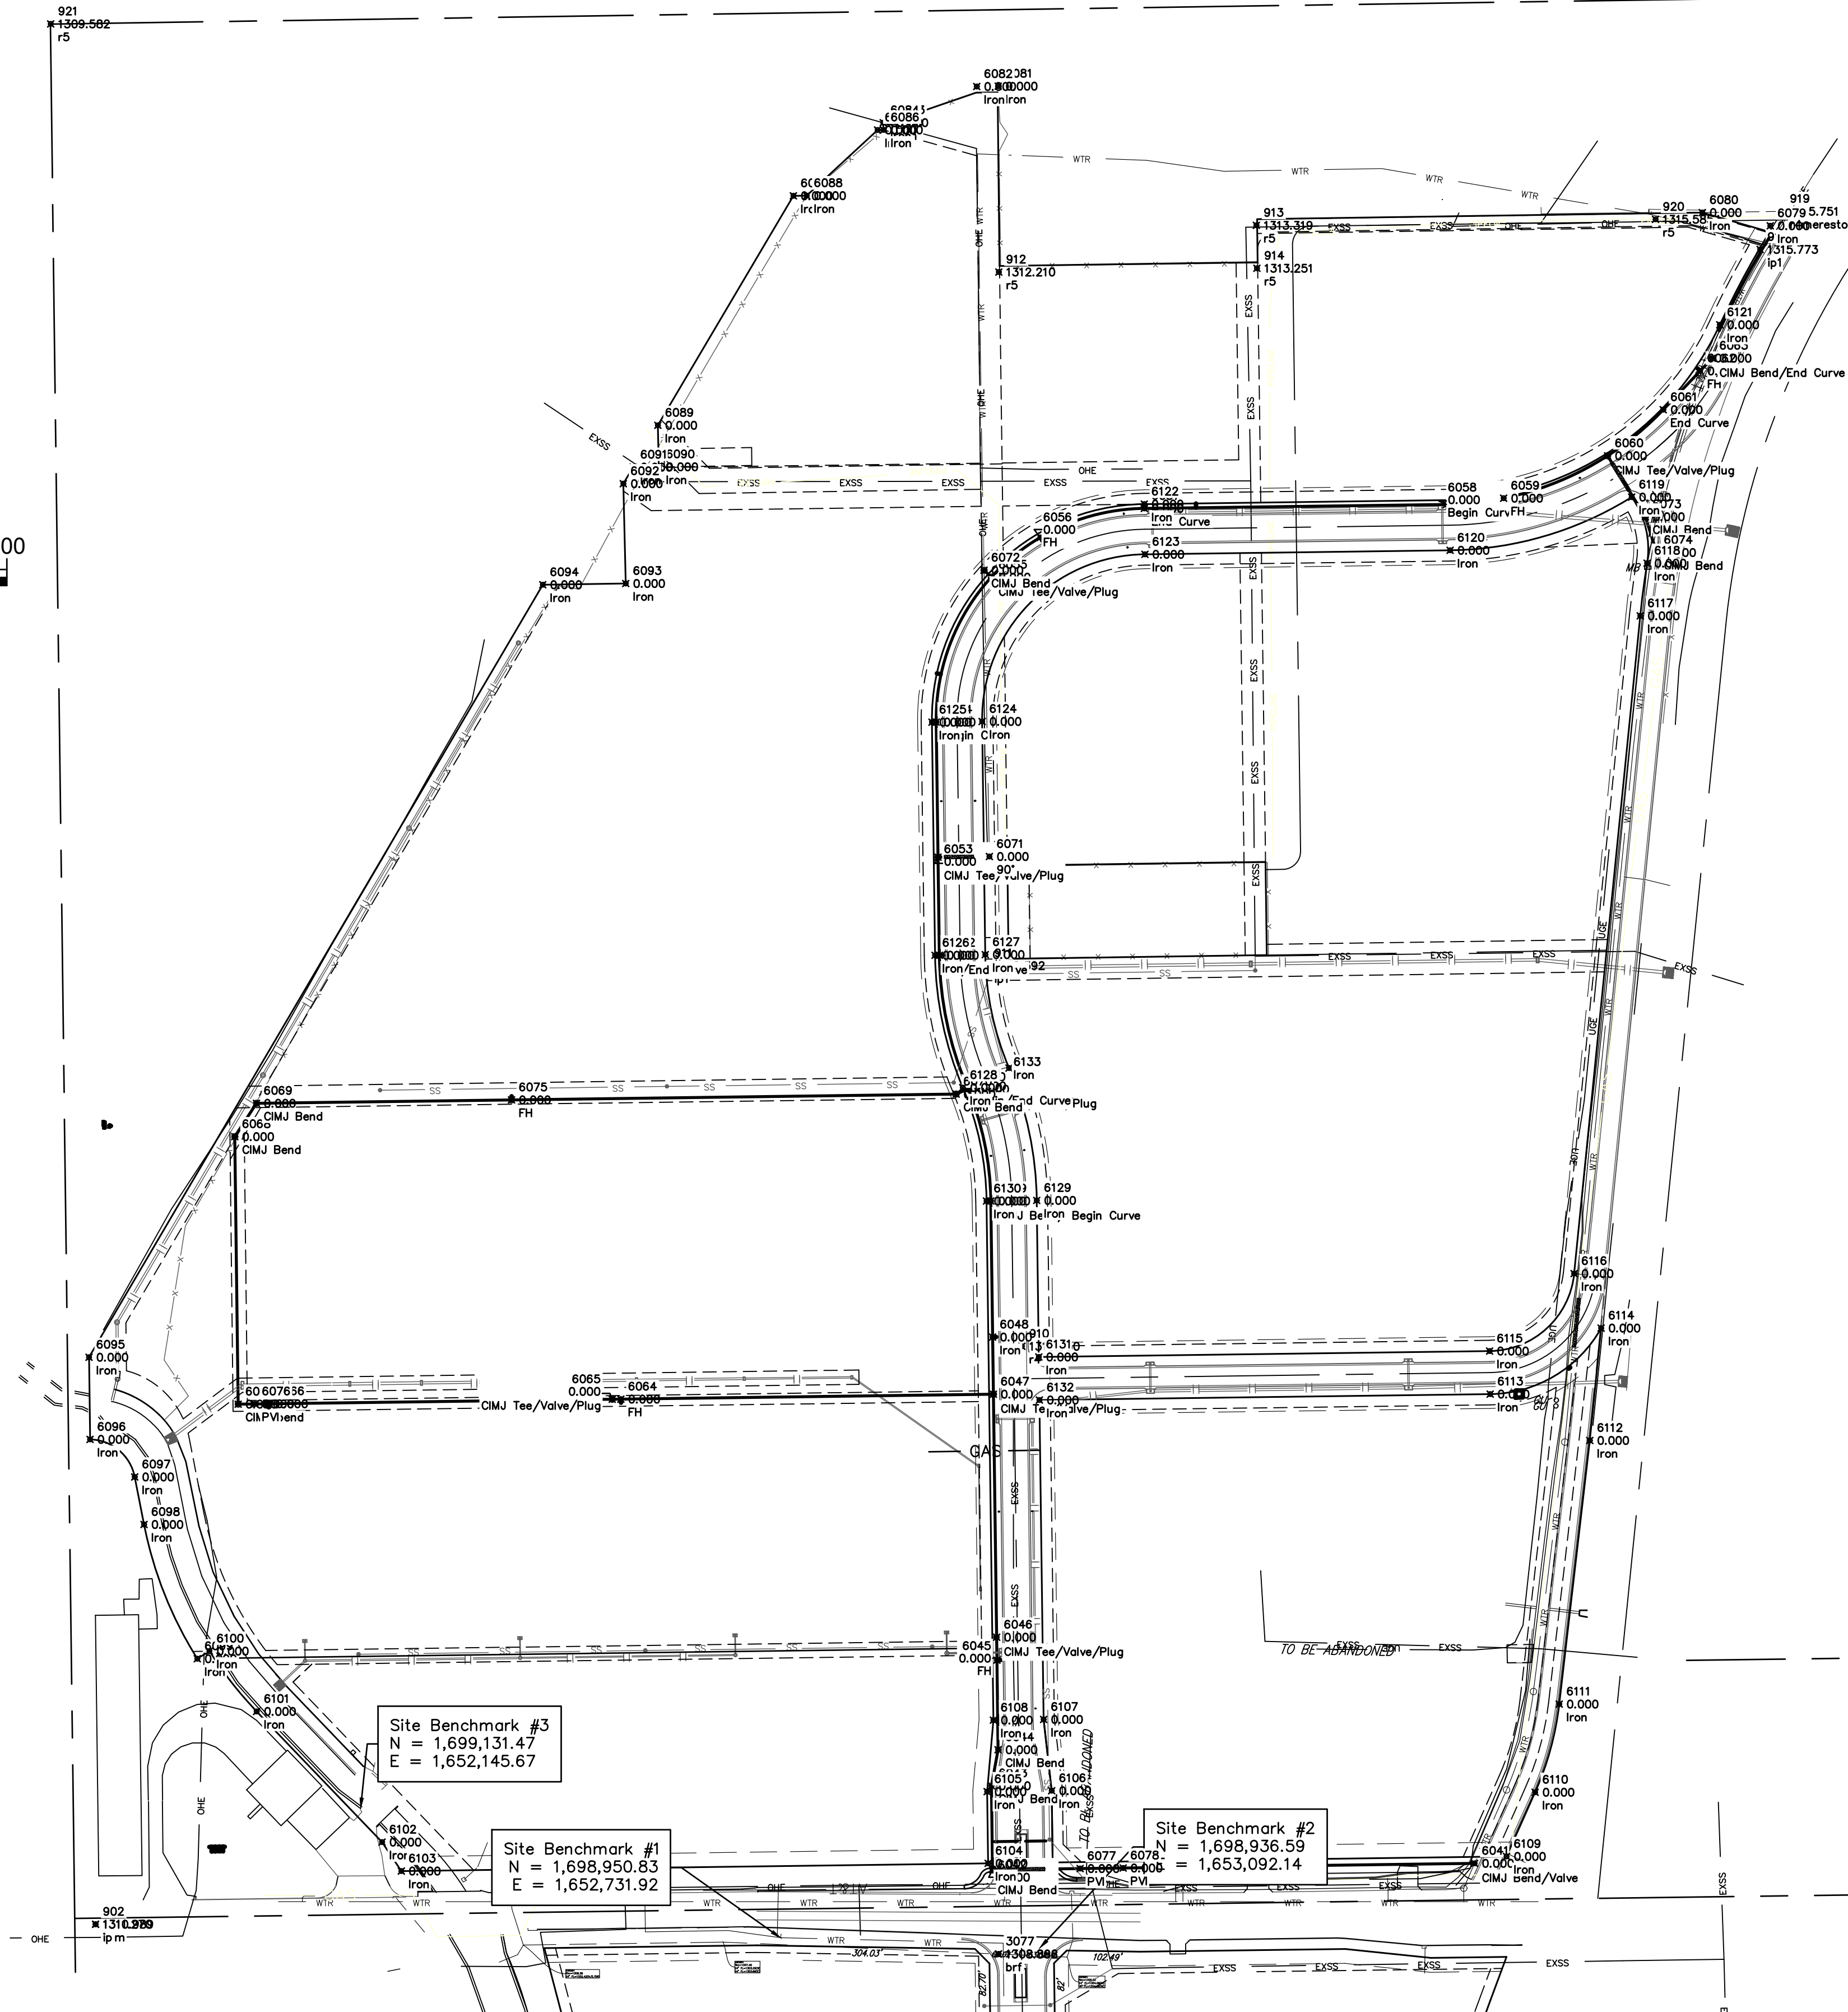


# BENCHMARKS

BM- #1:  
Square cut on top of South curb of 21st St. N.  
334± West and 32± South of the intersection of  
21st St. N. and Cleveland Ave.  
Elev. = 1307.56(NAVD88)


BM- #2:  
Square cut on top of South concrete pad of  
monitoring well 26± East and 51± South of the  
intersection of 21st St. N. and Cleveland Ave.  
Elev. = 1308.70(NAVD88)

BM- #3:  
C.O.W BM Disc on top of South concrete wall  
918± West and 147± North of the intersection  
of 21st St. N. and Cleveland Ave.  
Elev. = 1312.58(NAVD88)

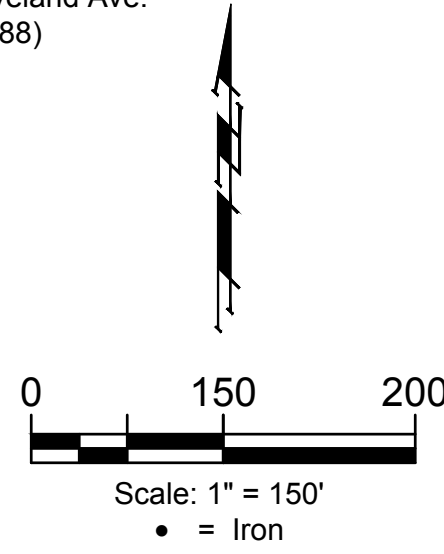

Point #	Northing	Eastng	Description
2	1698970.22	1651776.17	thm
902	1698970.19	1651776.17	ip
903	1699013.22	1654386.29	r4
910	1699775.87	1653067.66	r4
911	1700306.49	1653018.94	ip1
912	1701273.35	1653035.54	r5
913	1701338.53	1653394.63	r5
914	1701278.56	1653395.38	r5
915	1701304.83	1654096.98	ip1
917	1701619.67	1654278.24	r5
918	1701575.32	1654272.52	r5
919	1701357.93	1654128.25	r4merestone
920	1701346.81	1653951.07	r5
921	1701619.20	1651713.57	r5
6041	1699055.14	1653698.81	CIMJ Bend/Valve
6042	1699046.25	1653026.71	CIMJ Bend
6043	1699163.20	1653025.19	CIMJ Bend
6044	1699213.52	1653034.51	CIMJ Bend
6045	1699338.36	1653032.86	FH
6046	1699370.36	1653032.44	CIMJ Tee/Valve/Plug
6047	1699709.11	1653027.96	CIMJ Tee/Valve/Plug
6048	1699788.78	1653026.90	Iron
6049	1699784.45	1653024.40	CIMJ Bend/ Begin Curve
6050	1700134.60	1652992.53	CIMJ Tee/Valve/Plug
6051	1700138.81	1652990.78	Begin/End Curve
6052	1700320.93	1652952.59	FH/End Curve
6053	1700457.70	1652950.78	CIMJ Tee/Valve/Plug
6054	1700645.98	1652948.29	Begin Curve
6055	1700847.99	1653025.05	CIMJ Tee/Valve/Plug
6056	1700903.36	1653093.35	FH
6057	1700943.84	1653238.37	End Curve
6058	1700849.40	1653659.49	Begin Curve
6059	1700958.06	1653739.39	FH
6060	1701017.17	1653884.21	CIMJ Tee/Valve/Plug
6061	1701081.46	1653961.88	End Curve
6062	1701135.48	1654013.27	FH
6063	1701153.24	1654030.17	CIMJ Bend/End Curve
6064	1699702.24	1652908.53	FH
6065	1699702.08	1652496.53	CIMJ Tee/Valve/Plug
6066	1699695.75	1652017.52	FH
6067	1699695.18	1651975.02	CIMJ bend
6068	1700068.08	1651970.27	CIMJ Bend
6069	1700114.61	1652000.53	CIMJ Bend
6070	1700127.51	1652976.03	CIMJ Bend
6071	1700458.64	1653022.38	90°
6072	1700857.76	1653014.89	CIMJ Bend
6073	1700932.20	1653936.94	CIMJ Bend
6074	1700882.37	1653952.72	CIMJ Bend
6075	1700119.32	1652356.12	FH
6076	1699695.49	1651998.05	PVI

Point #	Northing	Eastng	Description
6077	1699047.87	1653148.86	PVI
6078	1699048.66	1653208.86	PVI
6079	1701337.89	1654111.12	Iron
6080	1701356.28	1654016.30	Iron
6081	1701532.43	1653034.73	Iron
6082	1701531.98	1653004.73	Iron
6083	1701481.62	1652882.33	Iron
6084	1701481.50	1652874.33	Iron
6085	1701471.38	1652866.46	Iron
6086	1701471.44	1652874.69	Iron
6087	1701379.59	1652748.12	Iron
6088	1701379.87	1652767.61	Iron
6089	1701059.68	1652560.06	Iron
6090	1701001.89	1652561.45	Iron
6091	1701001.35	1652525.59	Iron
6092	1700978.38	1652512.01	Iron
6093	1700839.18	1652515.37	Iron
6094	1700837.44	1652399.67	Iron
6095	1699760.66	1651767.05	Iron
6096	1699646.10	1651768.52	Iron
6097	1699593.73	1651830.72	Iron
6098	1699527.48	1651843.68	Iron
6099	1699340.32	1651917.98	Iron
6100	1699350.99	1651943.90	Iron
6101	1699266.65	1652000.73	Iron
6102	1699084.71	1652175.65	Iron
6103	1699044.35	1652202.43	Iron
6104	1699055.17	1653020.60	Iron
6105	1699155.16	1653019.28	Iron
6106	1699156.35	1653109.27	Iron
6107	1699295.71	1653097.96	Iron
6108	1699254.78	1653027.96	Iron
6109	1699064.73	1653743.39	Iron
6110	1699154.26	1653783.24	Iron
6111	1699277.08	1653816.86	Iron
6112	1699644.66	1653859.53	Iron
6113	1699708.30	1653720.59	Iron
6114	1699801.21	1653875.19	Iron
6115	1699769.29	1653719.80	Iron
6116	1699877.27	1653837.61	Iron
6117	1700794.16	1653929.81	Iron
6118	1700867.47	1653939.34	Iron
6119	1700959.57	1653917.83	Iron
6120	1700885.47	1653664.69	Iron
6121	1701199.81	1654040.77	Iron
6122	1700949.83	1653238.29	Iron
6123	1700879.84	1653239.22	Iron
6124	1700646.82	1653012.28	Iron
6125	1700645.89	1652942.29	Iron
6126	1700320.92	1652946.58	Iron

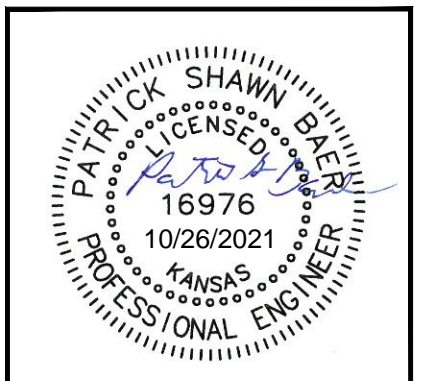

**BAUGHMAN COMPANY**  
315 Ellis St.  
Wichita, KS 67211  
316-262-7271  
BaughmanCo.com

Cornejo Industrial District

**Coordinate**

Water Line Improvements  
PROJECT NUMBER:  
448-2021-017262  
DESIGN: PSB DRAWN: JA  
DATE: Oct. 26, 2021  
SHEET OF  
**24 26**