


Signed

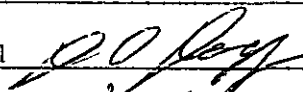

Contractor

RPI

Date

4/26/05

Project

Westlakes Parkway & CTS

Project Number

472-84025

SWS Line # 3 bet 10400 and 11489⁴ lowered
to allow San Sewer Hook-ups (Change Order.)

RECEIVED

SEP 16 2005

CITY - ENGINEERING