


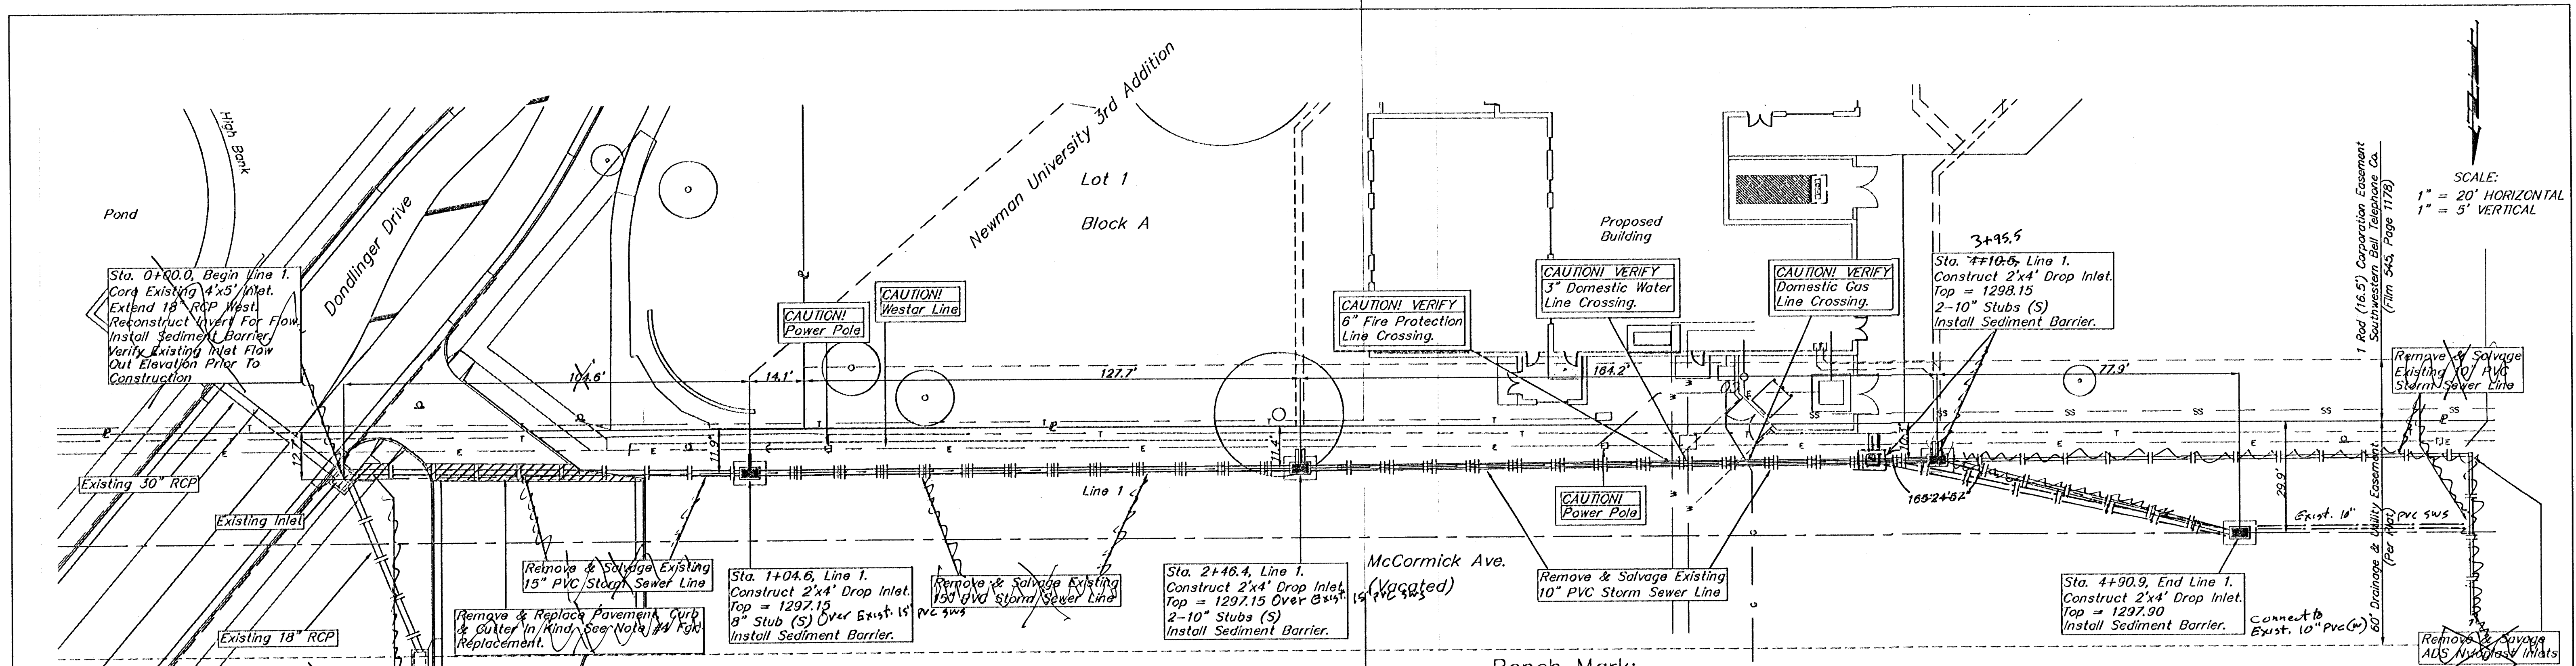


SCALE:
1" = 20' HORIZONTAL
1" = 5' VERTICAL

Bench Mark:
Sheridan and McCormick
City of Wichita Bench Mark, Southeast corner of intersection.
24.00 Ft. East of center line
48.30 Ft. South of center line
Elevation = 1299.76 (MSL)

Contractor To Use Extreme Caution When Excavating Near Utility Lines. Contractor To Hand Dig To Expose All Utility Lines Prior To Construction. Verify Depth To Determine Conflict If Any.

Contractor Shall Follow All Applicable Best Management Practices (BMP) For Erosion Control.

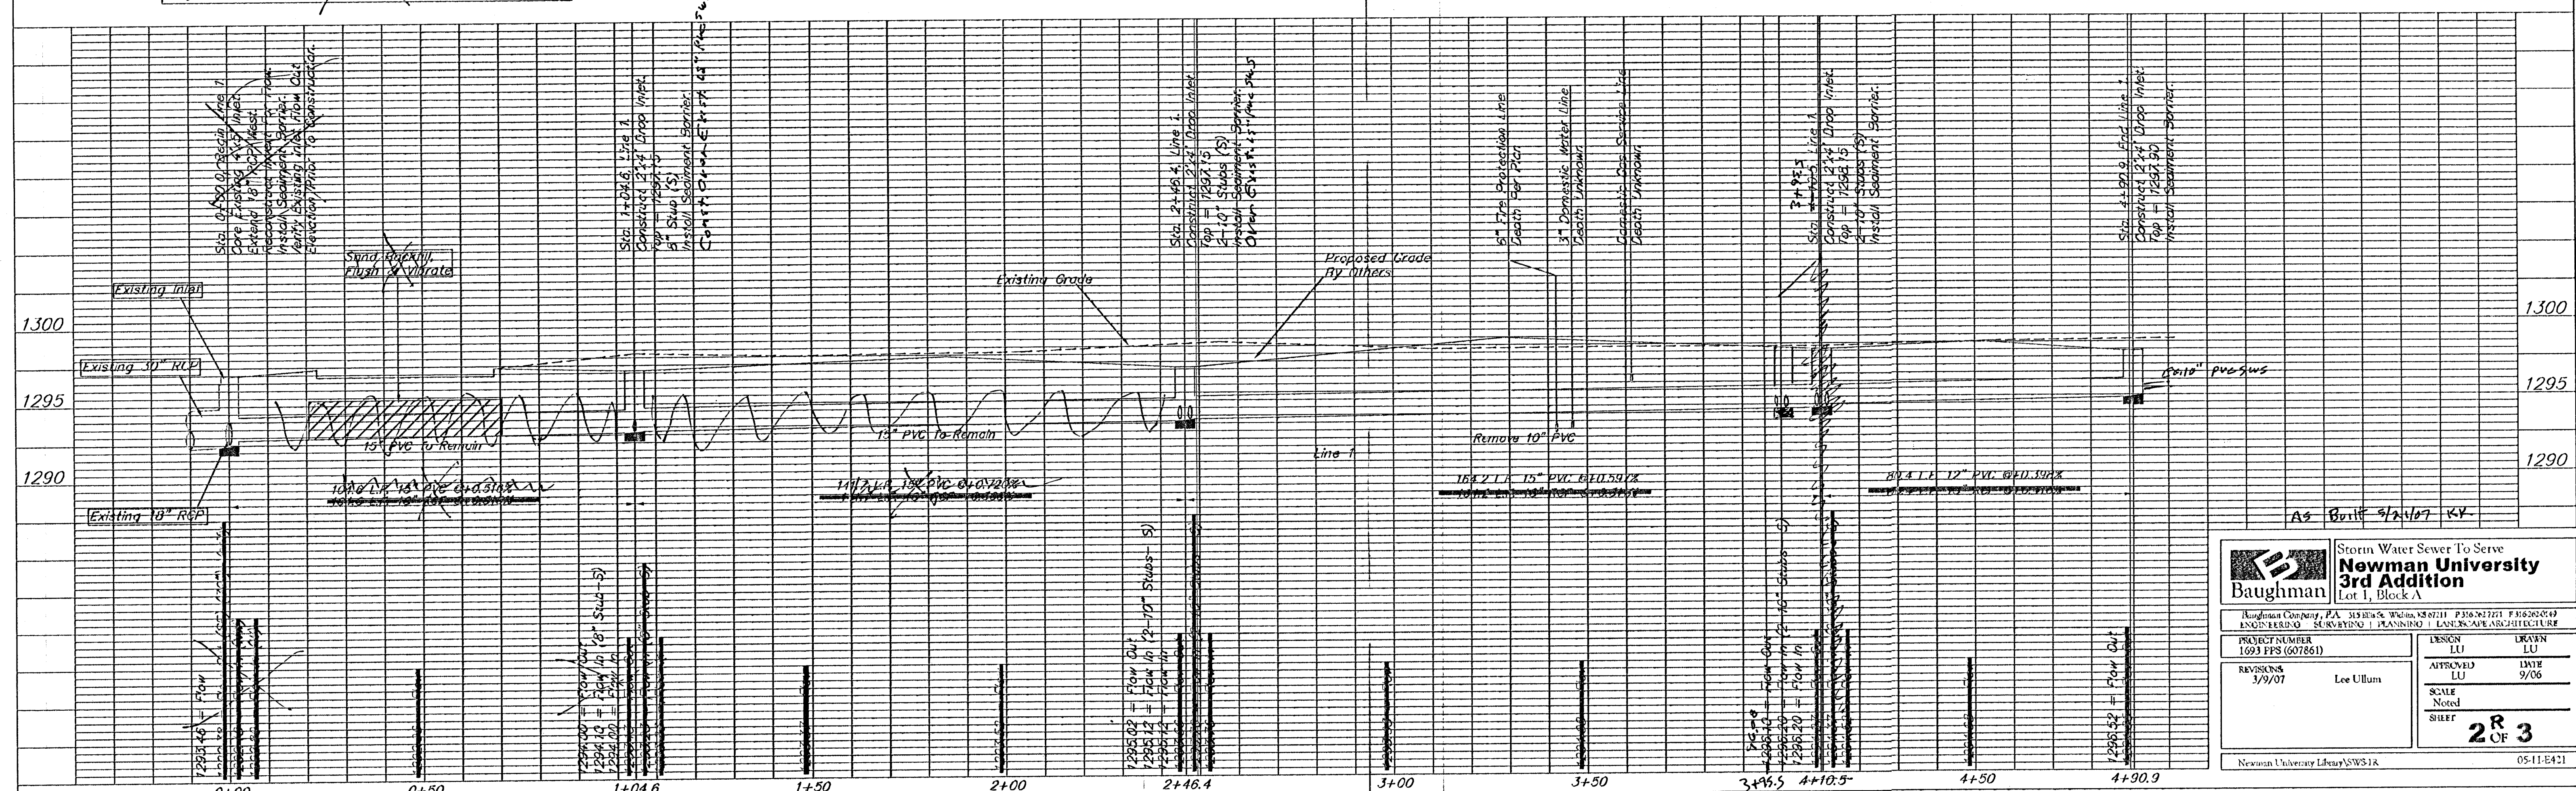

Baughman Storm Water Sewer To Serve Newman University 3rd Addition Lot 1, Block A

Revised: 3/9/07 Lee Ullum

PROJECT NUMBER: 1693 FFS (607861)

REVISIONS: 3/9/07

DESIGN: LU

APPROVED: LU

SCALE: Noted

SHEET: 2 OF 3

Newman University Library/SWS1R 05-11-E421