
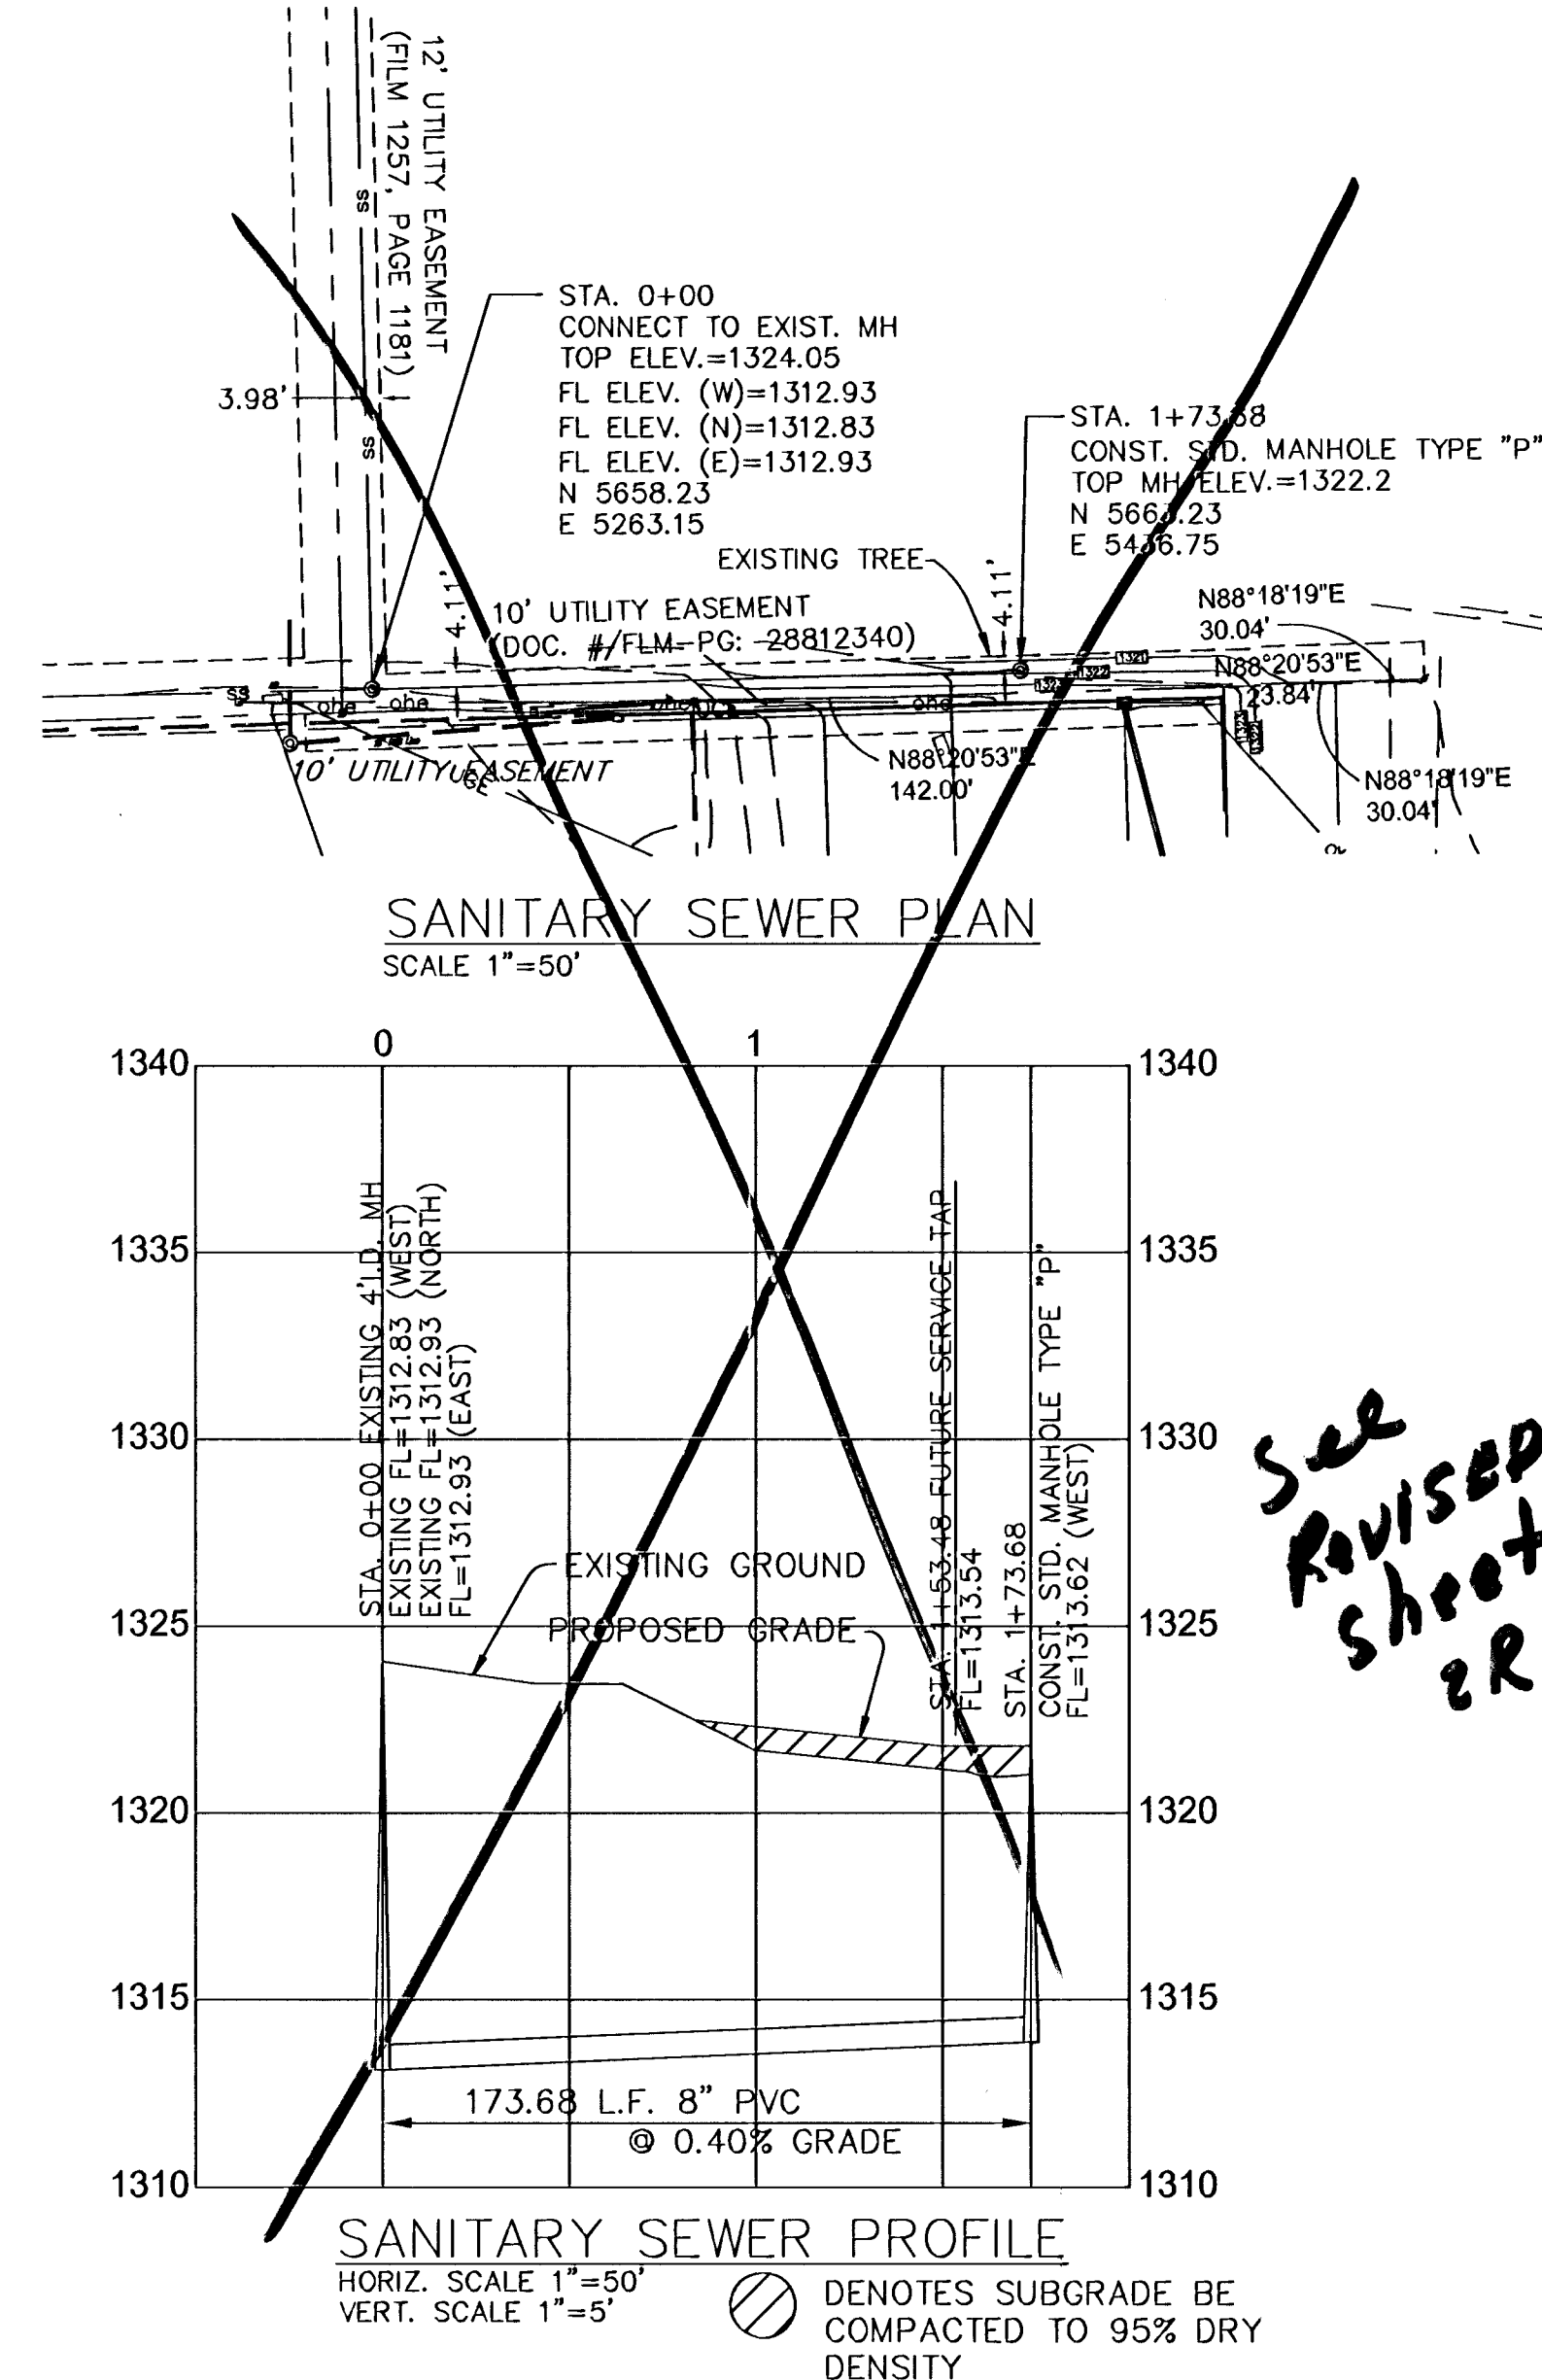


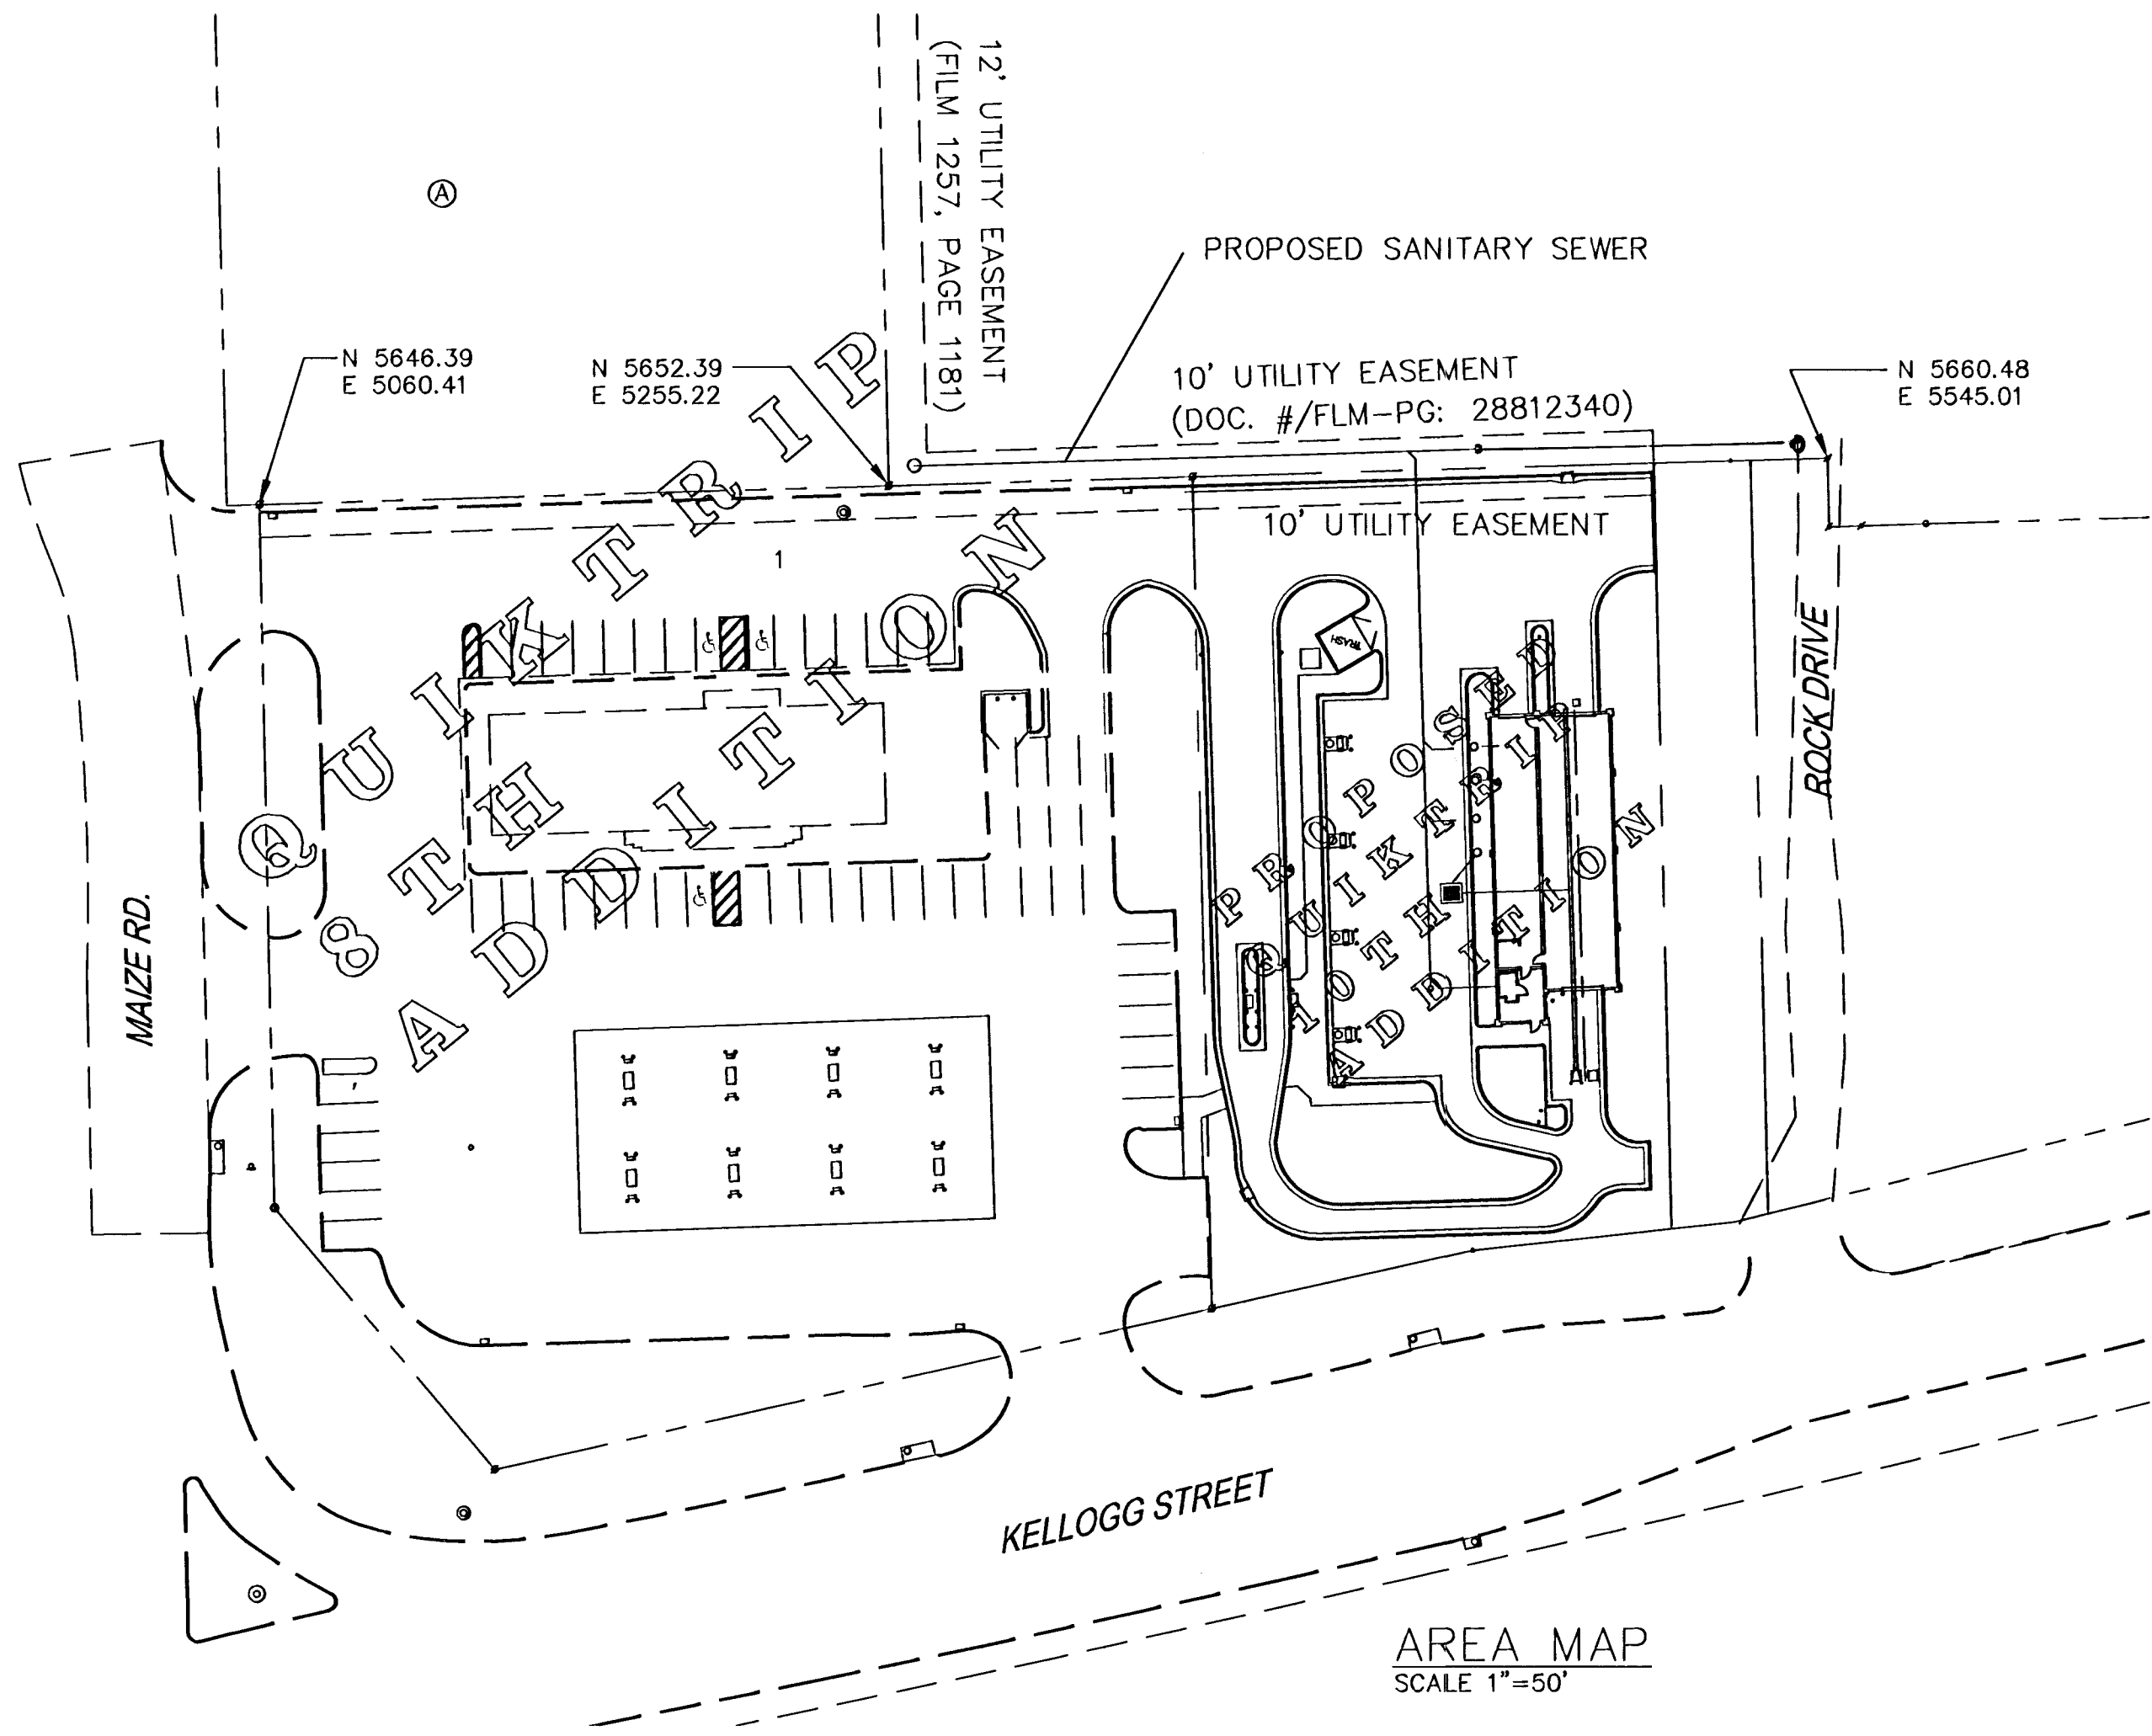

Original Signed

10.18.06

FINAL		POE & ASSOCIATES, INC. CONSULTING ENGINEERS 5940 E. Central Suite 200 Wichita, KS 67208-2427 Phone 316.685-4114 FAX 316.685-4444		SANITARY & STORM SEWER IMPROVEMENTS SANITARY SEWER PLAN & PROFILE CITY OF WICHITA, KANSAS JAMES ARMOUR, P.E. - CITY ENGINEER 1711 PPS (607861)		QUICKTRIP #315	
Designed By: D. Trout	Drawn By: D. Trout	Poe Job No.: 1894-02	Date: 10/18/2006	Sheet 2 of 6	Revision	No.	Date