
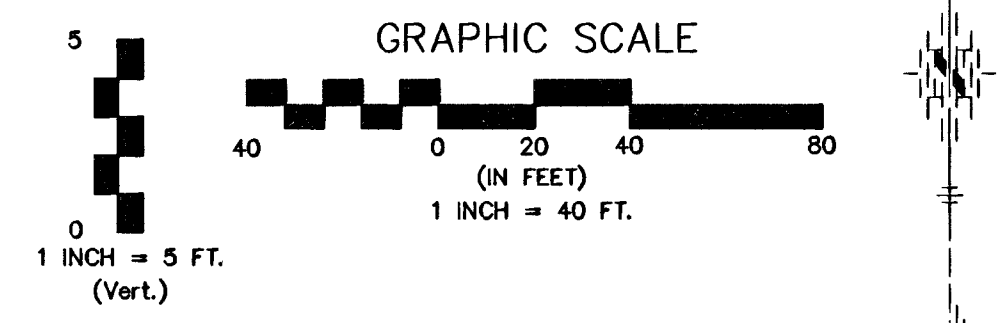
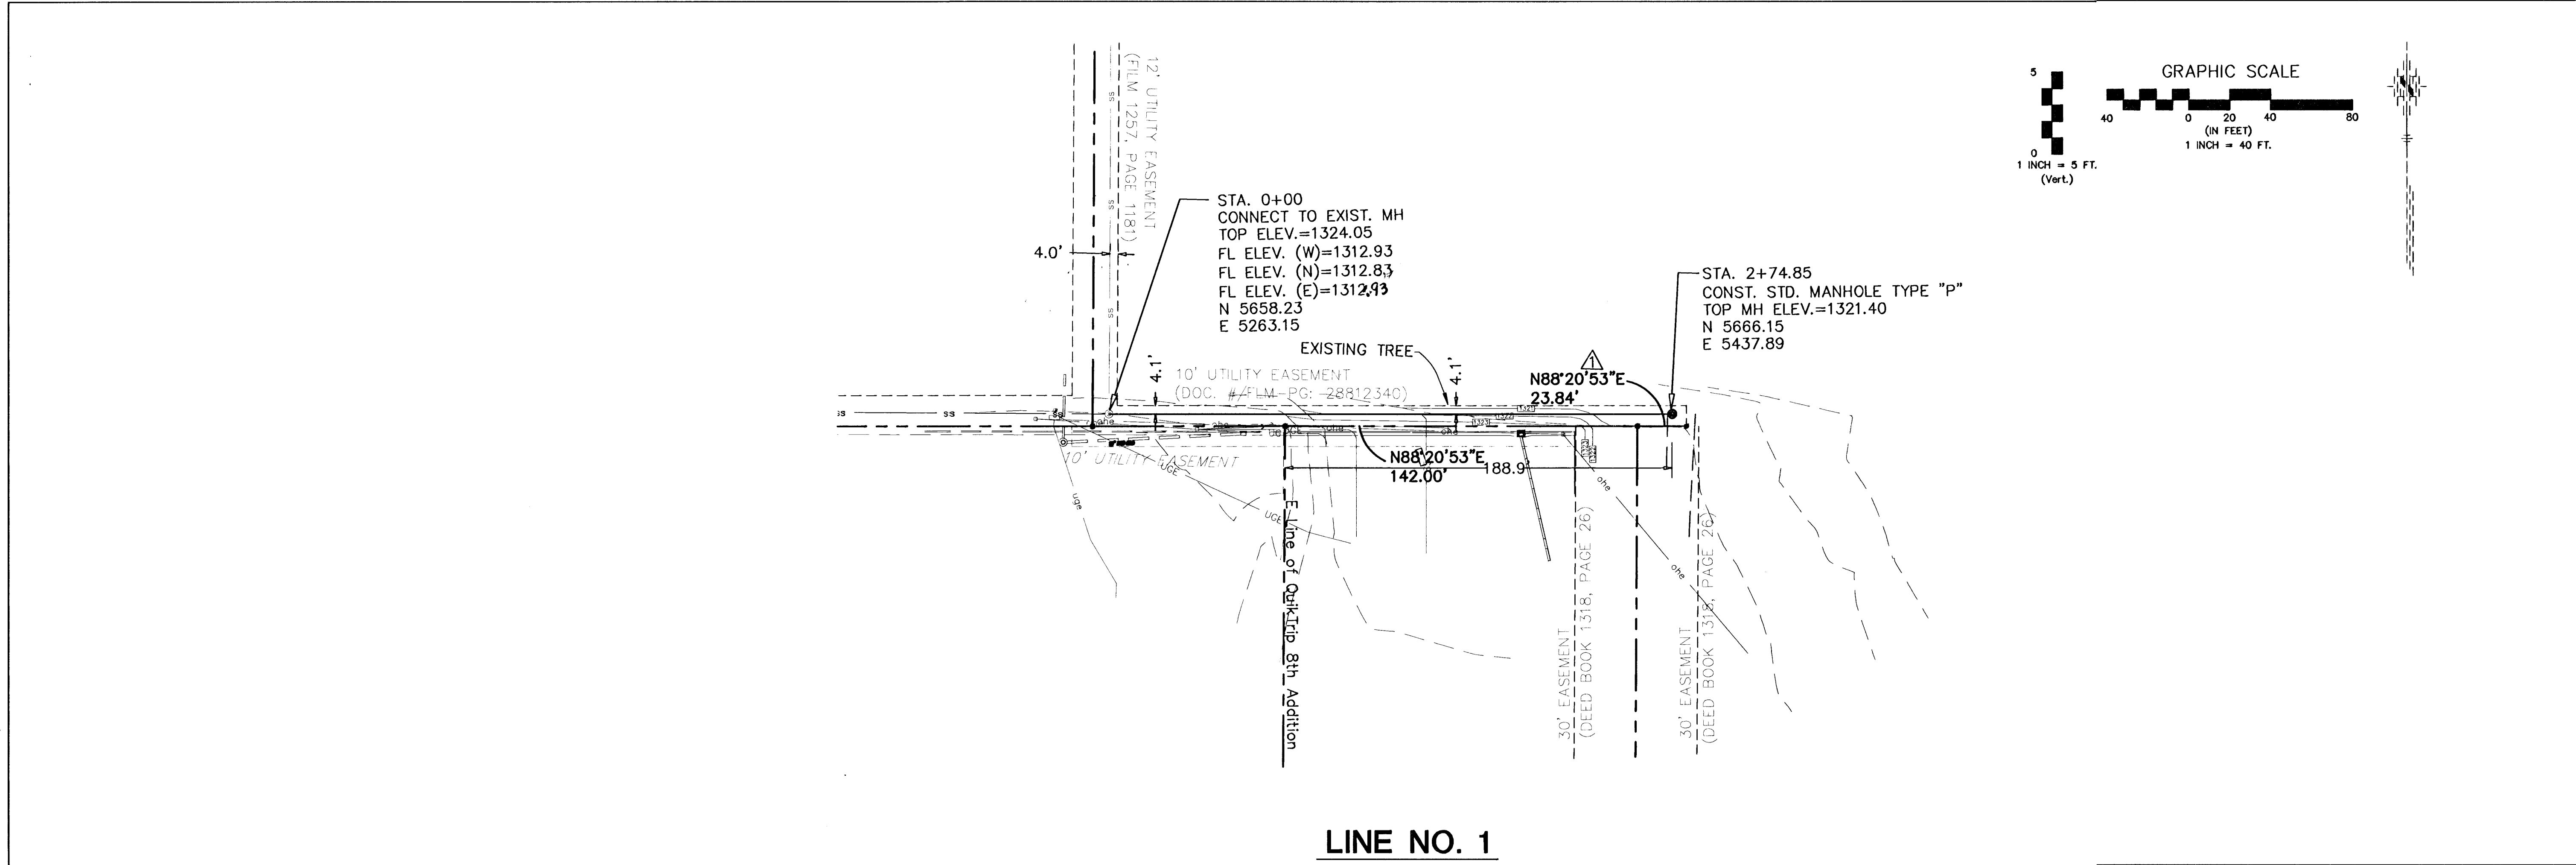


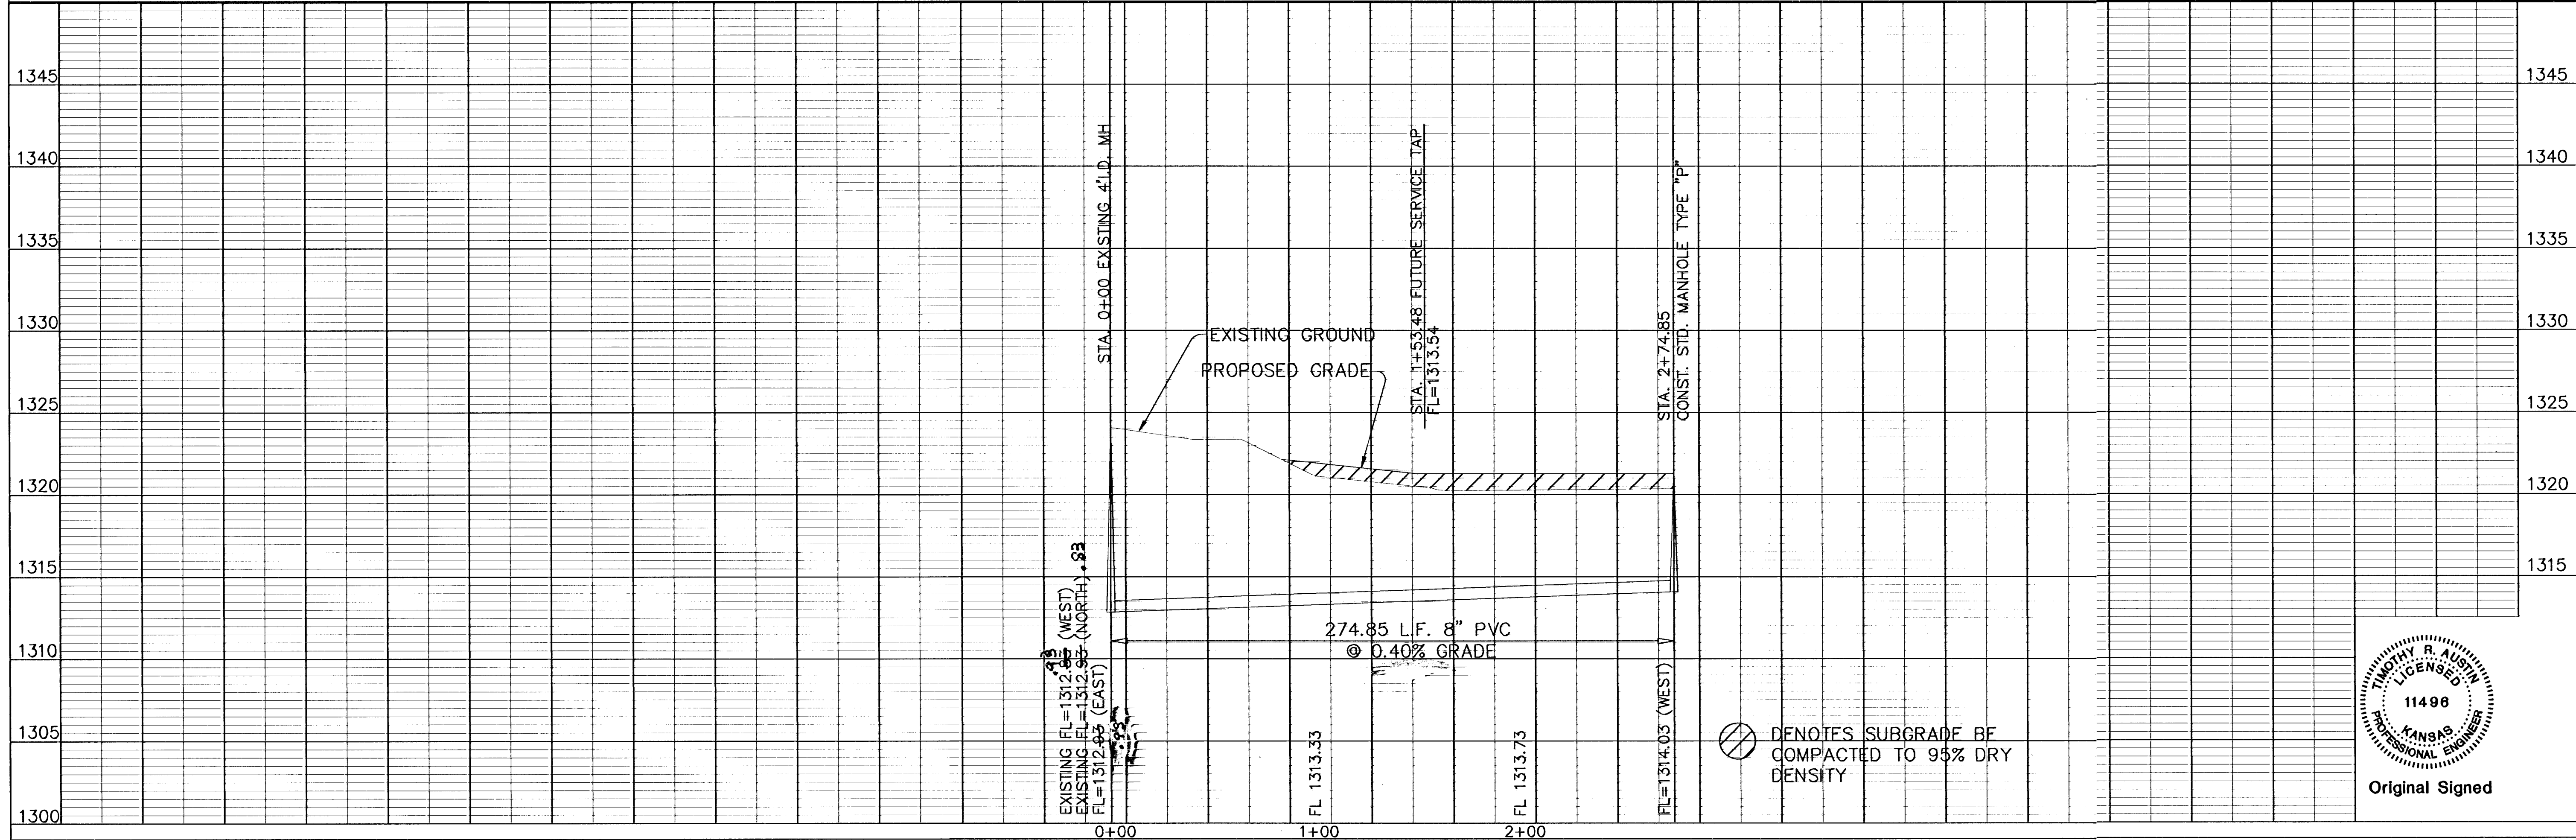

QUICKTRIP #315 SANITARY & STORM SEWER IMPROVEMENTS SANITARY SEWER PLAN & PROFILE CITY OF WICHITA, KANSAS JAMES ARMOUR, P.E. - CITY ENGINEER 1711 PPS (607861)		POE & ASSOCIATES, INC. CONSULTING ENGINEERS 5940 E. Central, Suite 200, Wichita, KS 67208-4422 Phone 316/685-4114 FAX 316/685-4444	
No.	Revision	Designed By: D. Trout	Drawn By: D. Trout / A. Moss
1	10/26/06	Poe Job No.: 1894-02	Date: 10/27/2006
Extended Pipe 100' East & Relocated MH		Sheet 28 of 6	