


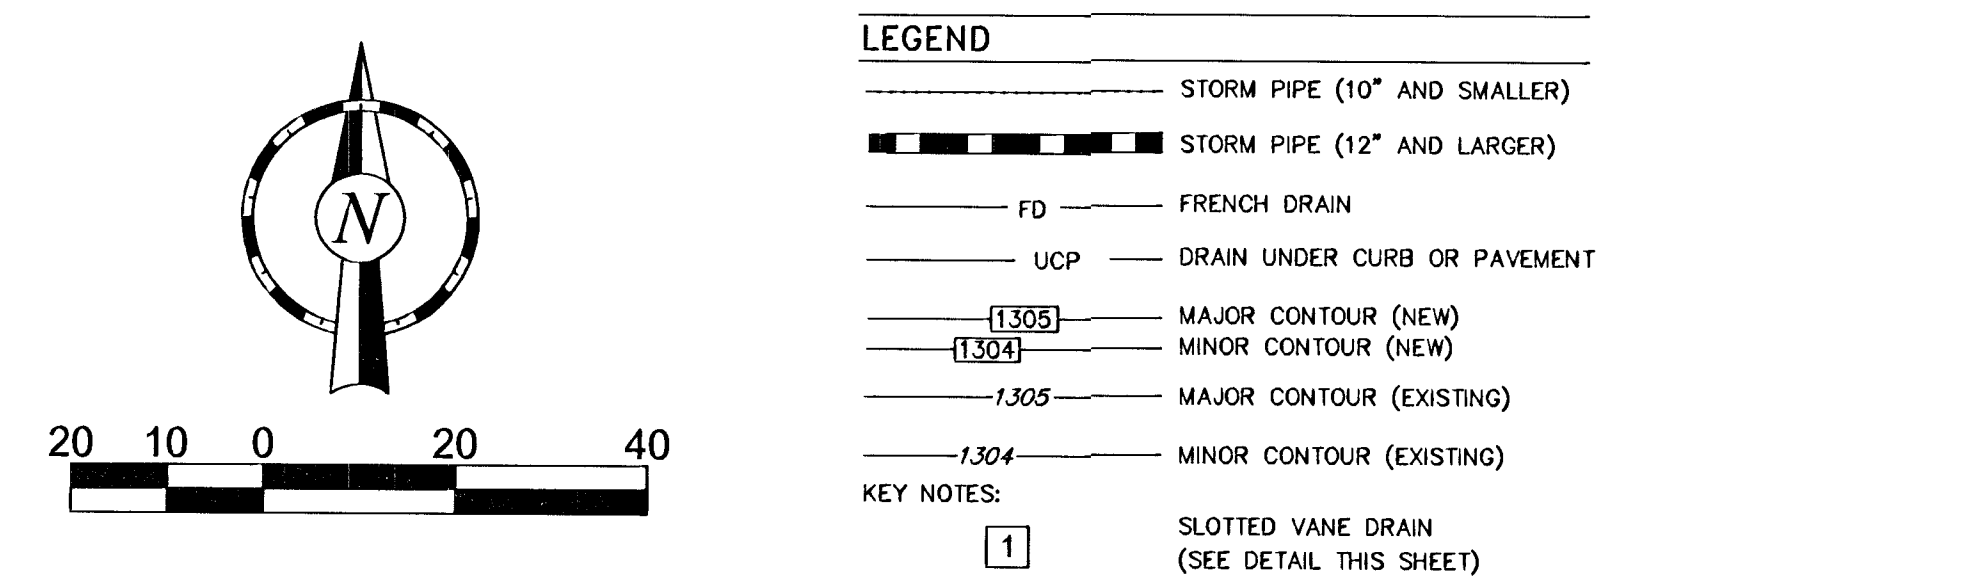


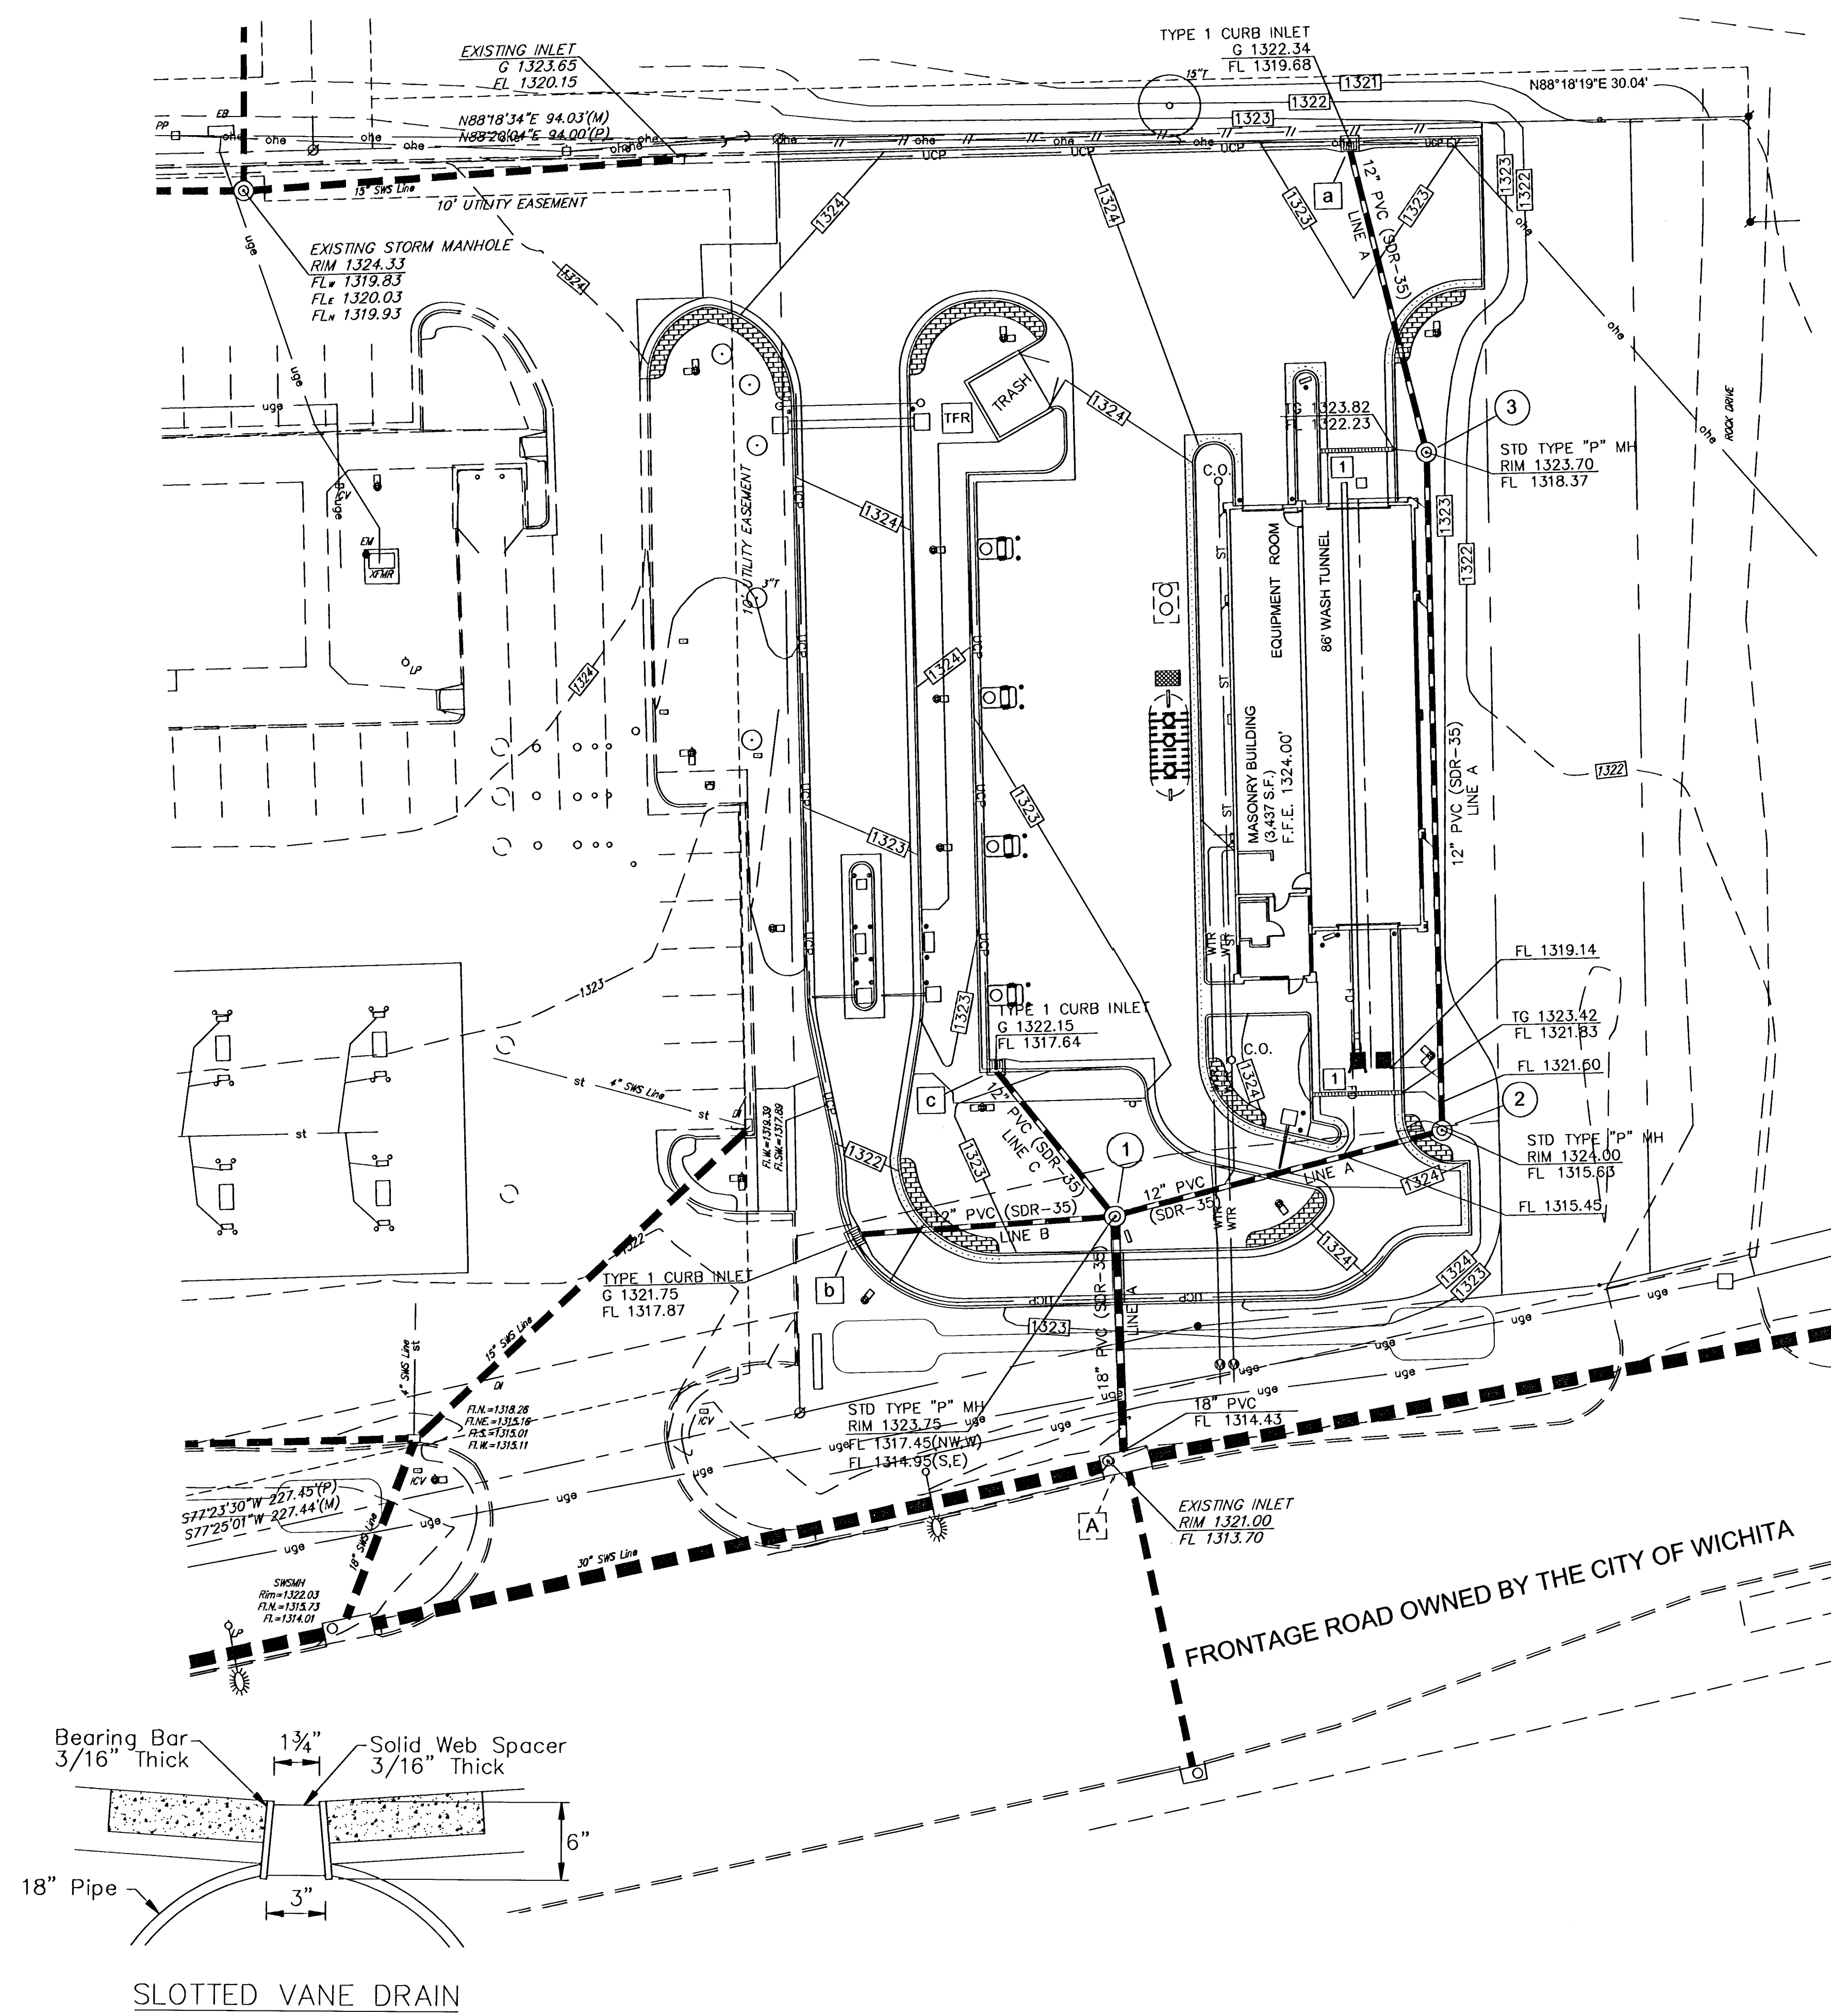


- LEGEND**
- STORM PIPE (10" AND SMALLER)
 - STORM PIPE (12" AND LARGER)
 - FD — FRENCH DRAIN
 - UCP — DRAIN UNDER CURB OR PAVEMENT
 - (1305) — MAJOR CONTOUR (NEW)
 - (1304) — MINOR CONTOUR (NEW)
 - 1305 — MAJOR CONTOUR (EXISTING)
 - 1304 — MINOR CONTOUR (EXISTING)
- KEY NOTES:**
- 1 SLOTTED VANE DRAIN (SEE DETAIL THIS SHEET)

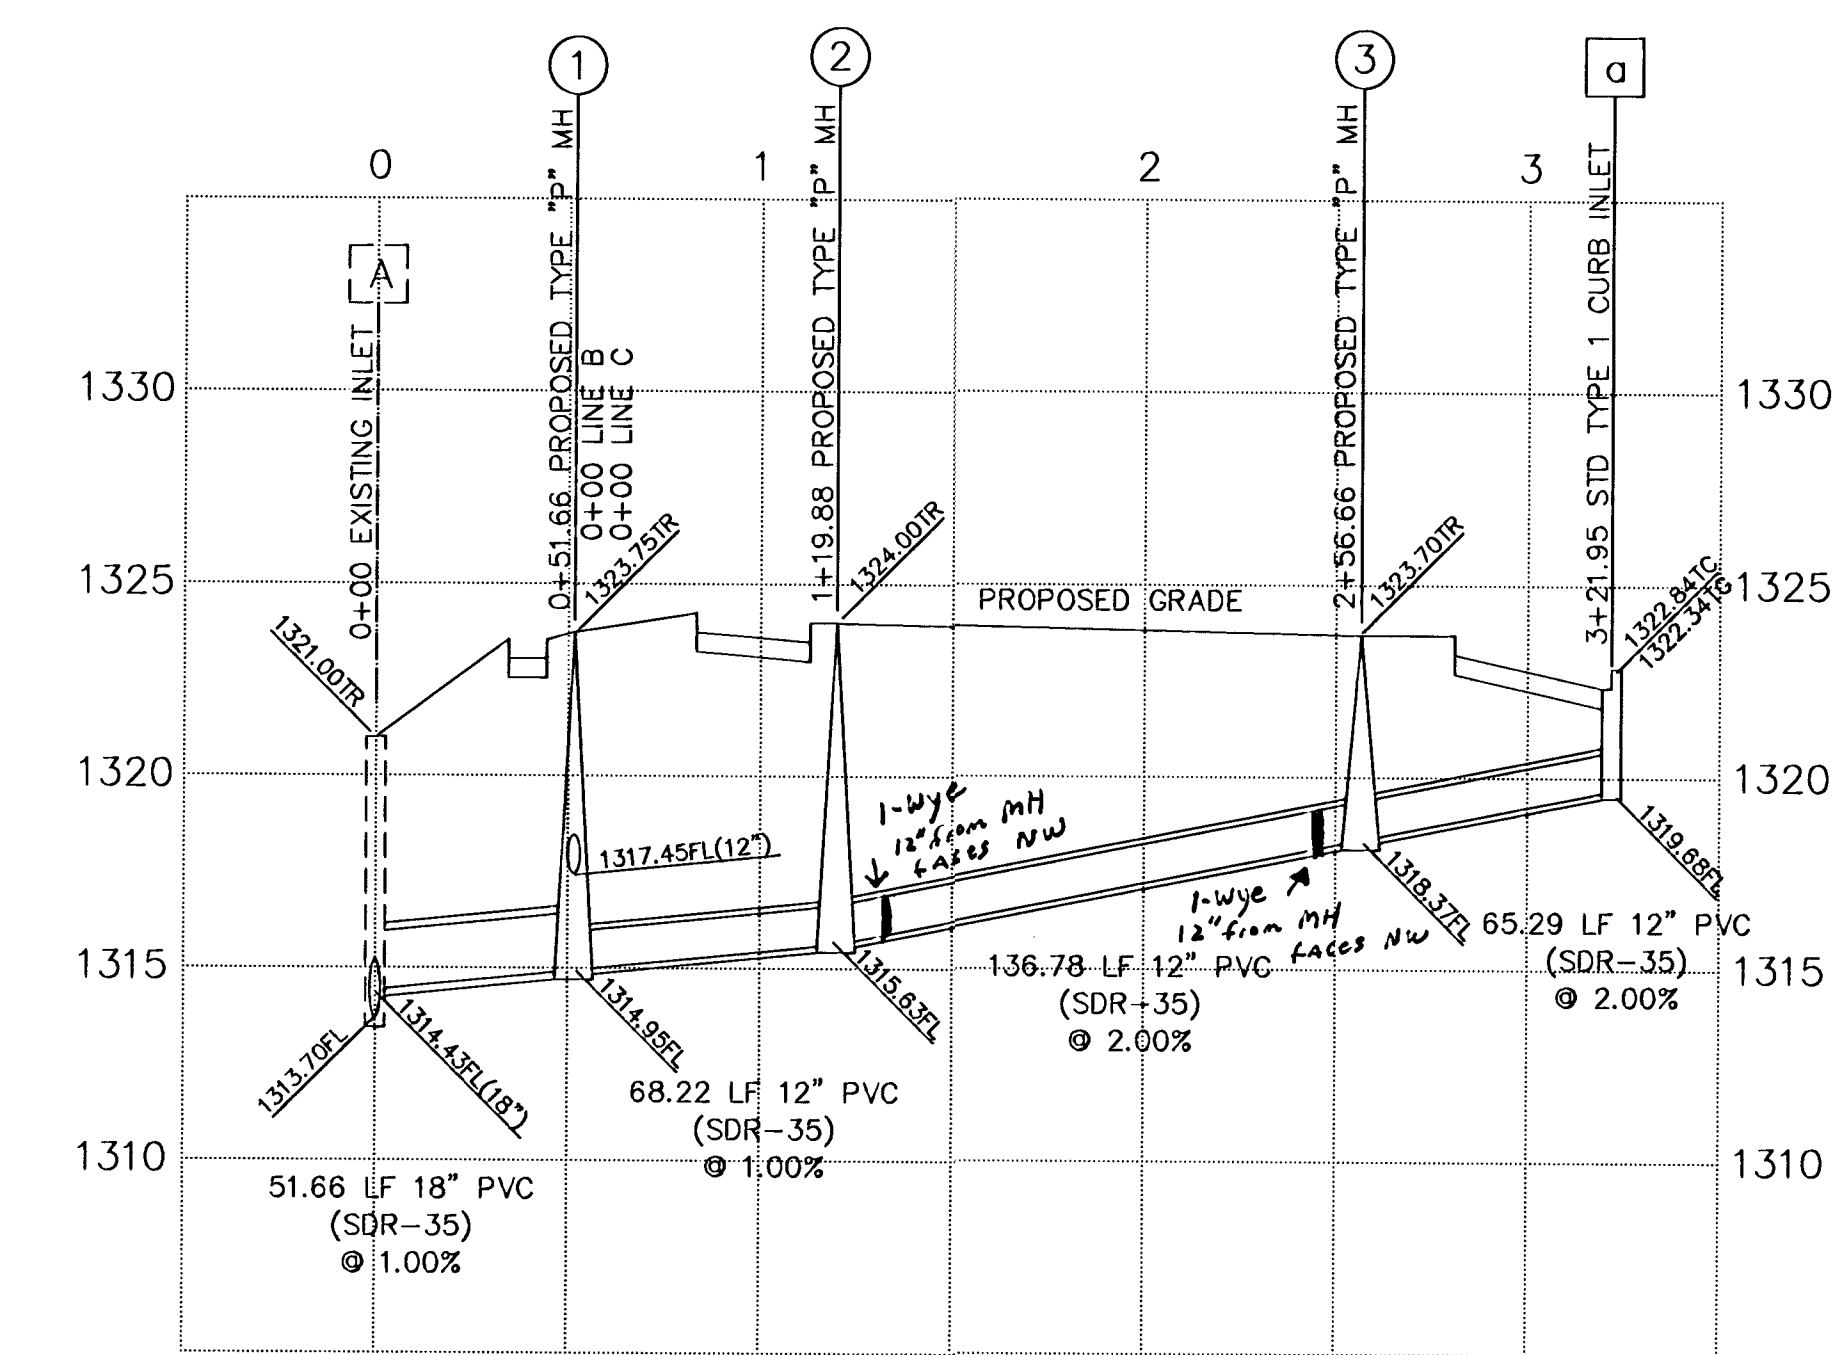


STORM SEWER PROFILE A
 HORIZ. SCALE 1"=50'
 VERT. SCALE 1"=5'

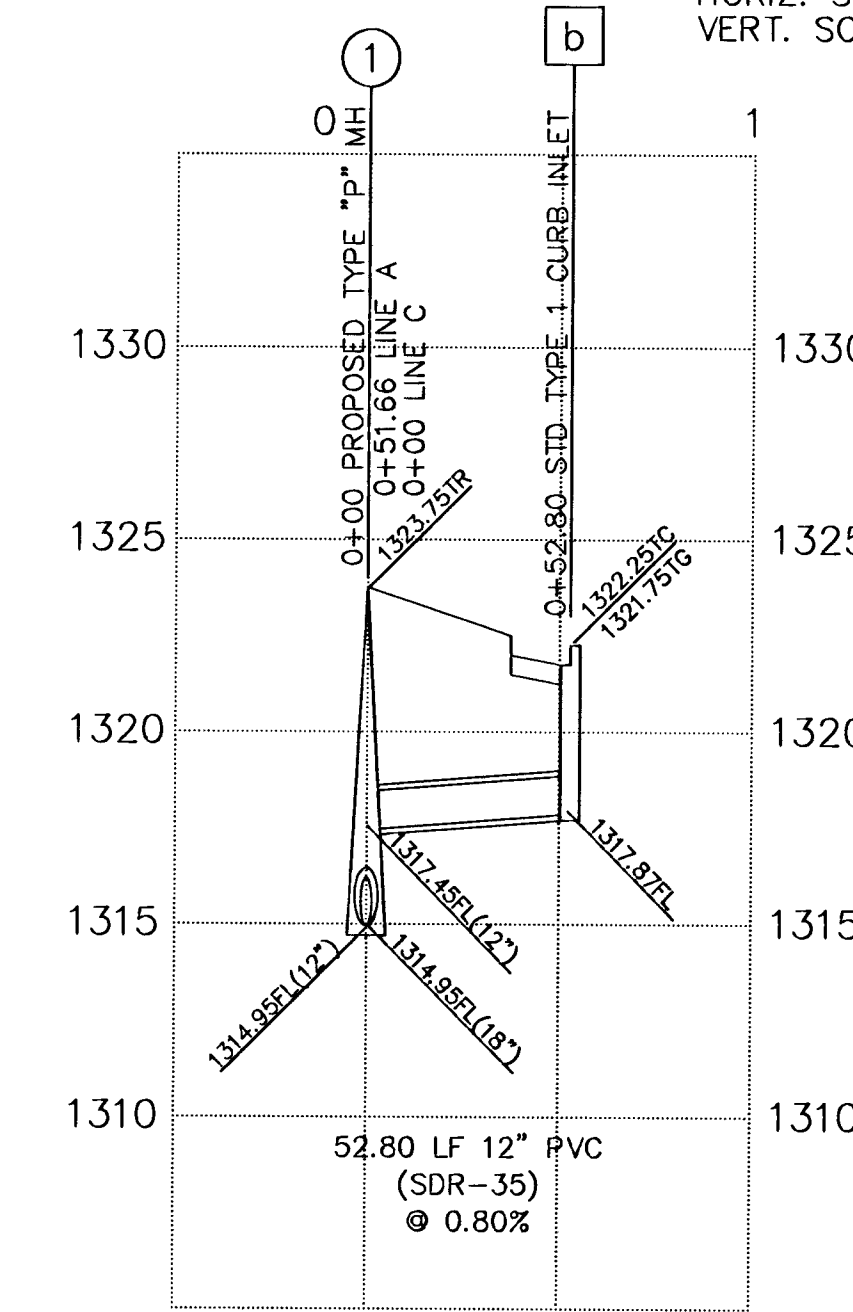

STORM SEWER PROFILE B
 HORIZ. SCALE 1"=50'
 VERT. SCALE 1"=5'

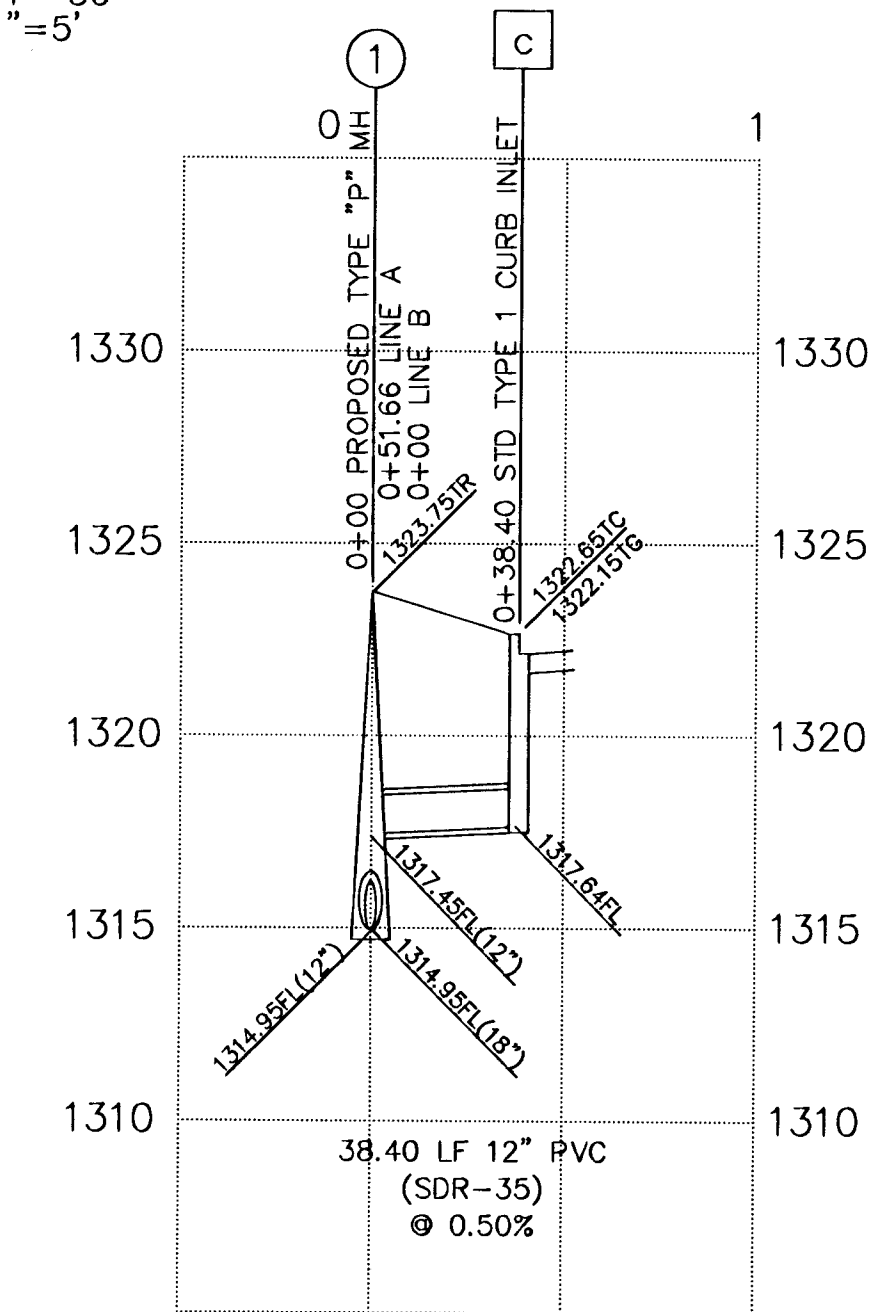

STORM SEWER PROFILE C
 HORIZ. SCALE 1"=50'
 VERT. SCALE 1"=5'

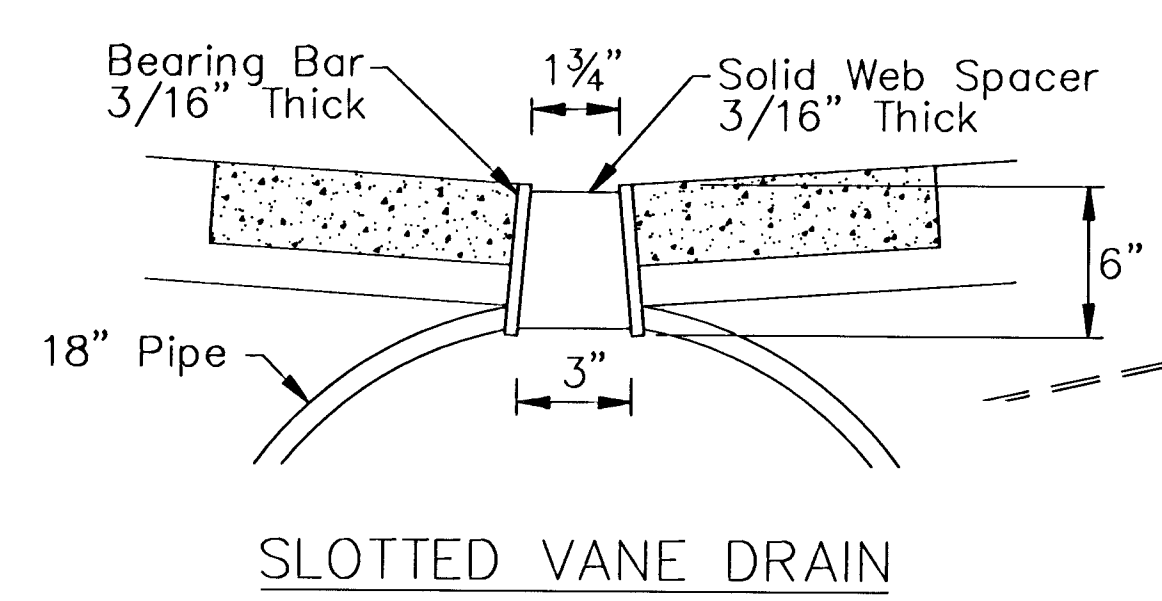

QUICKTRIP #315 SANITARY & STORM SEWER IMPROVEMENTS STORM SEWER PLAN AND PROFILES CITY OF WICHITA, KANSAS JAMES ARMOUR, P.E. - CITY ENGINEER 1711 PPS (60786)	No.	Date	By	Approved	Revision

POE & ASSOCIATES, INC. CONSULTING ENGINEERS 5940 E. Central, Suite 200 ■ Wichita, KS 67208-4242 Phone 316/685-4114 ■ FAX 316/685-4444	

FINAL	Designed By: HRA
	Drawn By: JRB/A. Moss
	Poe Job No.: 1894-02
	Date: 10/20/2006