
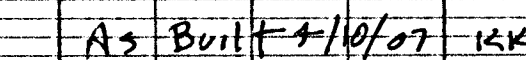


NORTHRIDGE
PLAZA
ADDITION
LOT #2

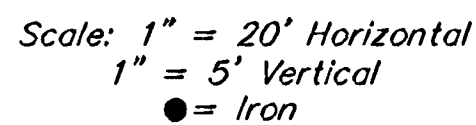

 Baughman ENGINEERING	Line 1 STORM WATER SEWER IMPROVEMENTS
Baughman Company, P.A. 315 Eilla St. White, MS 67111 F 316-3632171 F 316-3631049 ENGINEERING SURVEYING PLANNING LANDSCAPE ARCHITECTURE	
PROJECT NUMBER 1714 PPS	DESIGN DRAWN JEB
REVISIONS:	APPROVED DATE AEG 11/06
	SCALE Noted
	SHEET
7 OF 17	
Northwest Medical Office\sws1.dwg 06-07-E602	