SHEET NO.	TOTAL SHEETS
CS1.3	

SCALE:
PLAN: LAT. & LONG. 0 40 80
PROFILE: HORIZ. SAME AS ABOVE
VERT. 5 0

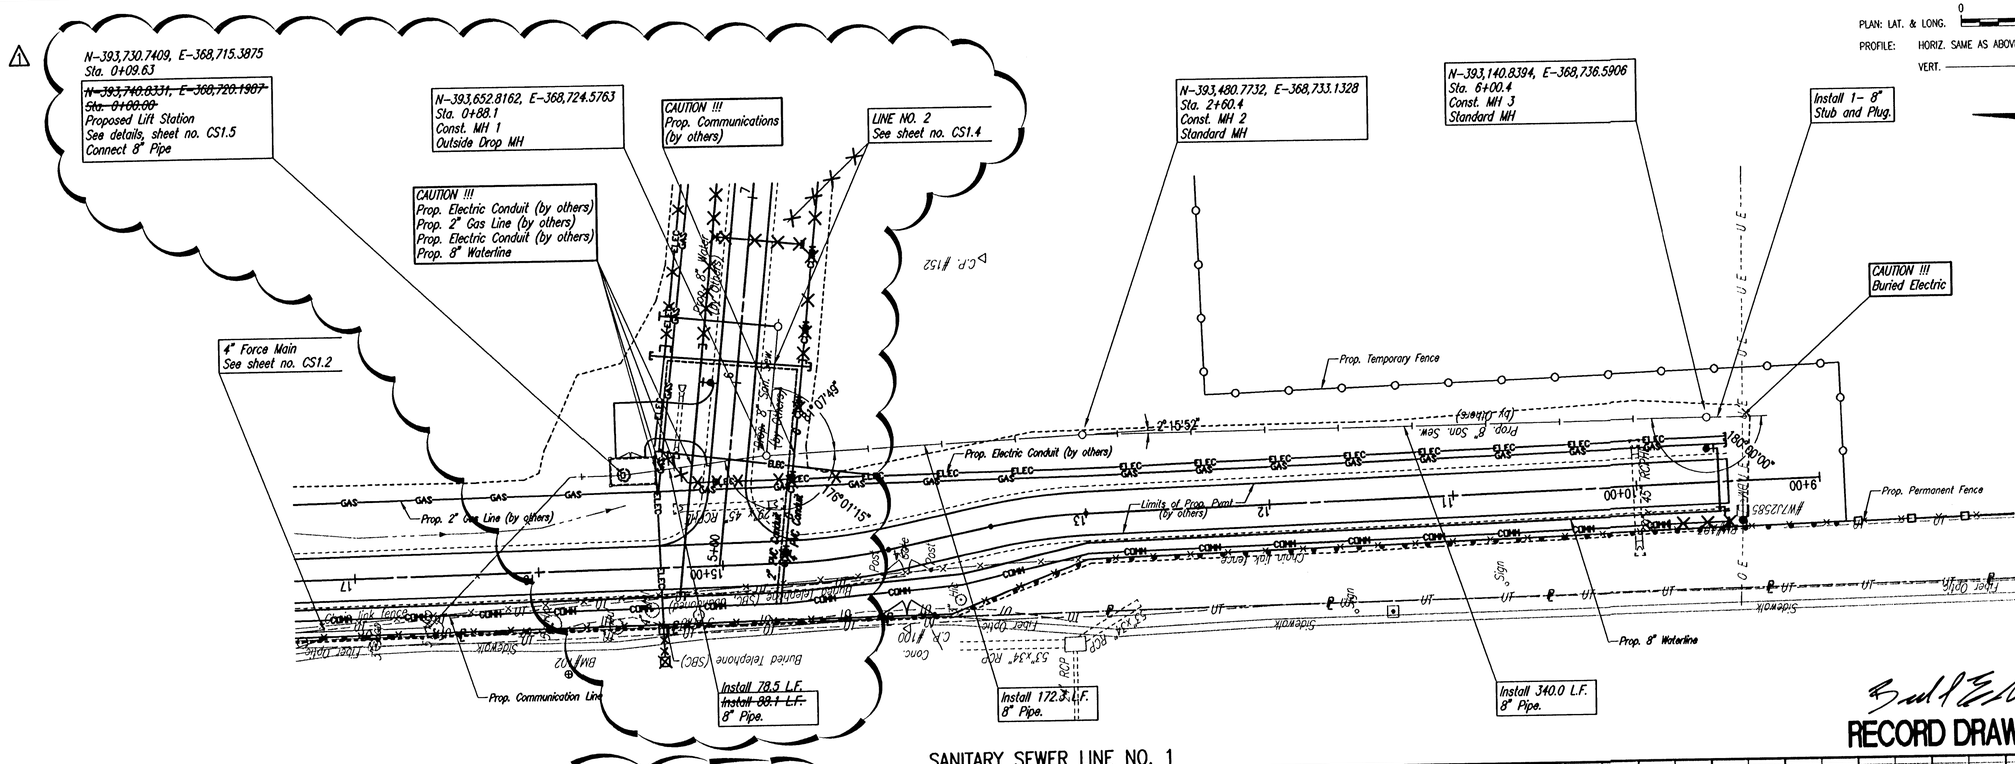

THE WICHITA AIRPORT AUTHORITY
COLONEL JAMES JABARA AIRPORT

SANITARY SEWER LINE NO. 1

SANITARY SEWER AND WATER DISTRIBUTION SYSTEM
SOUTHWEST AREA SITE DEVELOPMENT IMPROVEMENTS

Professional Engineering Consultants, P.A.
303 S. TOPEKA • WICHITA, KANSAS 67202
316-262-2691 • FAX 316-262-3003

Date SEPTEMBER 2005 | Job No. 05471-019

No.	Revision	By	Date
1	CHANGE ORDER #1 - RELOCATE LIFT STATION	ALA	10/12/06

Saved: 04-16-2007 4:59:36 PM by TLS
Plot Scale: 1:40 05-07-2007 10:07:46 AM by TLS
Q:\2005\05471\Record Drawings\PPS-Record Drawings\05471-000-C-SSPR01-CHANGEORDER1