PROJECT No. 141PPP
OCA No. 607879

HAWTHORNE ADDITION
ROSEMOMT CIRCLE
STORM WATER SEWER PLANS

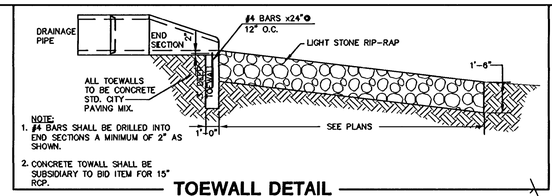

NOTE:
1. #4 BARS SHALL BE DRILLED INTO END SECTIONS A MINIMUM OF 2" AS SHOWN.
2. CONCRETE TOWALL SHALL BE SUBSIDIARY TO BID ITEM FOR 15" RCP.

TOEWALL DETAIL
NTS

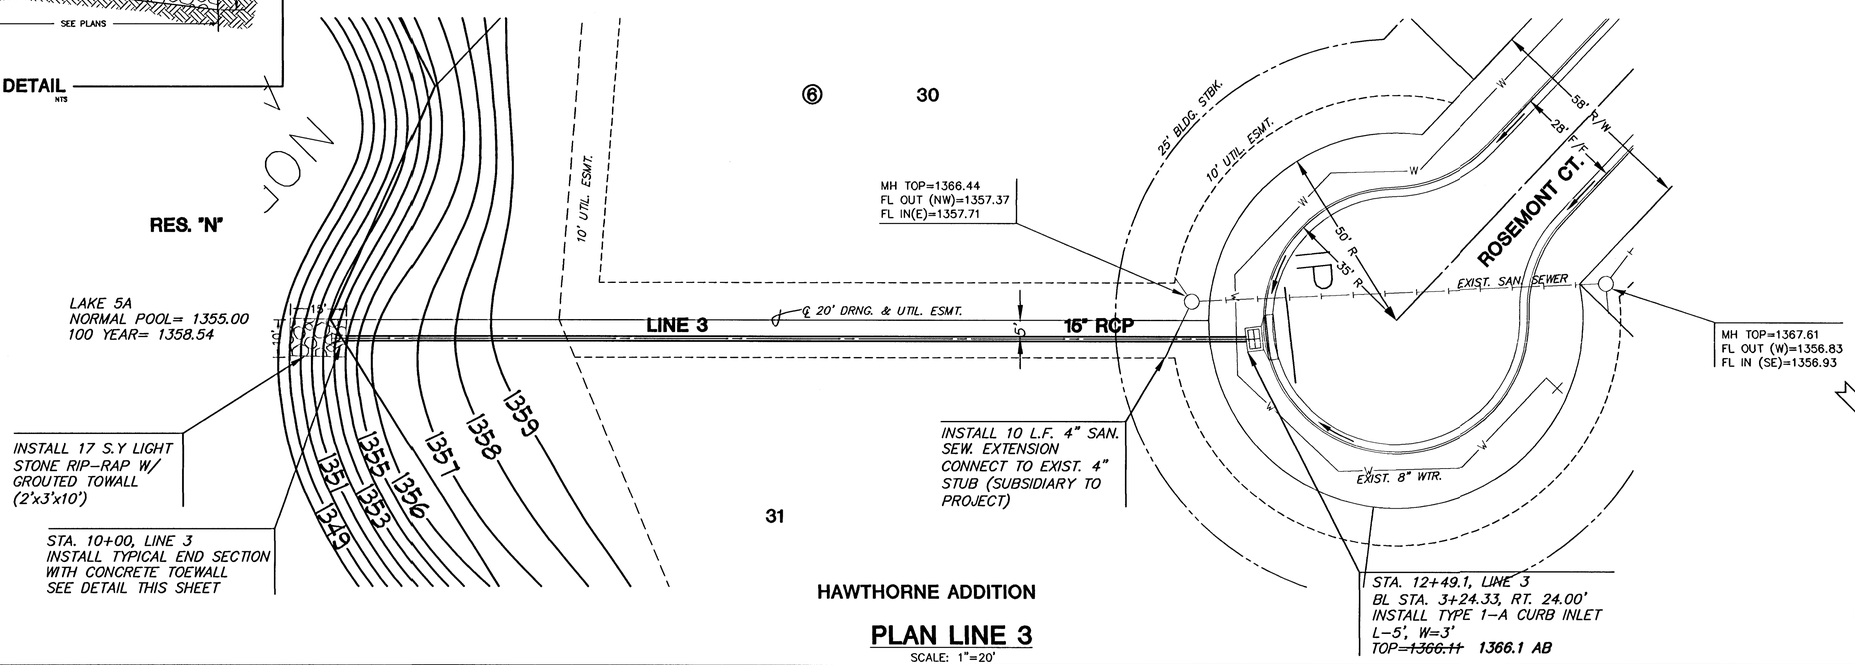

HAWTHORNE ADDITION

PLAN LINE 3
SCALE: 1"=20'

SCALE: 1"=20'
20 10 0 20

AS-BUILT MAY 2007

PROFILE LINE 3
SCALE: HORIZ. 1"=20'
SCALE: VERT. 1"=5'

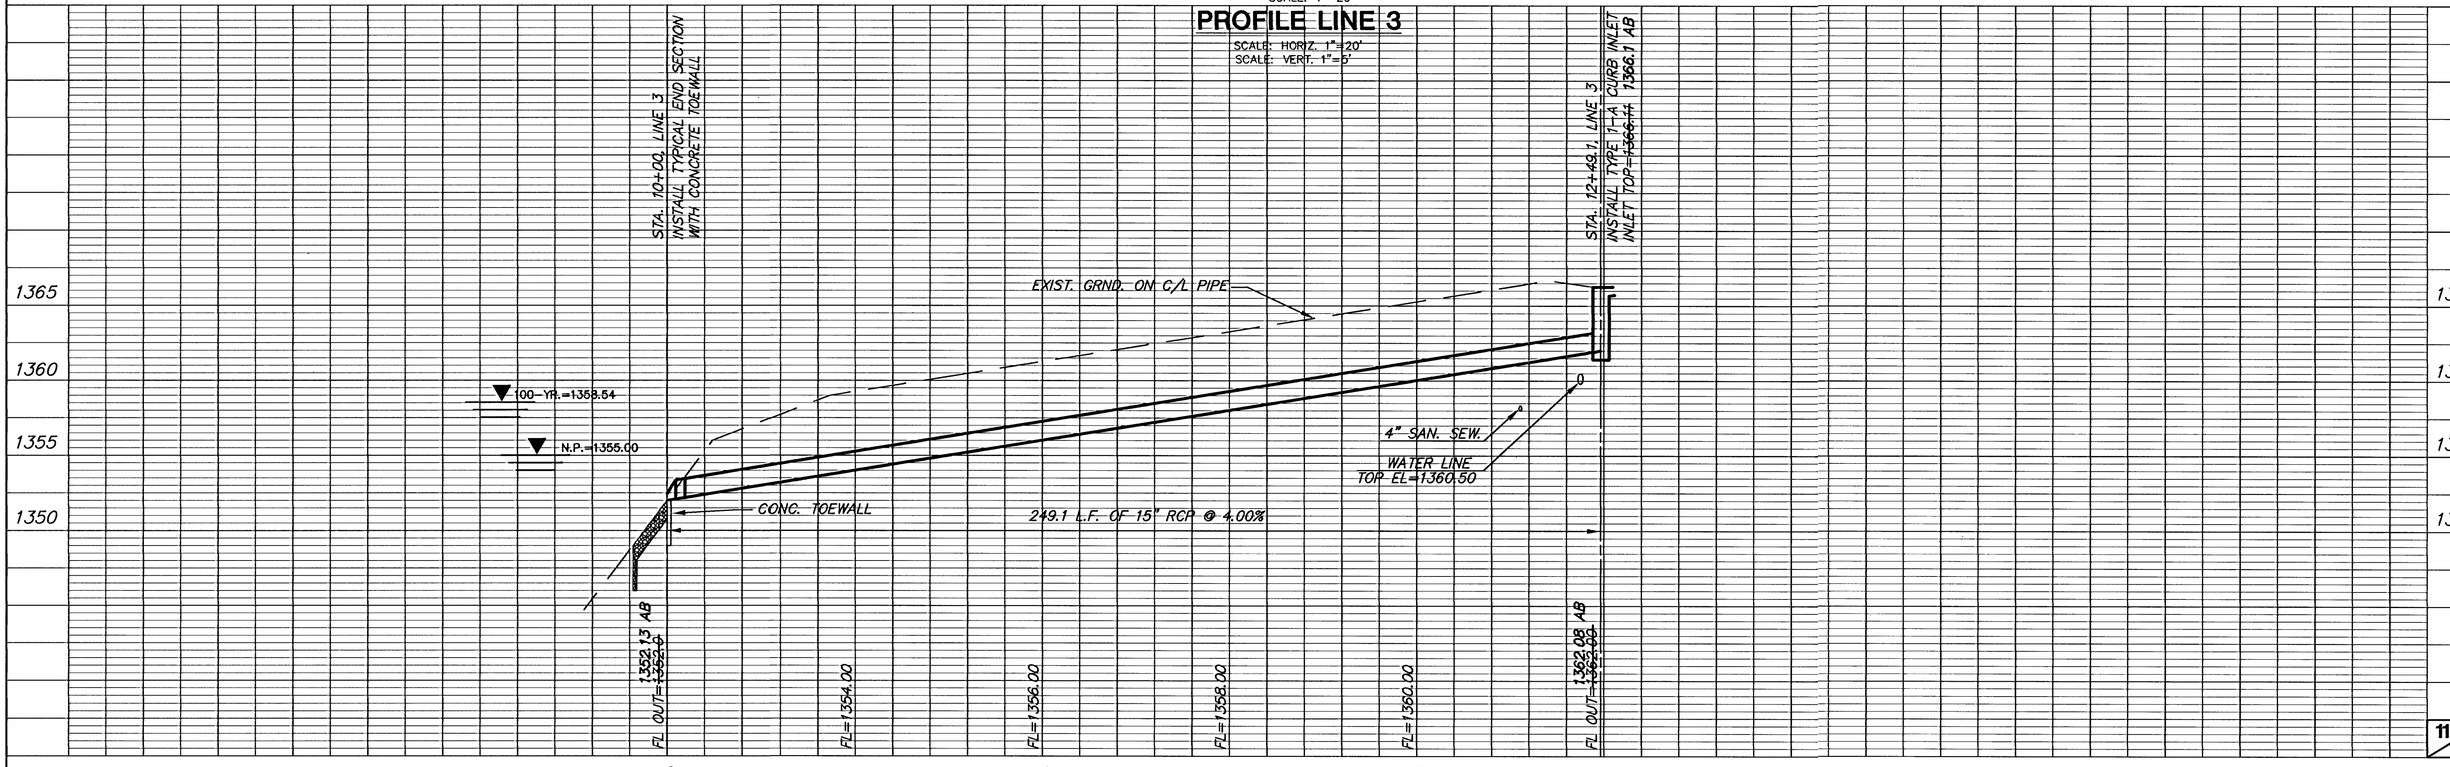

H:\CIVIL\02167\DWG\Sws\Ph1\02167D2.dwg