

BEGINNING OF PROJECT
STA. 0+00

MATCH LINE TO STA. 6+00

1+00

2+00

PILOT CHANNEL

4+00

5+00

LEGEND


TURF AREAS TO BE SEEDED

NOTE: SEED ALL AREAS DISTURBED BY CONSTRUCTION.



A
LP-1

CANAL ROUTE IMPROVEMENT LANDSCAPE PLAN NO. 1

0' 10' 20' 1"=20'-0"

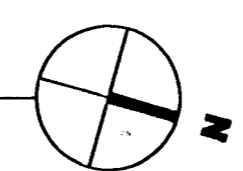

Not Built!

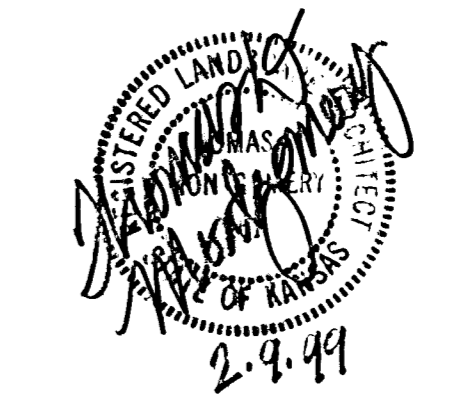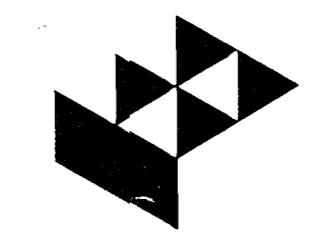

GossenLivingston

3					
2					
1					
NO.	DATE	REVISIONS	BY	APP'D	
CITY OF WICHITA					
LANDSCAPE PLAN					
LP-1					
SHEET NO.	OF	SCALE	APP'D		
DESIGNED		DETAILED	QUANTITIES	TRACED	
DESIGN CK.		DETAIL CK.	QUAN. CK.	TRACE CK.	