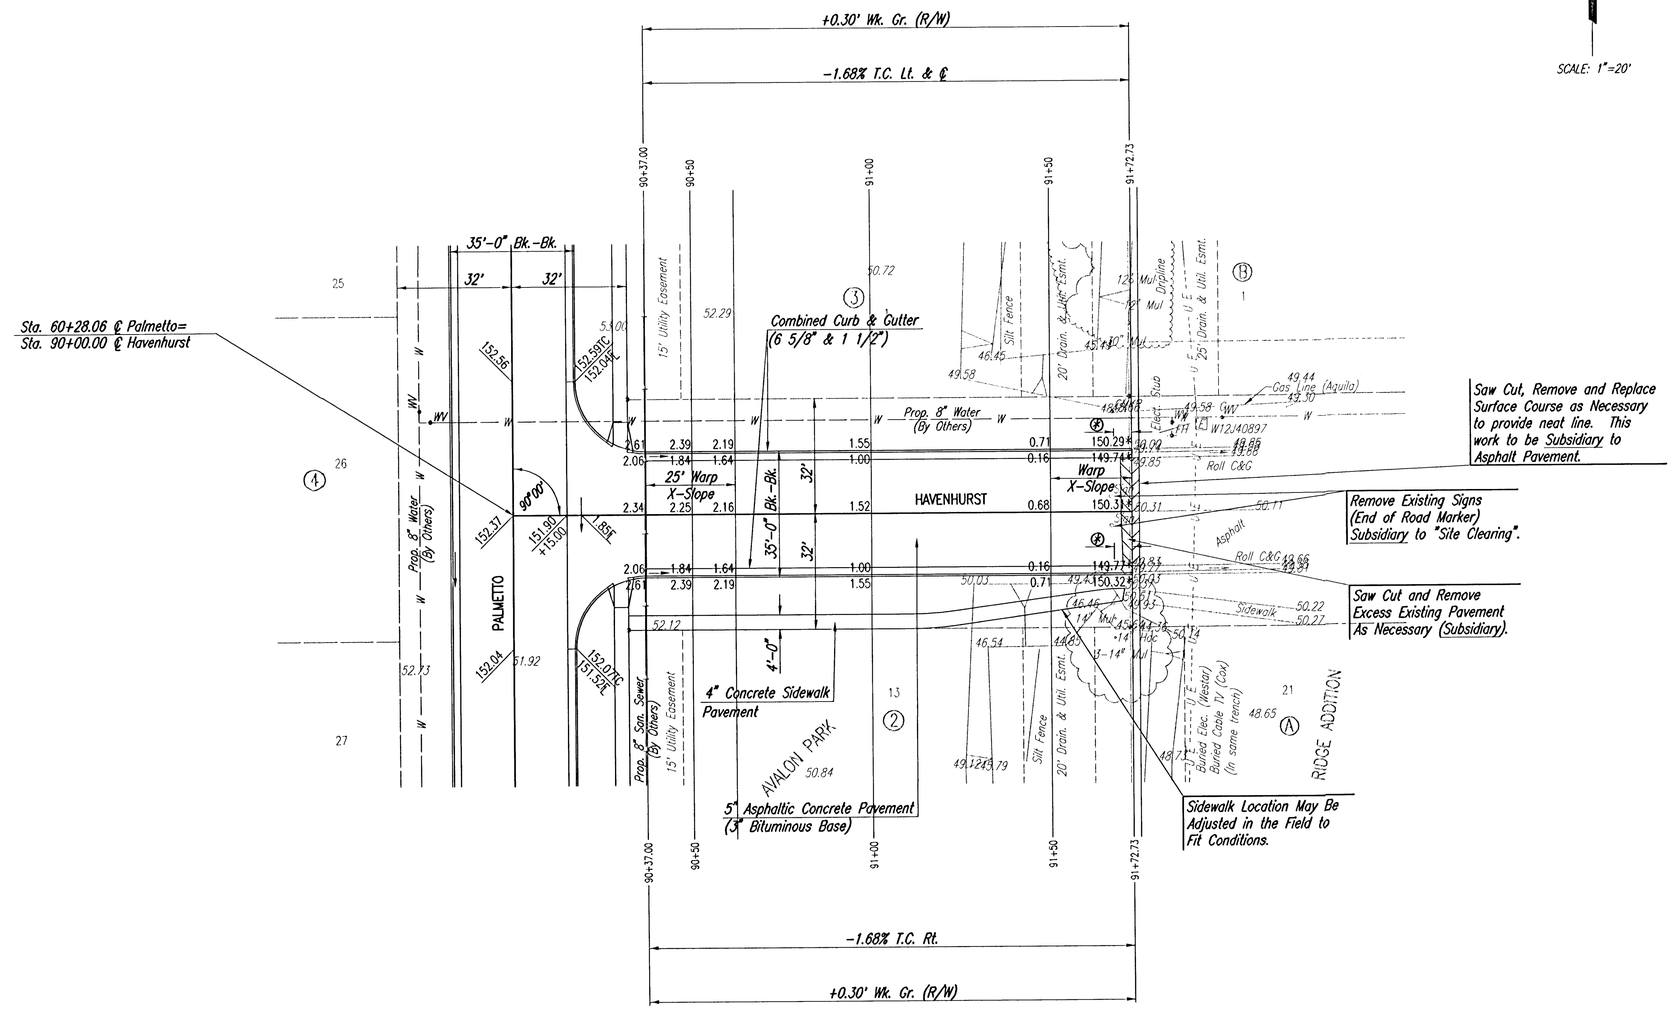

* Match Existing

⊛ 5' Transition from Combined Curb and Gutter (6 5/8" & 1 1/2") to Combined Curb and Gutter (3 5/8" Roll & 1 1/2"). To be bid and paid for as "Combined Curb and Gutter (6 5/8" & 1 1/2")".

02 OCT 06

RECORD DRAWING

BRIAND BOUTWELL LICENSED 10889 PROFESSIONAL ENGINEER

6-15-05

No.	Revision	By	Date

AVALON PARK-PHASE 4

HAVENHURST

STA. 90+00 TO STA. 91+72.73

JAMES L. ARMOUR, P.E.-CITY ENGINEER
CITY OF WICHITA PROJECT NO. 472-83838

Professional Engineering Consultants, P.A.
303 S. TOPEKA • WICHITA, KANSAS 67202
316-262-2691 • FAX 316-262-3003

Designed by	BDB, BLB	Job No.	35-05059-000	SH. 9 of 22
Drawn by	BJS	Date	February 2005	

DSNR: BLB OPER: BJS SCALE: 1=20.00
Q:\2005\05059\000\05059-000-C-STR90-92 06-13-2005 01:42:08 pm