


HAWTHORNE THIRD ADDITION

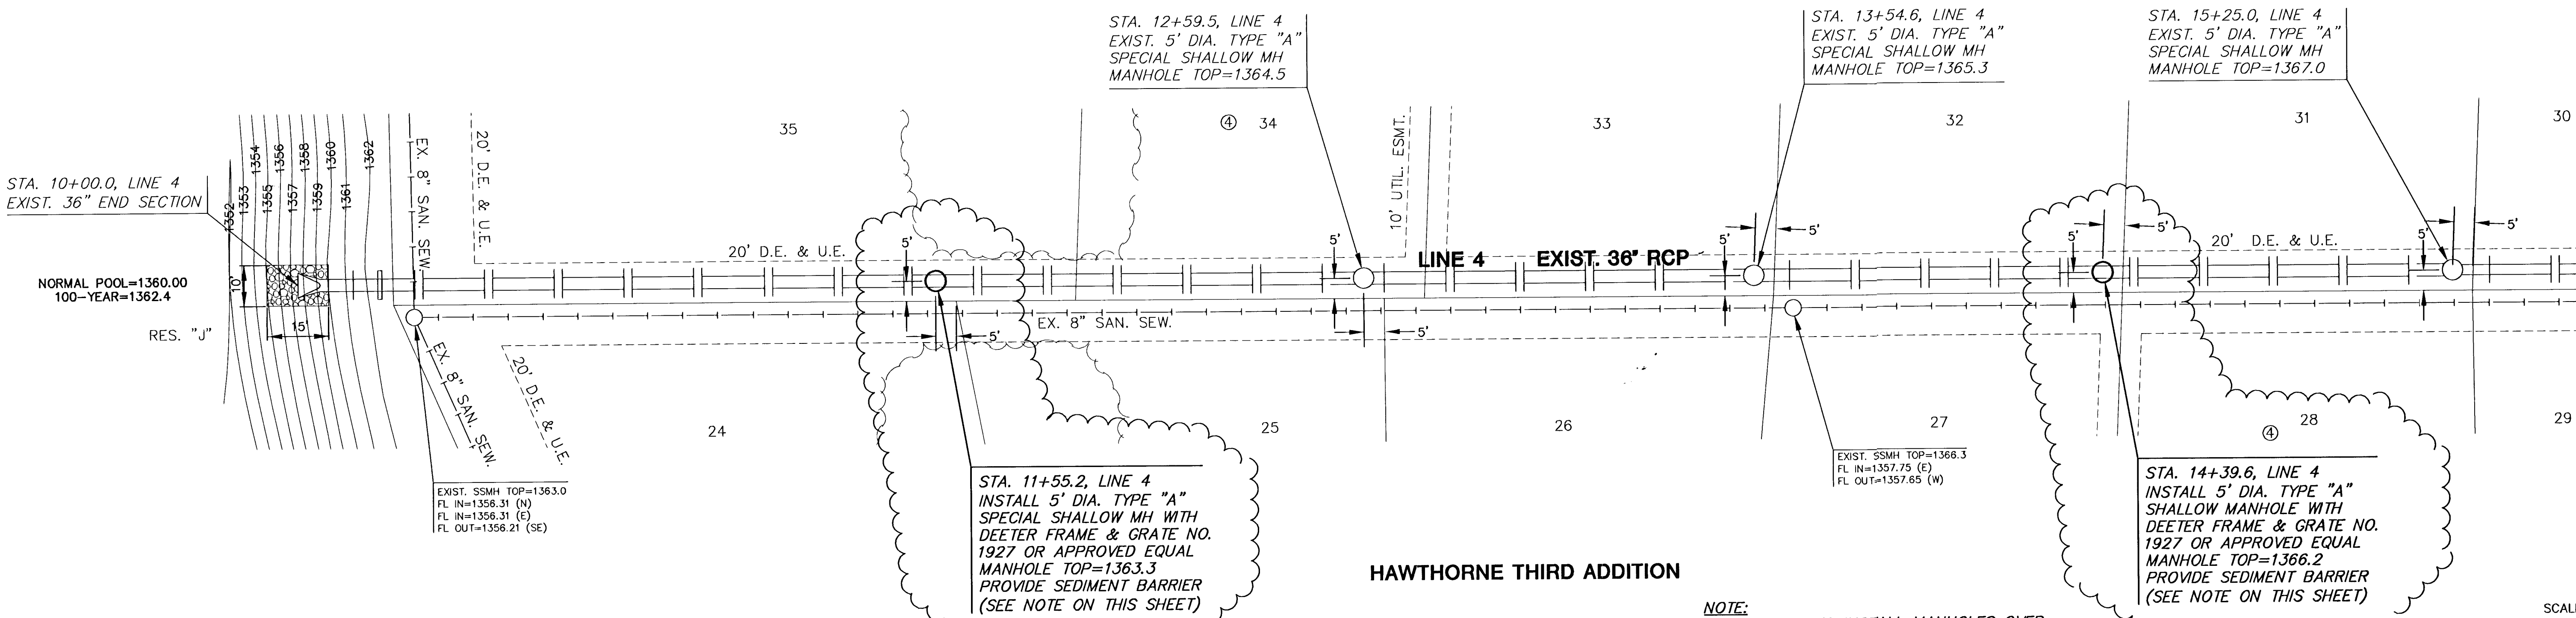

PLAN LINE 4

SCALE: 1"=20'

PROFILE LINE 4

SCALE: HORIZ. 1"=20'
SCALE: VERT. 1"=5'

