


BENCHMARK:

BM #1 : "□" Cut on back of
walk at the South East corner of
lot 1, Woodland Heights 2nd
Addition.



Elev. = 1332.94

Scale: 1" = 40' Horizontal
1" = 5' Vertical
• = Iron

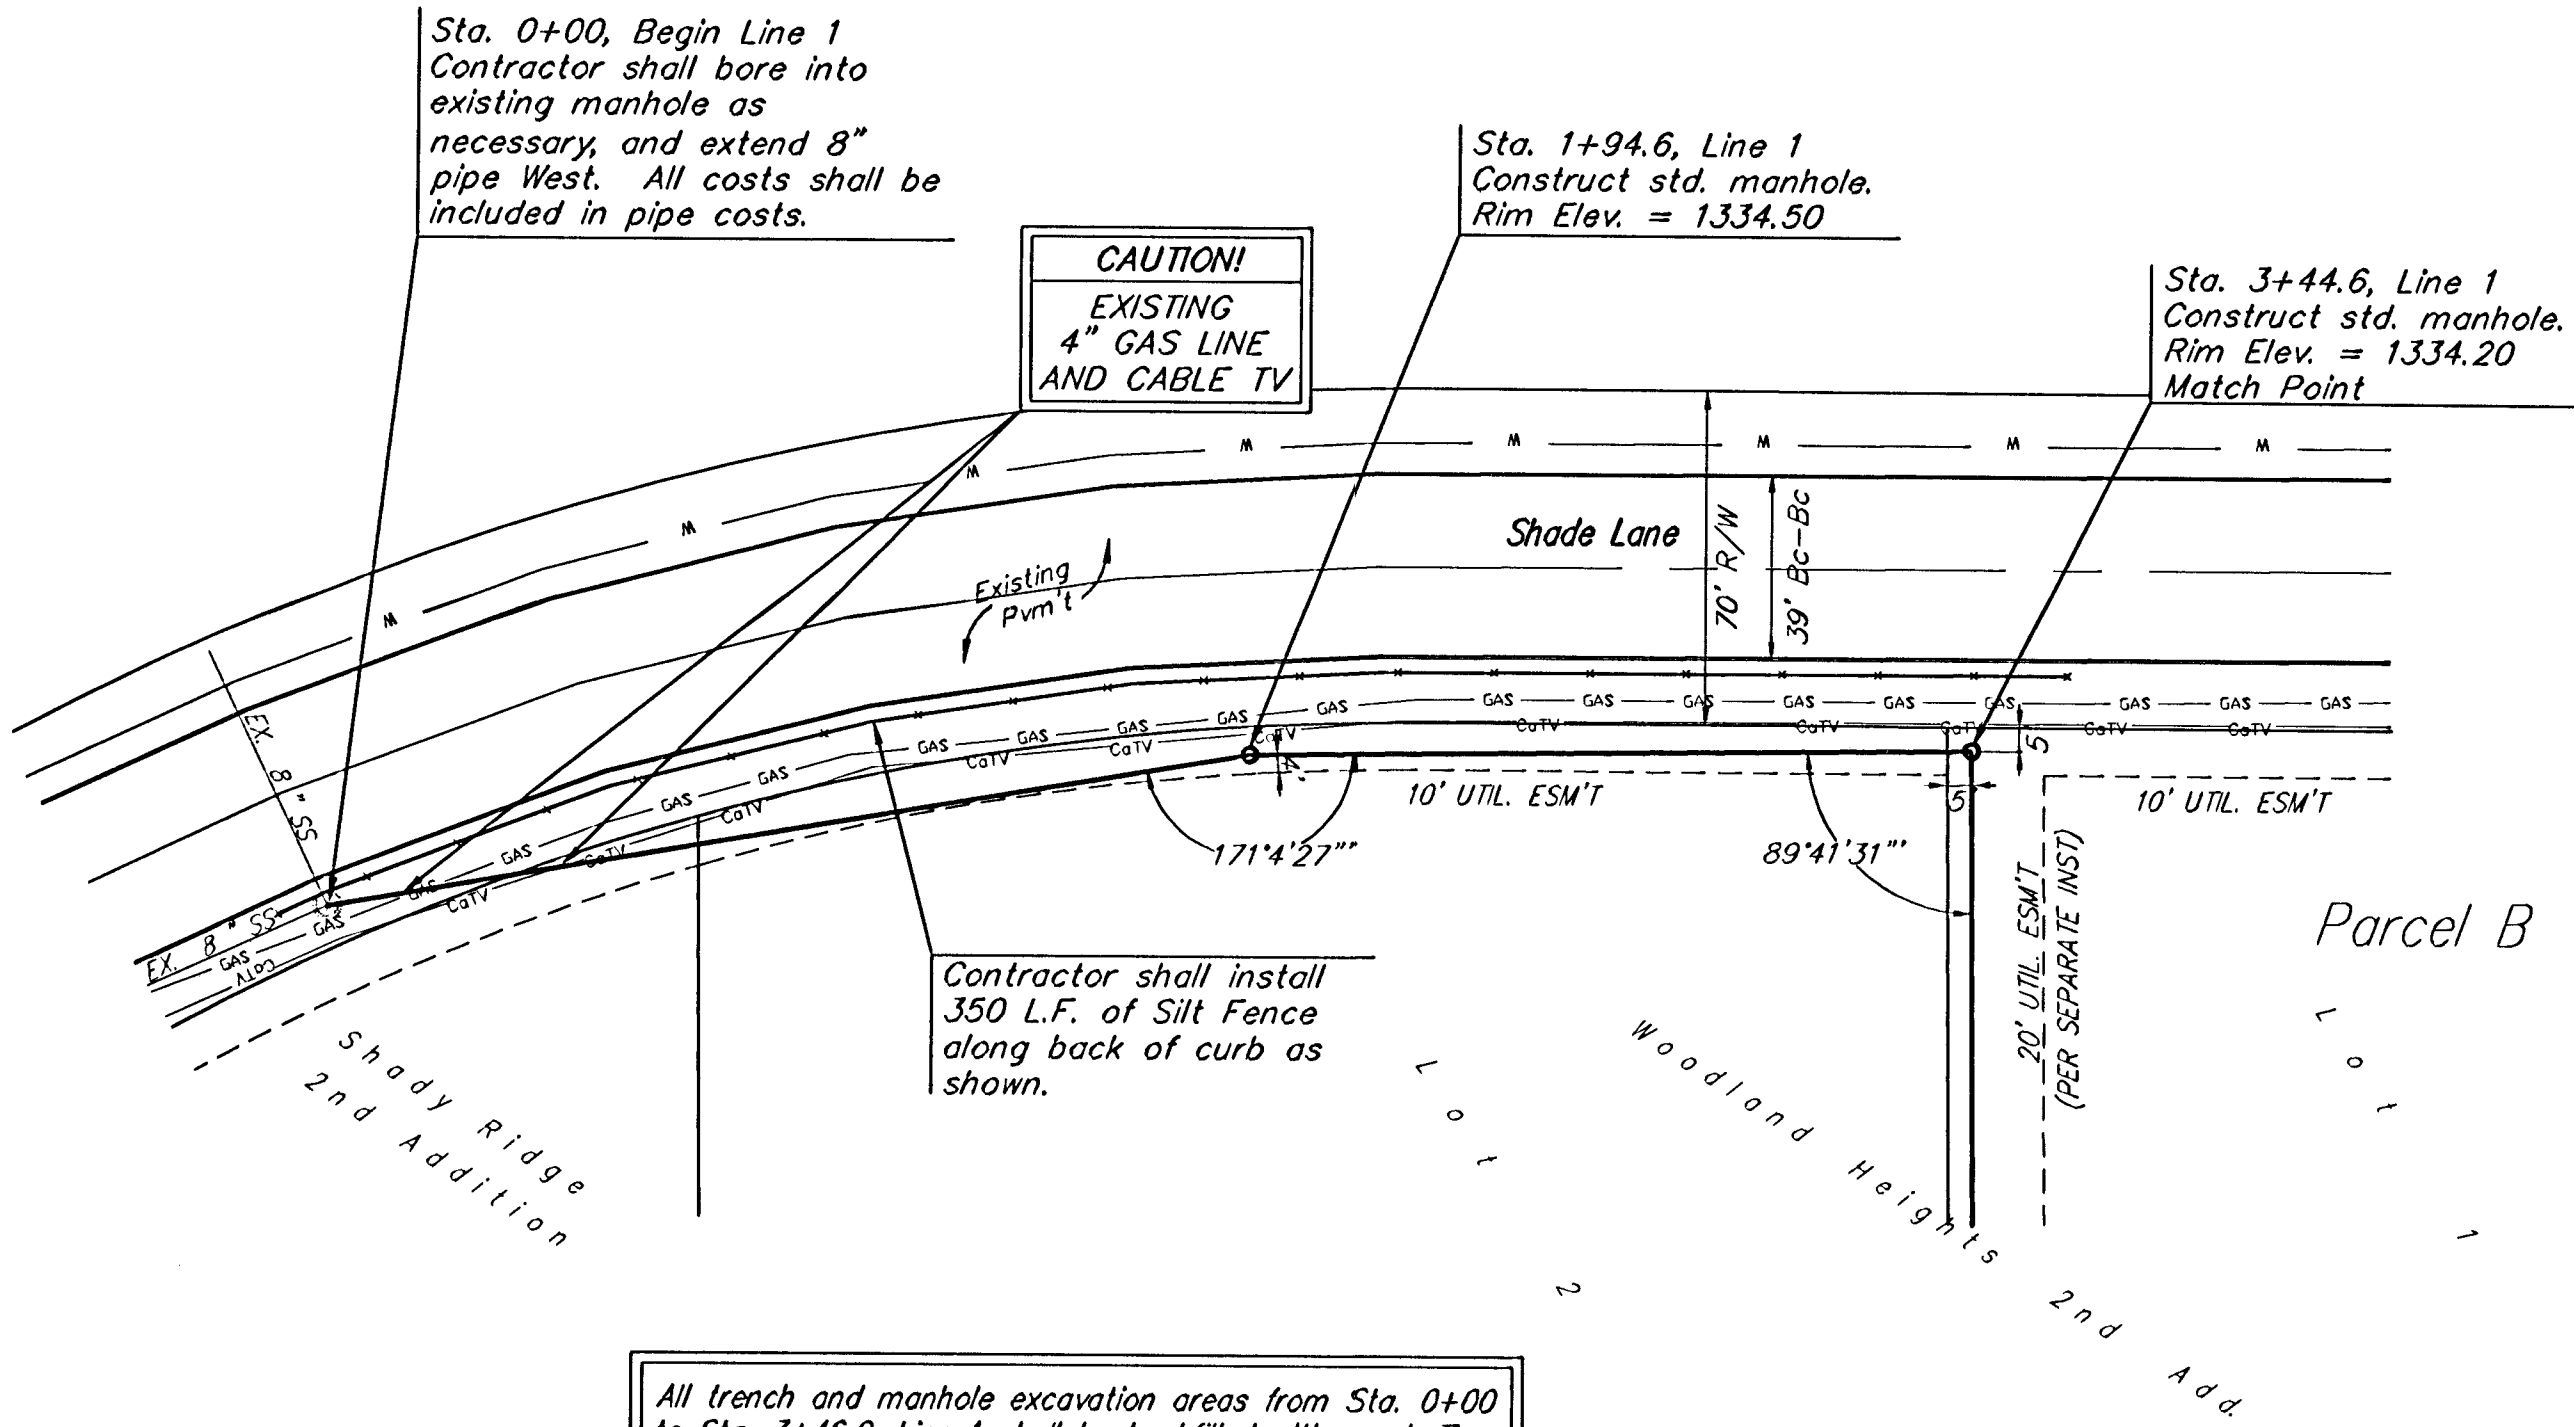

All trench and manhole excavation areas from Sta. 0+00 to Sta. 3+44.6, Line 1 shall be backfilled with sand. The sand backfill shall be within two feet of existing grade and shall be water-jetted and vibrated during backfilling. All costs shall be subsidiary to pipe cost.

Scale: 1" = 40' Horizontal
1" = 5' Vertical
• = Iron

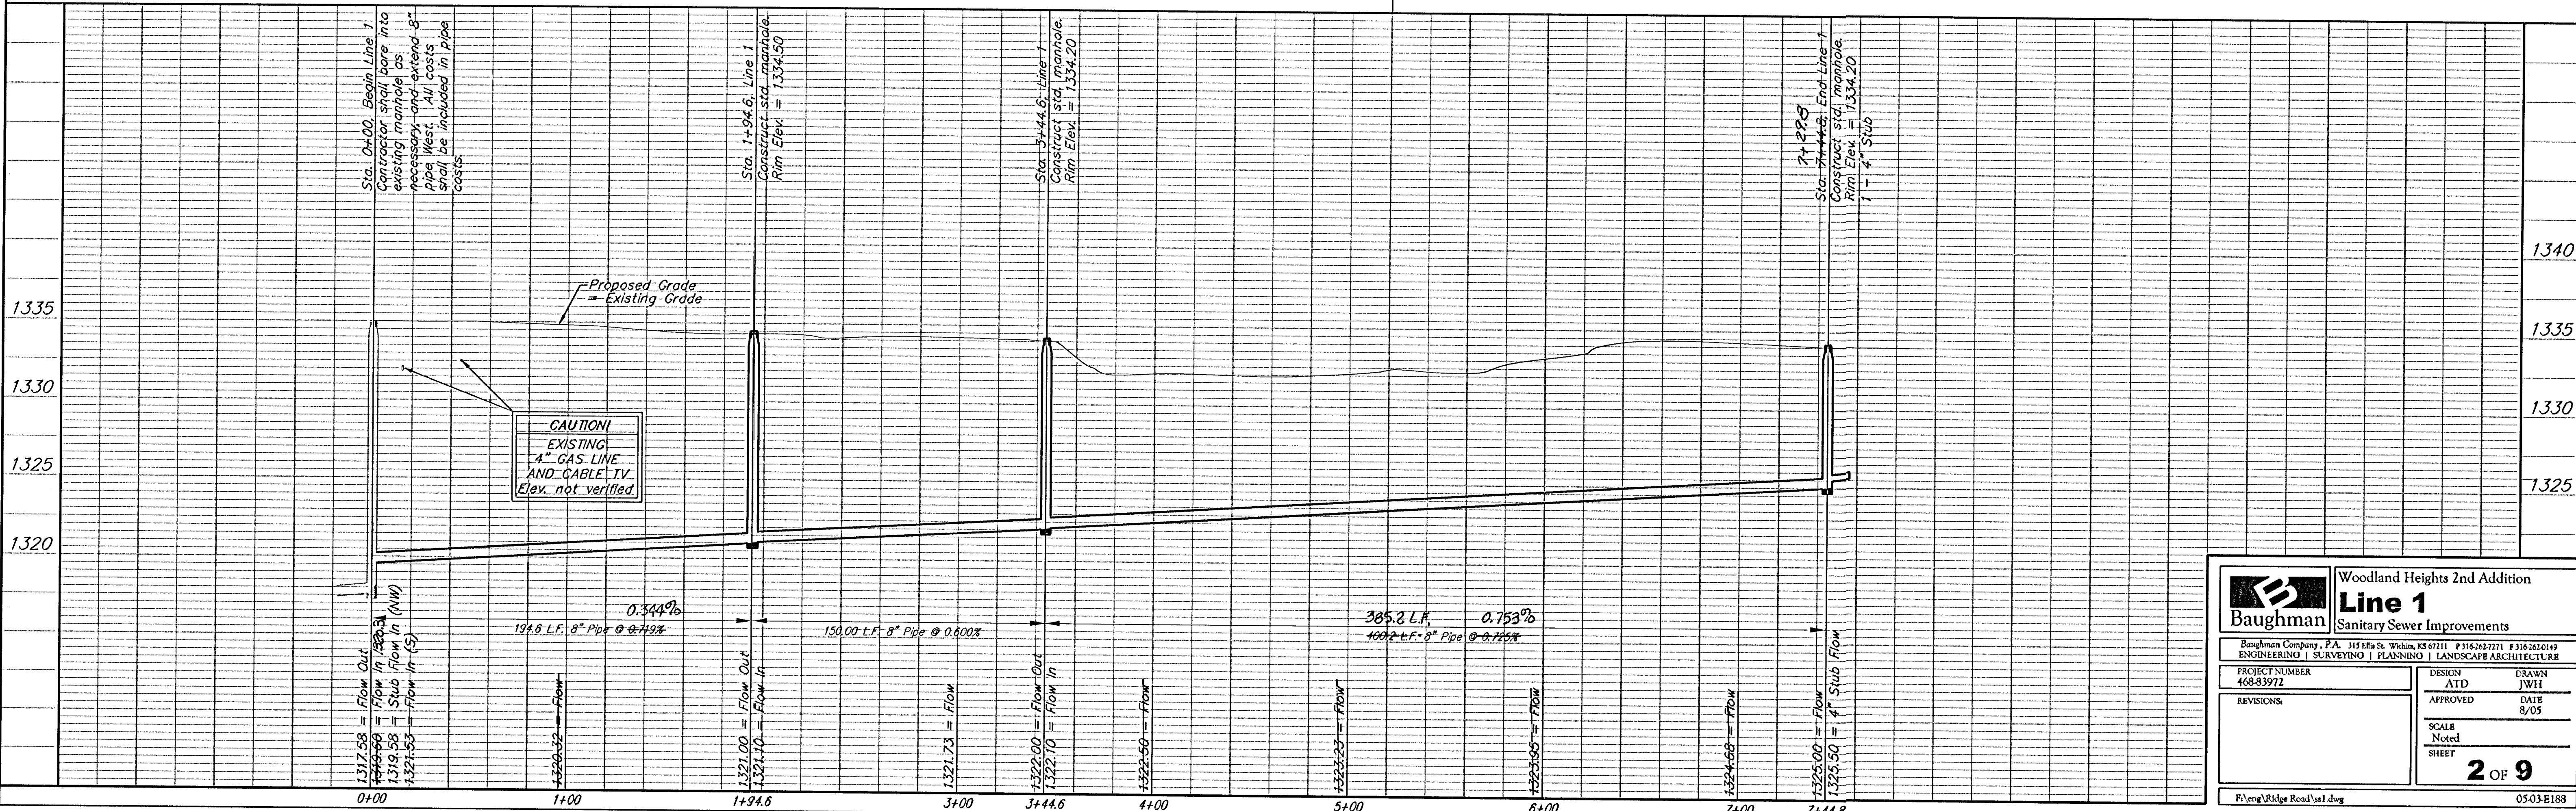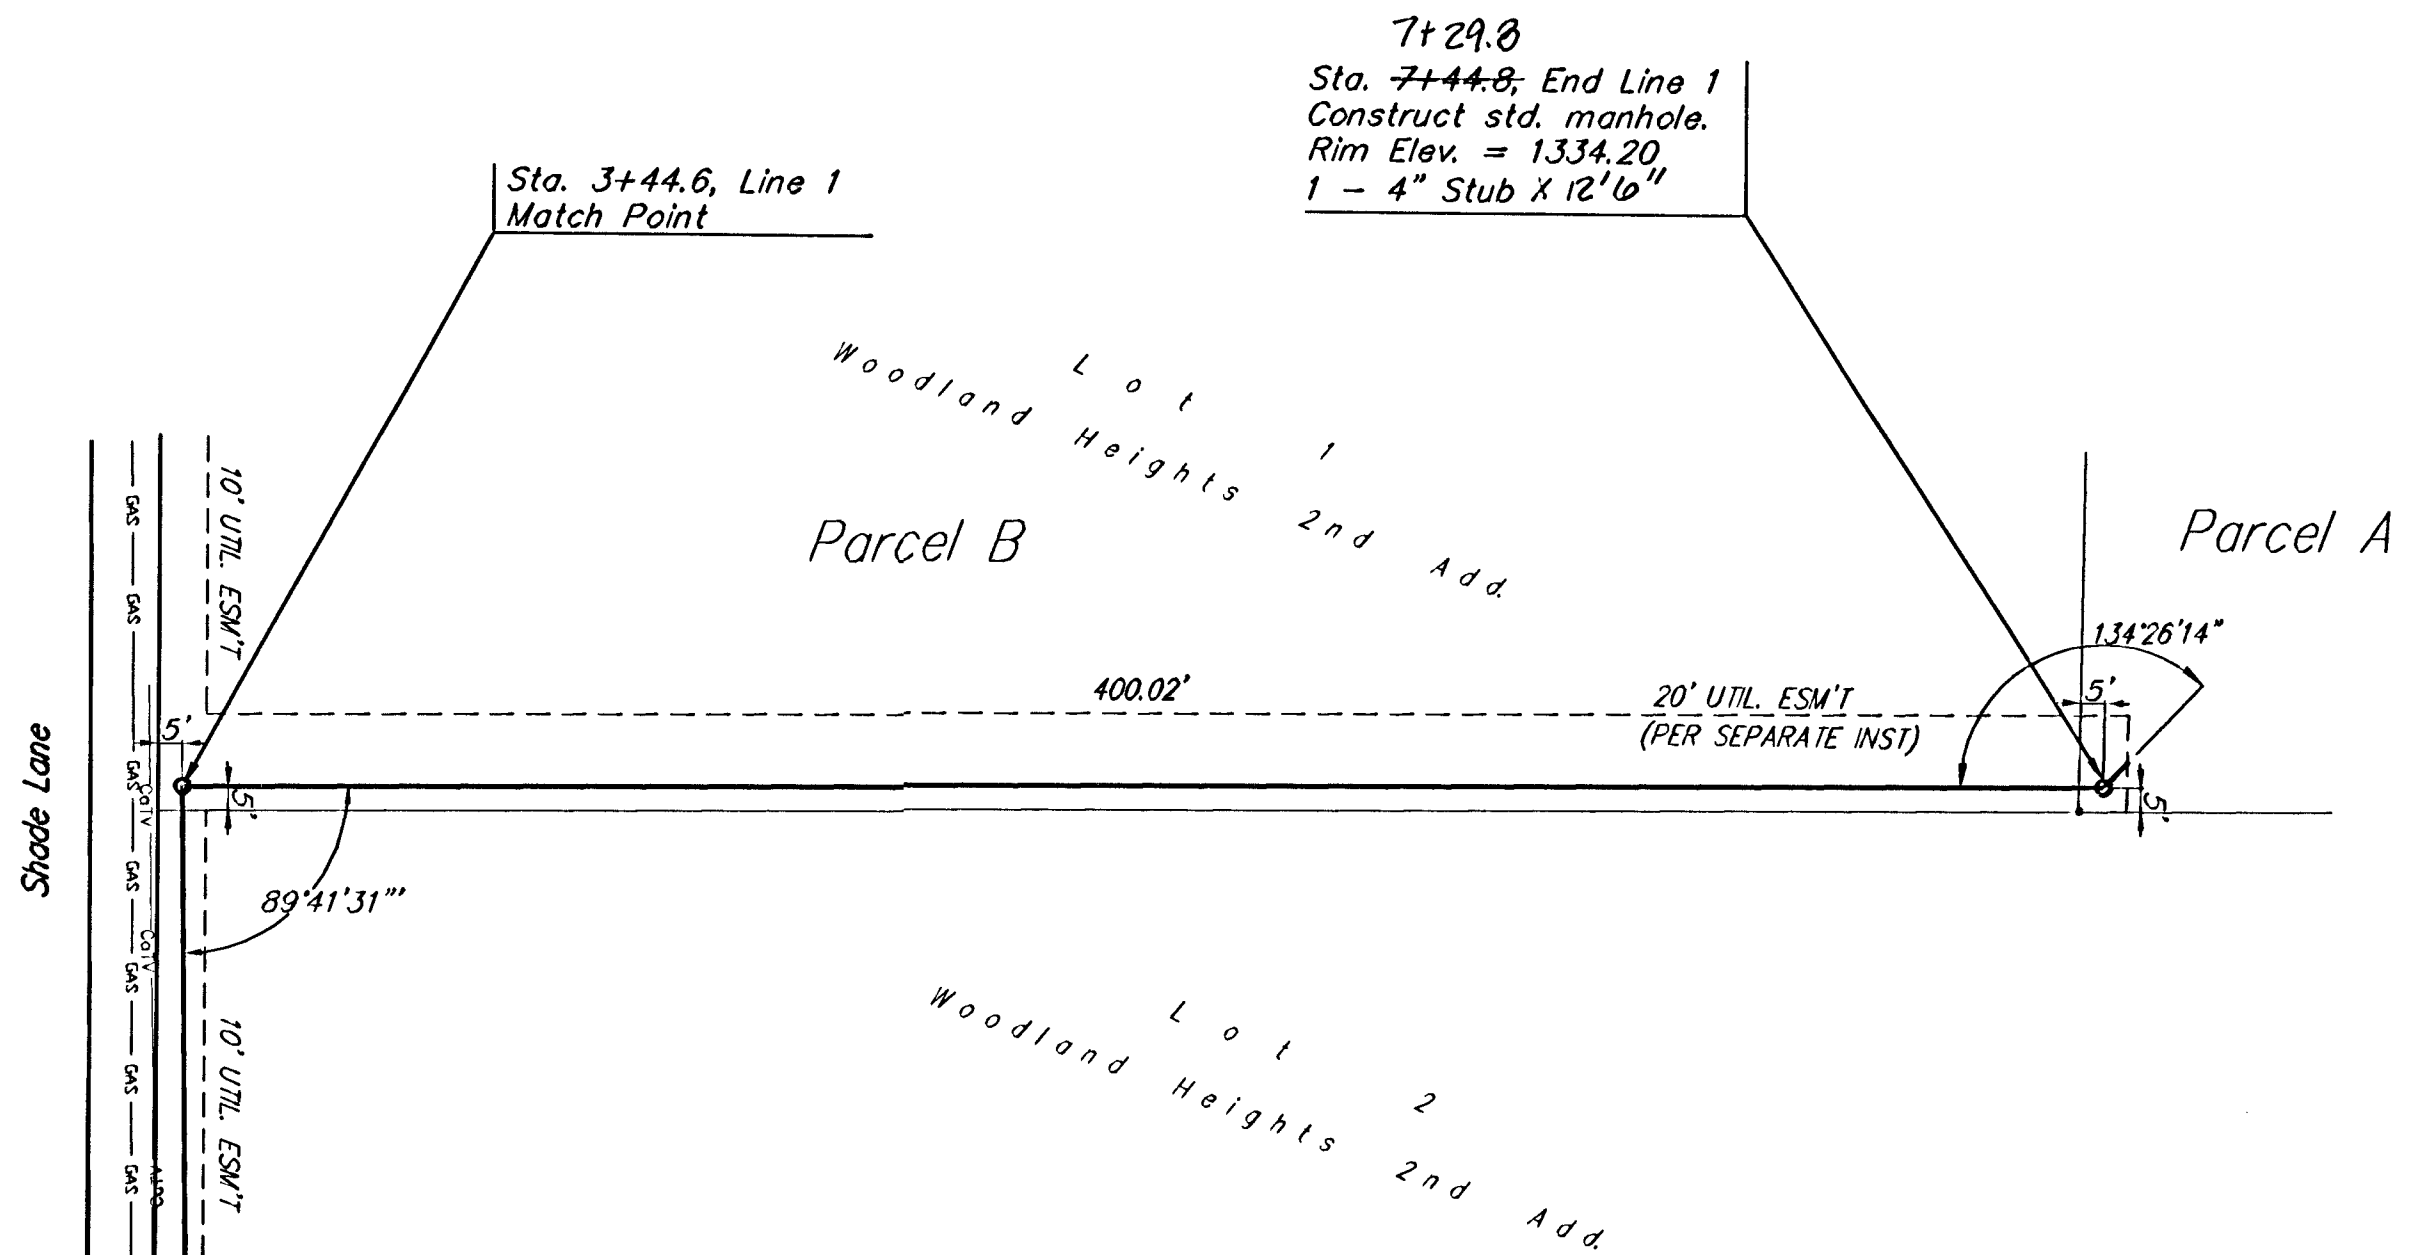

**Baughman**

Woodland Heights 2nd Addition
Line 1
Sanitary Sewer Improvements

ENGINEERING | SURVEYING | PLANNING | LANDSCAPE ARCHITECTURE

PROJECT NUMBER
468-83972

DESIGN
ATD

DRAWN
JWH

REVISIONS:

APPROVED
DATE
8/05

SCALE
Noted
SHEET

2 OF 9

FILENAME: Ridge Road\ss1.dwg

05.03.E188