



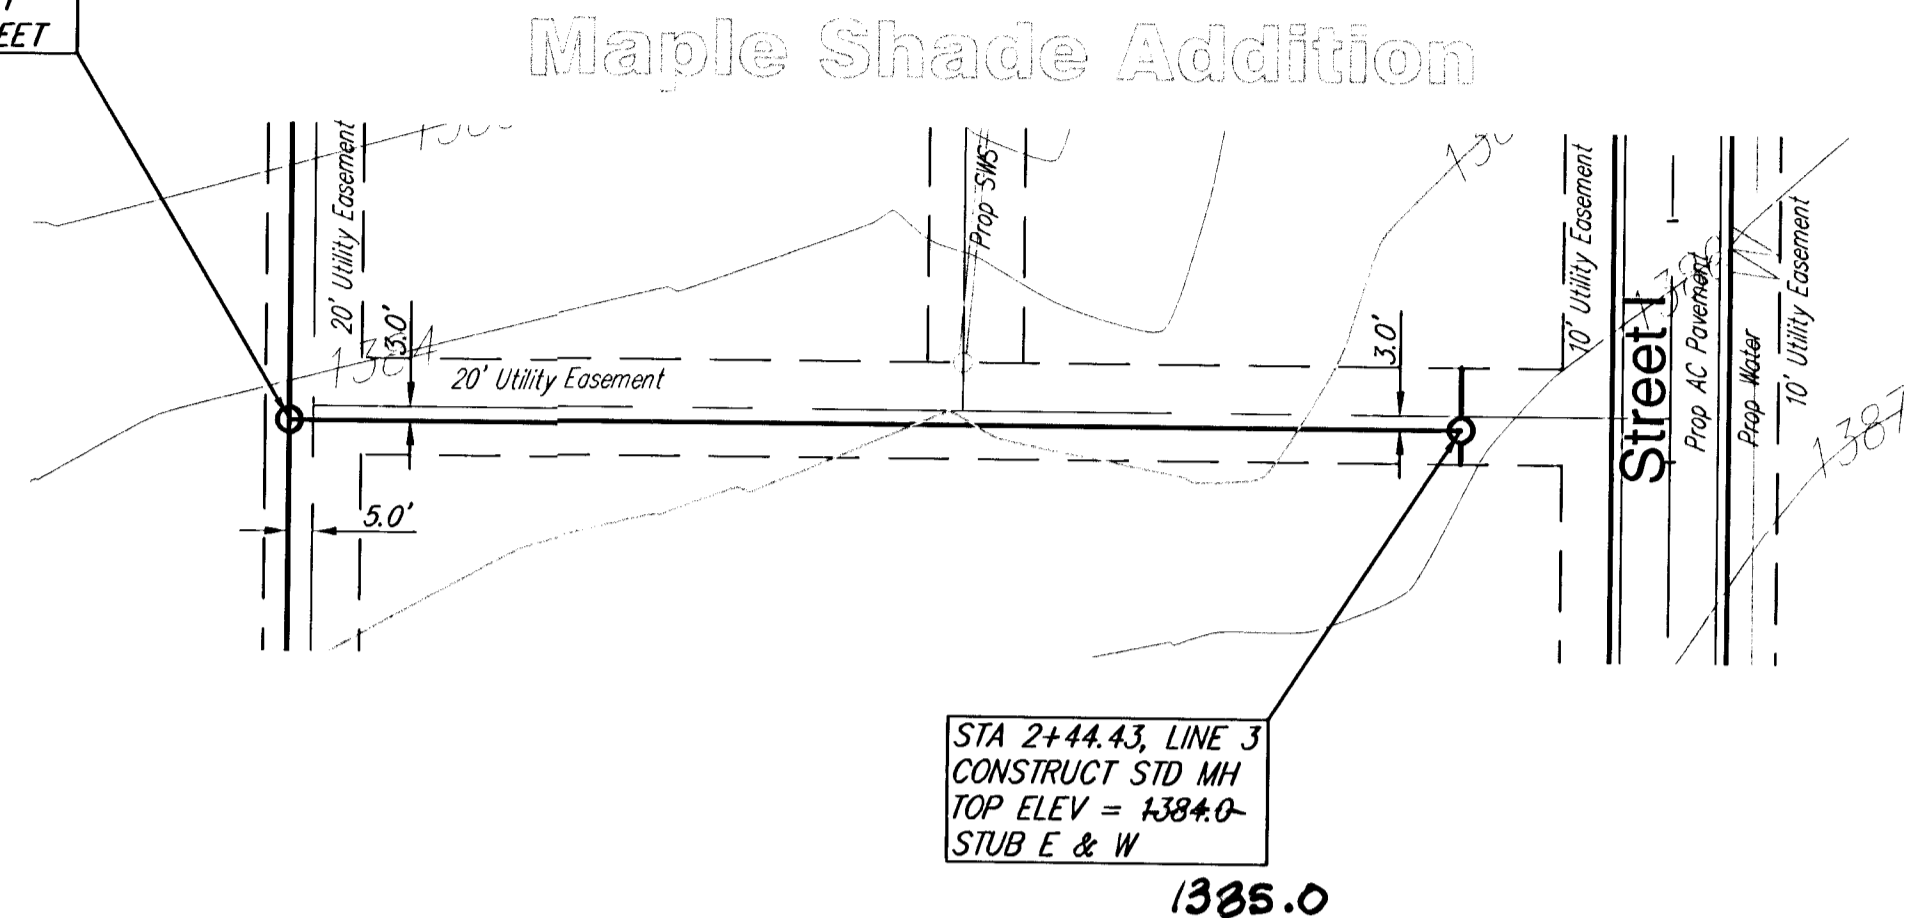

SCALE 1" = 40'
IRON = ●

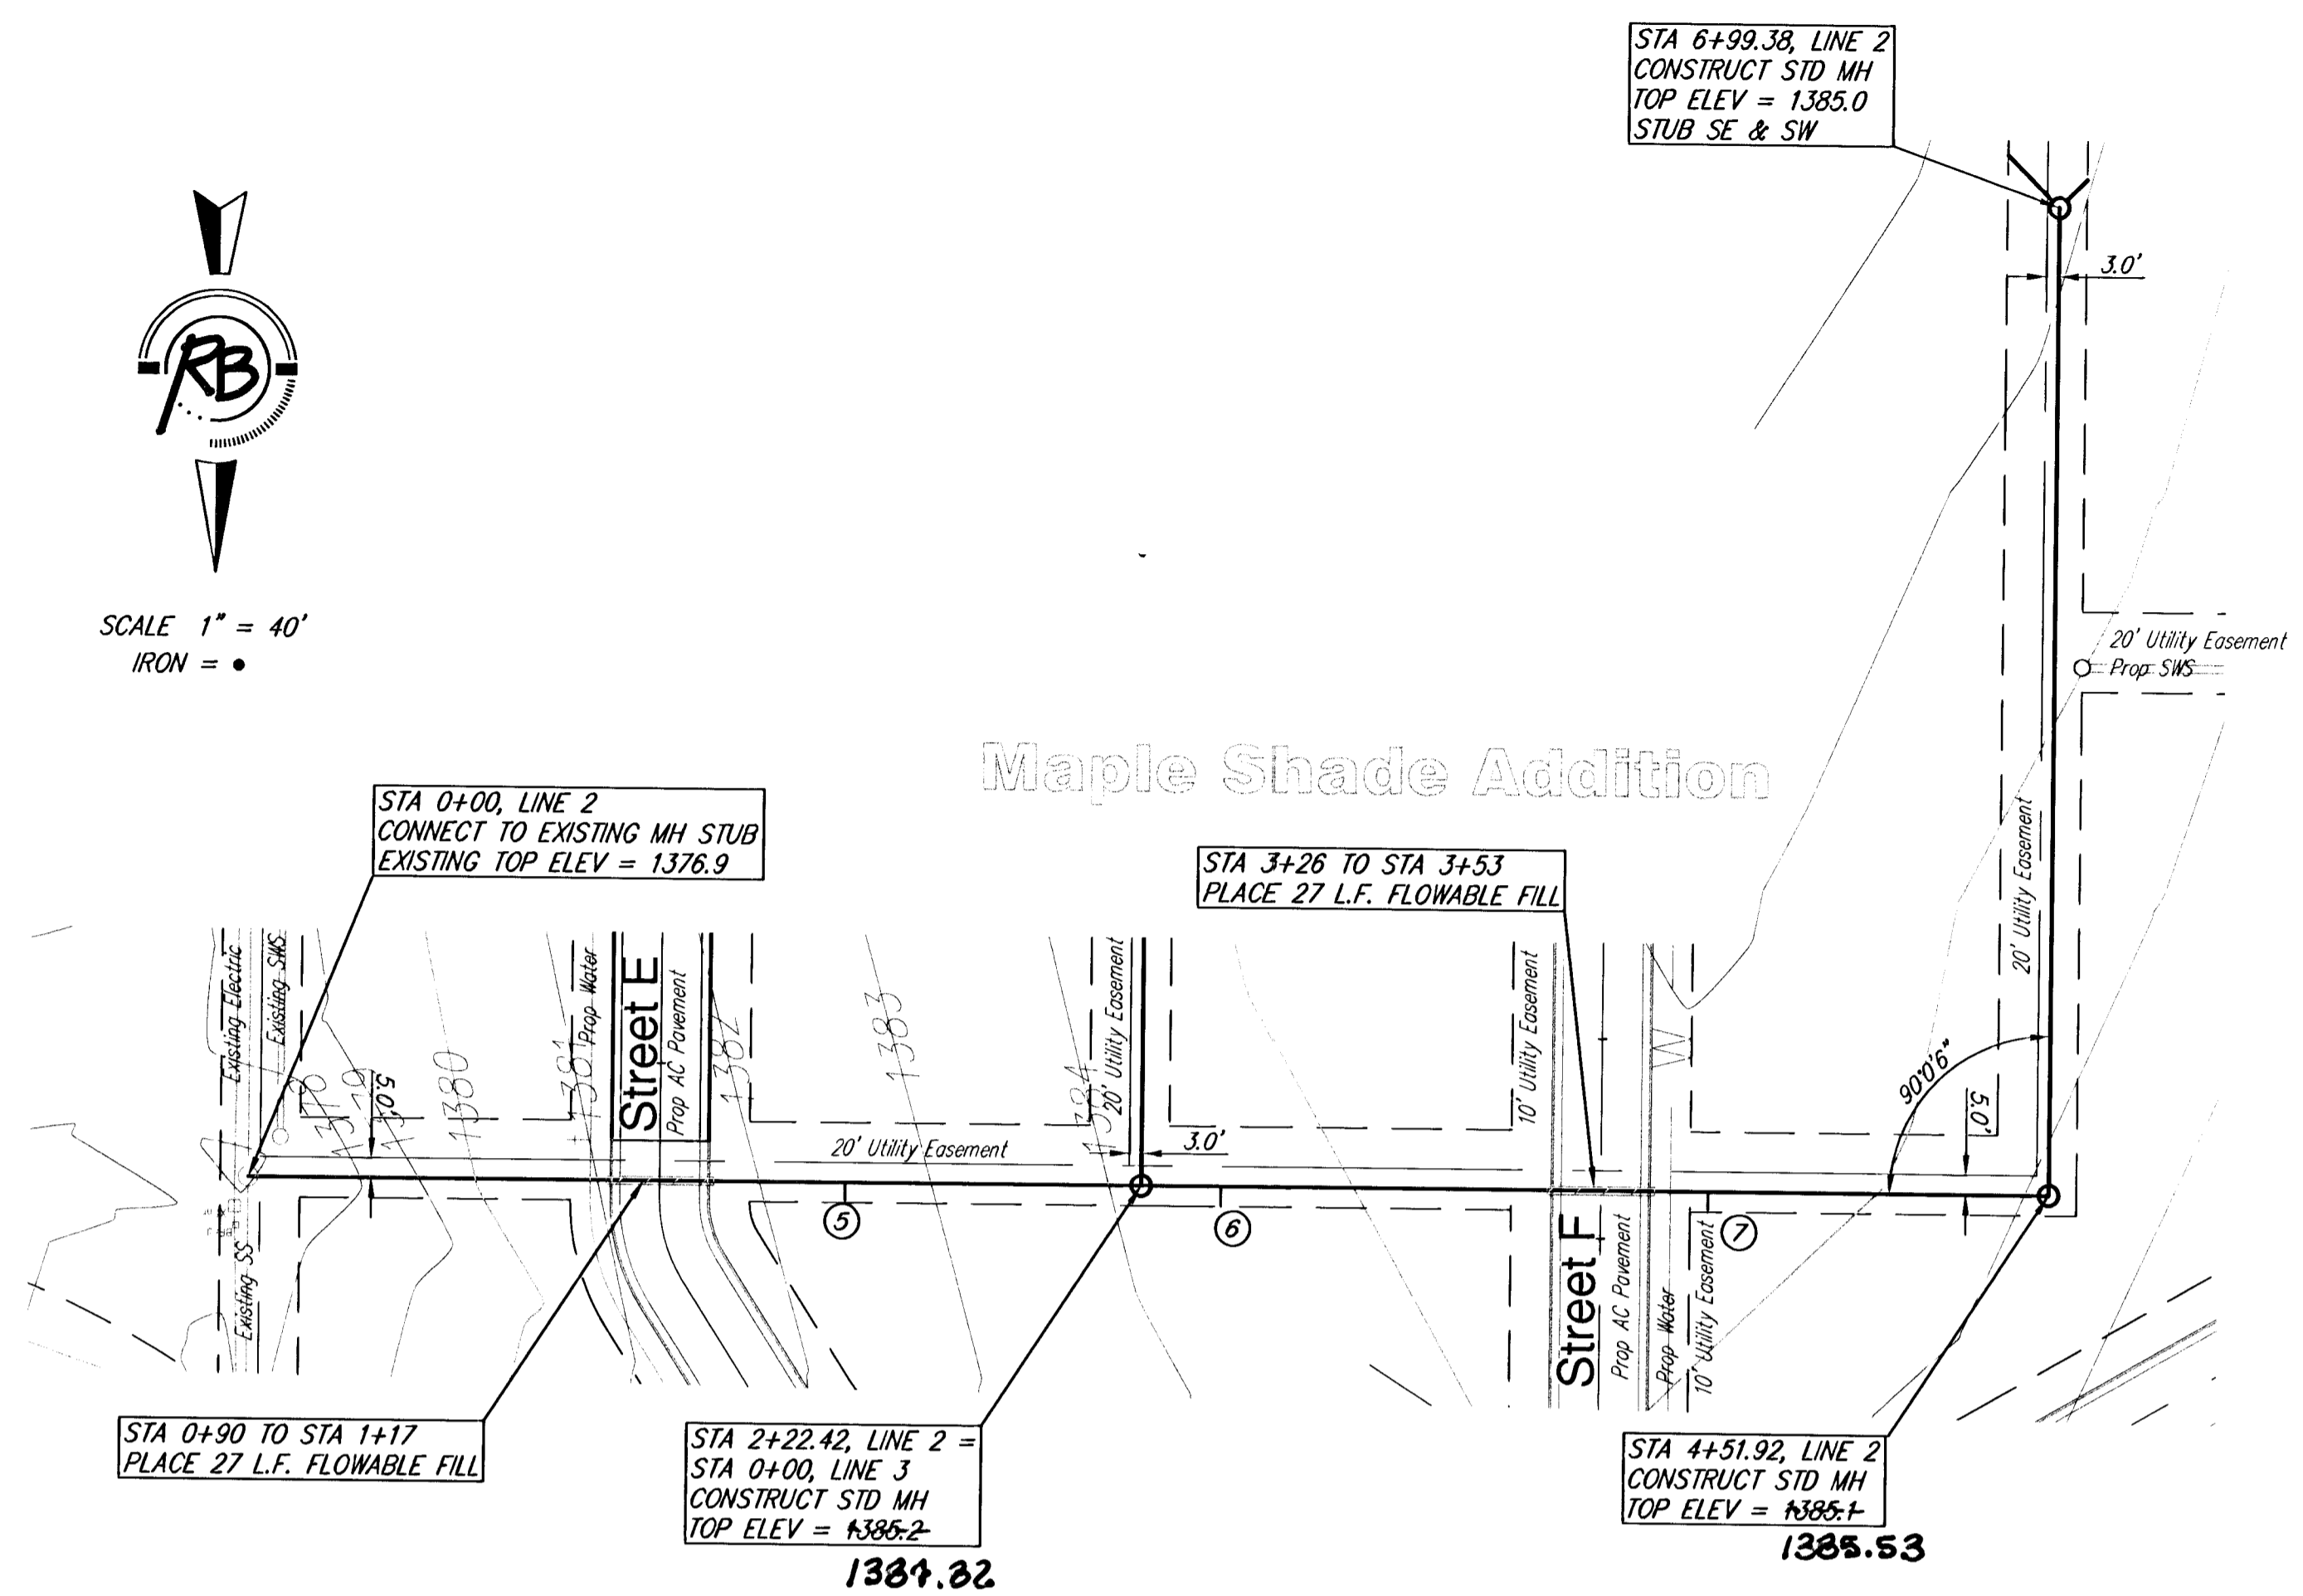


SEWER SERVICE TABLE

NUMBER	TYPE	LOCATION			FOR INFORMATION ONLY	
		HOUSE NO.	BLOCK NO.	LINE NO.	STATION DIRECTION	APPROXIMATE LENGTH 4" PIPE
5	8" X 4" Tee Saddle	251	2	1	1+50.0/RL	VERTICAL: 11.9' HORIZONTAL: 84.7'
6	8" X 4" Tee Saddle	252	2	1	2+45.0/RL	VERTICAL: 9.1' HORIZONTAL: 77.0'
7	8" X 4" Tee Saddle	261	2	1	3+66.0/RL	VERTICAL: 11.8' HORIZONTAL: 5'

NOTE: Vertical Riser Pipe shall be extended to 2' minimum above ground water elevation and 4' maximum below proposed ground elevation.



SCALE 1" = 40'
IRON = ●

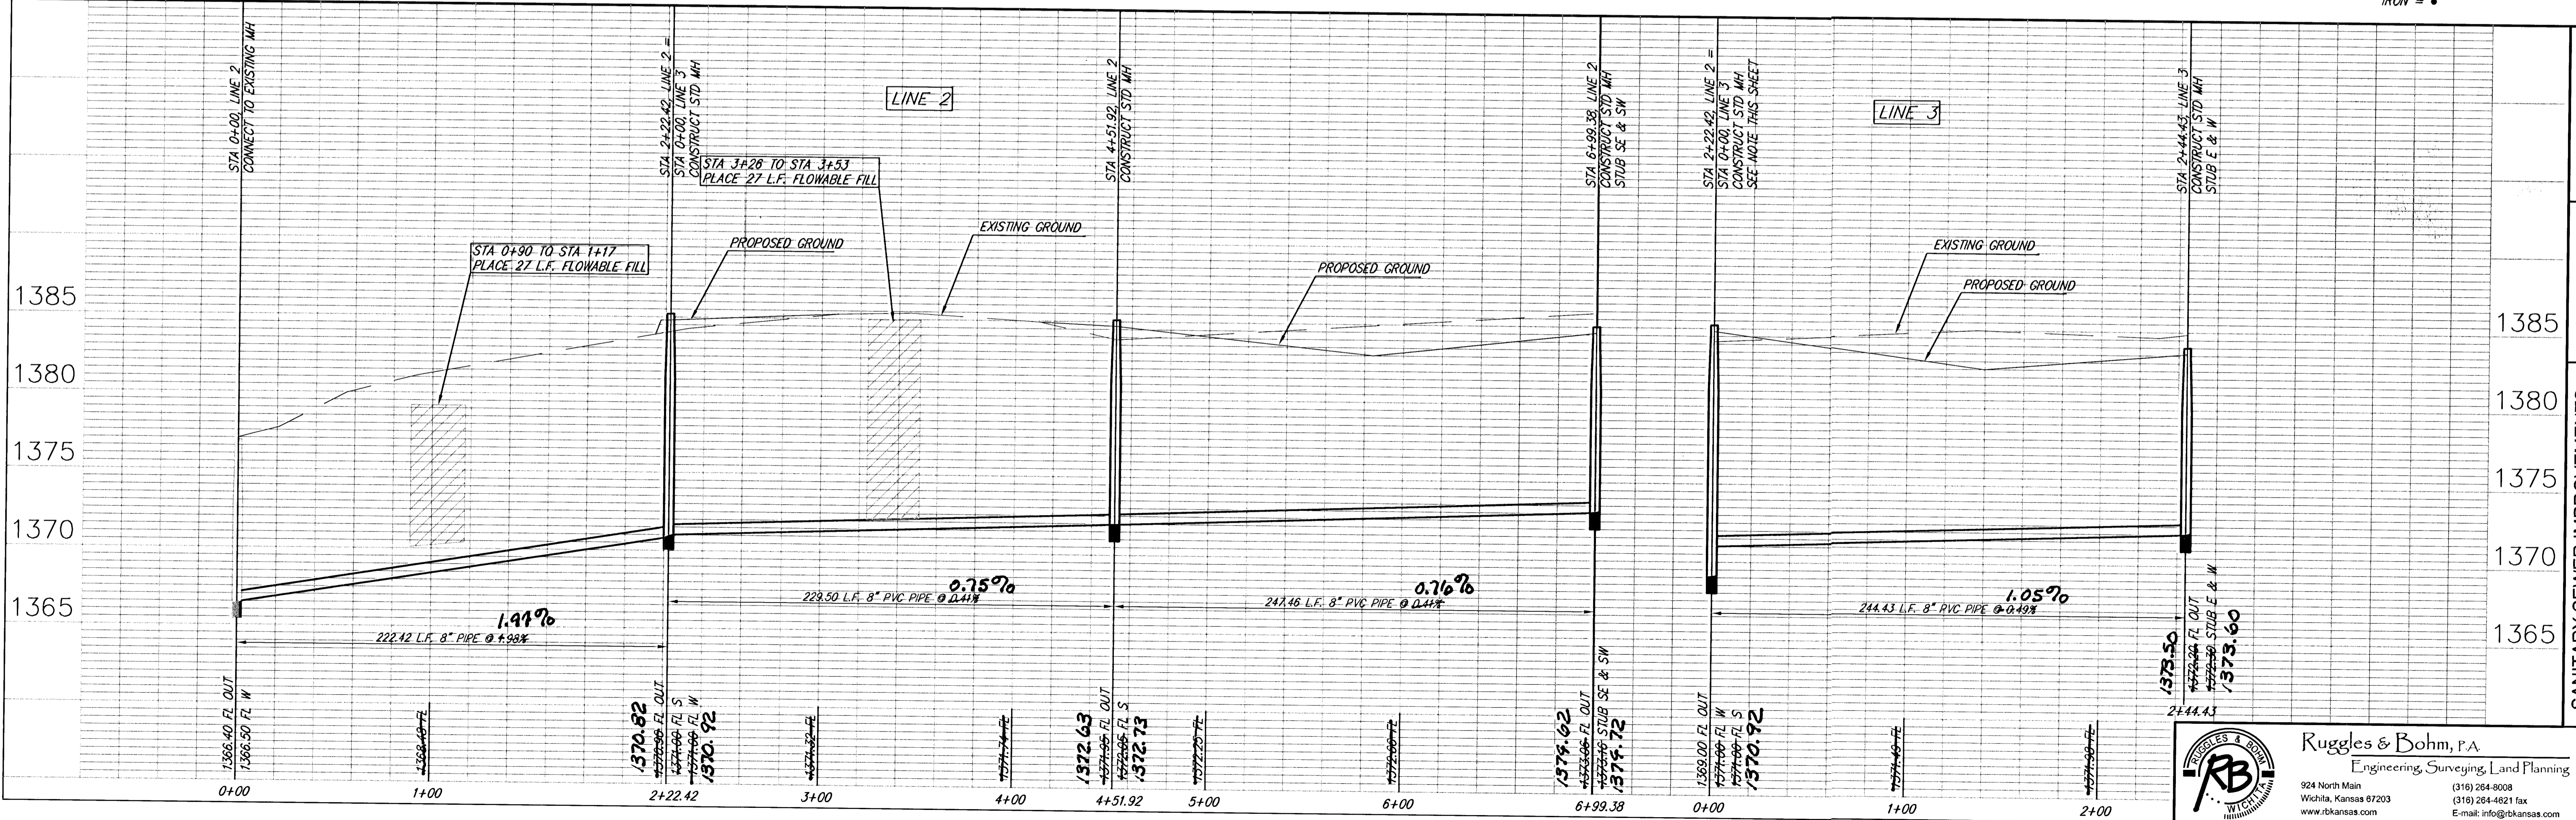

DESIGN	EJC	REVISION	DATE
PROJECT NUMBER	468-83994	DRAWING FILE	Sanitary Sewer [LINE 1]
SANITARY SEWER IMPROVEMENTS		WICHITA, KANSAS	
LINE 1		WICHITA, KANSAS	

Ruggles & Bohm, P.A.
Engineering, Surveying, Land Planning
924 North Main
Wichita, Kansas 67203
www.rbkansas.com
(316) 264-8008
(316) 264-4621 fax
E-mail: info@rbkansas.com

RB JOB
2401X
SHEET
3
0 3